


1 CULVERT LAYOUT PLAN VIEW  
 S1.0 3/16" = 1'-0"

QTY	
156	5 TON UT
22	RL-24 8 T
42	1-8NC DO
880LF	1" CLOSE
1 GAL	RED ADH
6 GAL	VEXCON
14	1/2" MILD
4	1/2" MILD
2	1/2" MILD
2	1/2" MILD
600LF	24" ROYS
6 GAL	ROYBON
64	7/8"x18" C
256	1" X 1 1/2"
128	7/8" GALV
88	1" X 5" NC
88	1" DIA NU

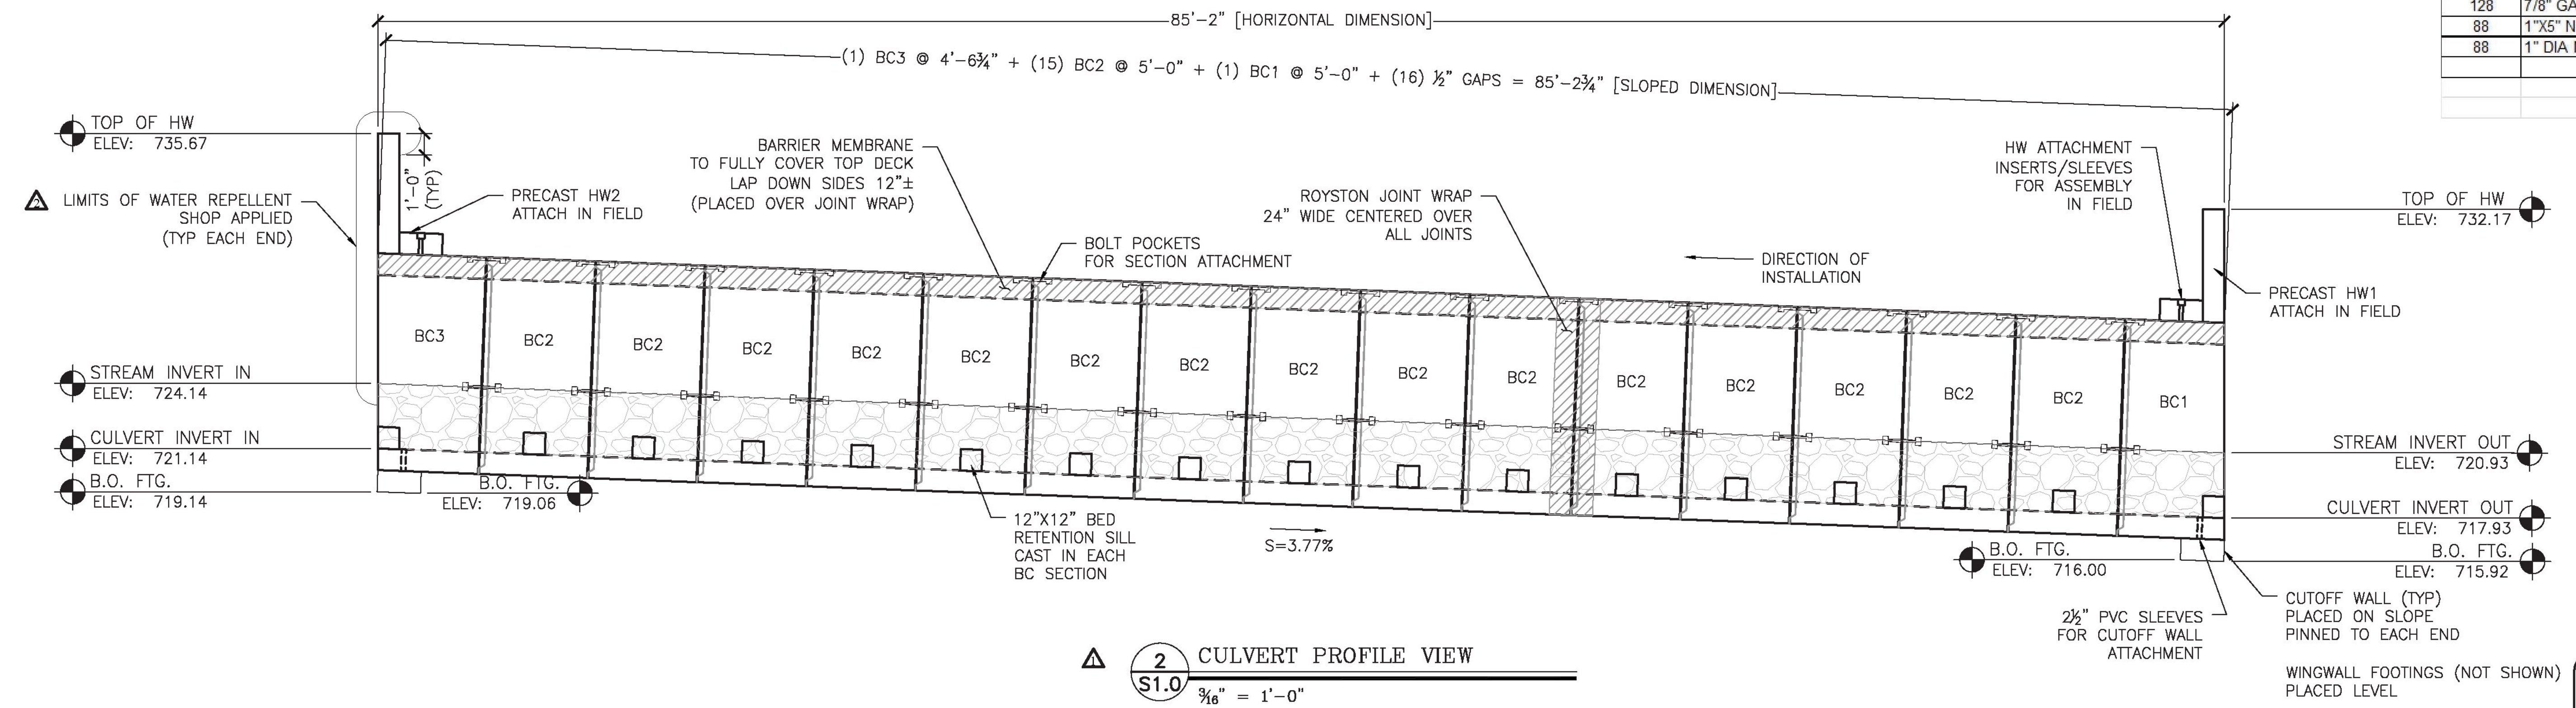

2 CULVERT PROFILE VIEW  
 S1.0 3/16" = 1'-0"