

N/F
CARL CAPELLA, T. & POST,
K.A. & ALLARD, D.

N/F
DONALD & MARGARET CAMPBELL


N/F
TOWN OF BENNINGTON

N/F
CAMPBELL DUNCAN TRUST

LEGEND	
SYMBOL	DESCRIPTION
	PROPOSED RIPRAP
	AREA OF STONE PLACEMENT (SEE NOTE 1)

NOTE:

1. THE CONTRACTOR SHALL BE RESPONSIBLE FOR THE REMOVAL AND STORAGE OF THE EXISTING LARGE STONES ALONG THE WESTERN BANK OF THE ROARING BRANCH. THESE STONES REQUIRE REMOVAL TO CONSTRUCT THE TEMPORARY ACCESS ROAD FOR STAGE 2 CONSTRUCTION. UPON COMPLETION OF STAGE 2 CONSTRUCTION, THE CONTRACTOR SHALL BE RESPONSIBLE FOR REPLACING THE EXISTING LARGE STONES IN THEIR ORIGINAL LOCATION. THE COST OF THIS WORK SHALL BE INCIDENTAL TO OTHER CONTRACT ITEMS.

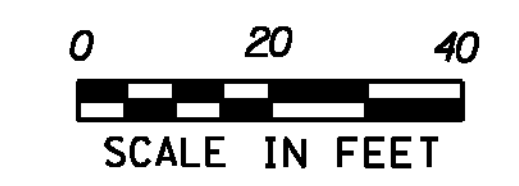

EROSION CONTROL FINAL CONDITION SHEET	PROJECT NAME: BENNINGTON	PLOT DATE: 8/21/2012
	PROJECT NUMBER: ER BHF 010-I(45)	DRAWN BY: M.E.D.
	FILE NAME: z1lb326_fcp.dgn	CHECKED BY: D.E.G.
	PROJECT LEADER: D.E.G.	SHEET 13 OF 40
	DESIGNED BY: B.T.H.	
	DWG. NO.: z1lb326.fc1	

FILE NAME: V:\Projects\2012\23770\CADD\MSTN\z1lb326_fcp.dgn
 DATE/TIME: 8/21/2012 10:46:46 AM
 USER: d4866