
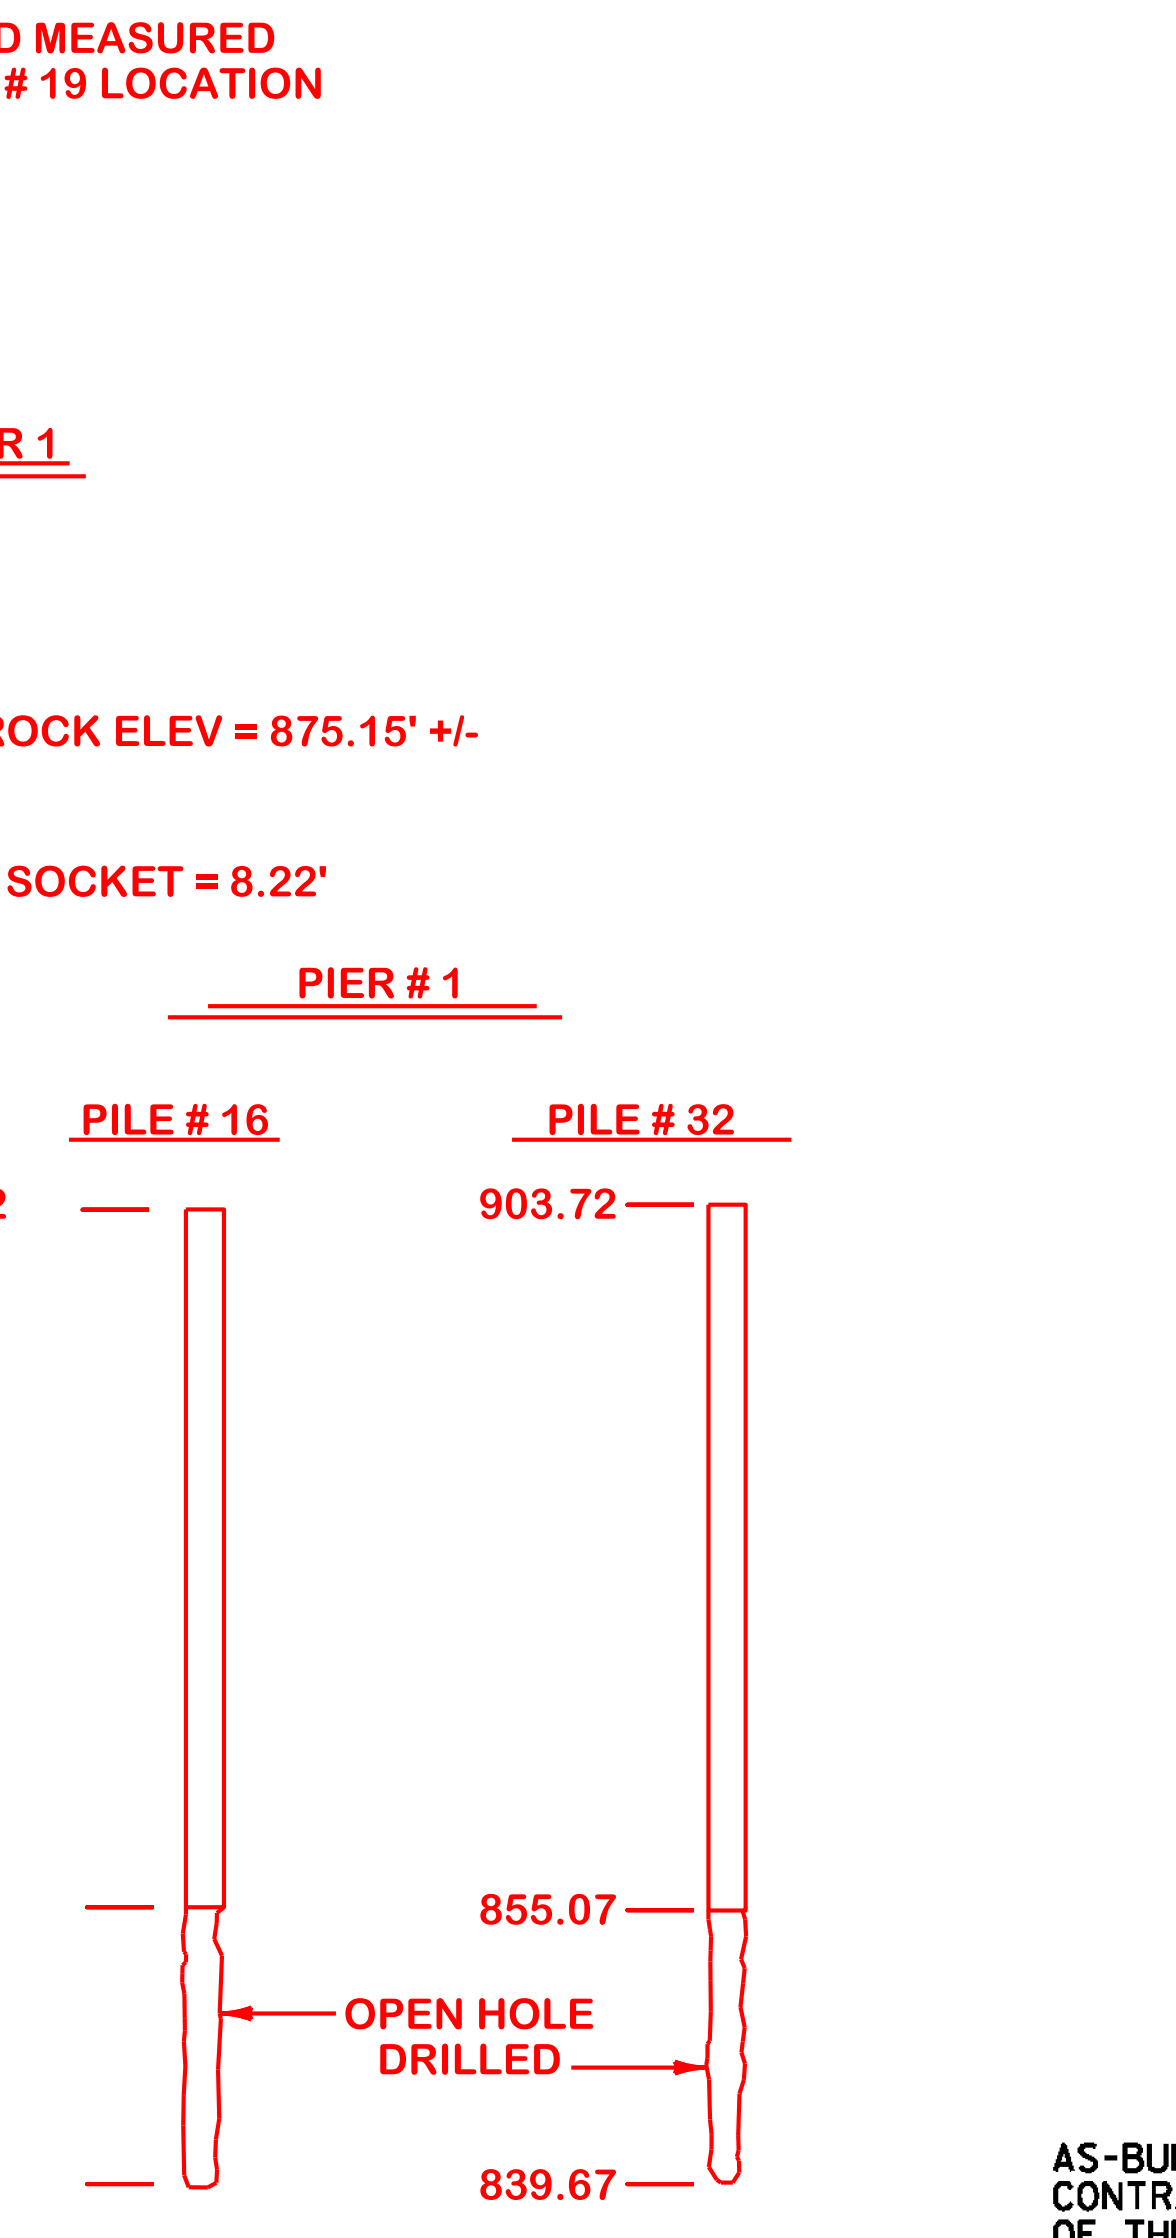


| AS-BUILT MICROPILE DATA | | | | | |
|-------------------------|-----------|-------------------|----------|-----------|-------------------|
| PIER 1 | | | PIER 2 | | |
| PILE NO. | TIP ELEV. | CASED LENGTH (FT) | PILE NO. | TIP ELEV. | CASED LENGTH (FT) |
| 1 | 854.37 | 38.75 | 1 | 849.33 | 40.00 |
| 2 | 854.82 | 40.00 | 2 | 849.33 | 40.00 |
| 3 | 855.00 | 40.00 | 3 | 848.80 | 40.00 |
| 4 | 855.61 | 40.00 | 4 | 848.78 | 40.00 |
| 5 | 855.21 | 40.00 | 5 | 848.56 | 40.00 |
| 6 | 855.00 | 40.00 | 6 | 848.60 | 40.00 |
| 7 | 855.65 | 40.00 | 7 | 848.24 | 40.00 |
| 8 | 854.95 | 40.00 | 8 | 848.60 | 40.00 |
| 9 | 855.23 | 40.00 | 9 | 848.32 | 40.00 |
| 10 | 855.61 | 40.00 | 10 | 848.31 | 40.00 |
| 11 | 855.22 | 40.00 | 11 | 849.06 | 40.00 |
| 12 | 855.10 | 40.00 | 12 | 848.71 | 40.00 |
| 13 | 856.17 | 40.00 | 13 | 848.53 | 40.00 |
| 14 | 855.55 | 40.00 | 14 | 848.57 | 40.00 |
| 15 | 855.29 | 40.00 | 15 | 848.43 | 40.00 |
| 16 | 839.66 | 48.66 | 16 | 848.98 | 40.00 |
| 17 | 855.61 | 40.00 | 17 | 849.06 | 38.75 |
| 18 | 857.14 | 40.00 | 18 | 848.25 | 40.00 |
| 19 | 855.02 | 40.00 | 19 | 849.06 | 38.75 |
| 20 | 855.37 | 40.00 | 20 | 848.34 | 40.00 |
| 21 | 855.26 | 40.00 | 21 | 848.74 | 40.00 |
| 22 | 857.54 | 40.00 | 22 | 849.75 | 40.00 |
| 23 | 854.48 | 40.00 | 23 | 848.41 | 40.00 |
| 24 | 855.70 | 40.00 | 24 | 848.84 | 40.00 |
| 25 | 854.60 | 40.00 | 25 | 848.31 | 40.00 |
| 26 | 854.43 | 40.00 | 26 | 848.54 | 40.00 |
| 27 | 855.39 | 40.00 | 27 | 864.81 | 40.00 |
| 28 | 855.47 | 40.00 | 28 | 848.33 | 40.00 |
| 29 | 855.35 | 40.00 | 29 | 848.13 | 40.00 |
| 30 | 855.33 | 40.00 | 30 | 848.29 | 40.00 |
| 31 | 854.33 | 40.00 | 31 | 848.56 | 40.00 |
| 32 | 839.67 | 48.00 | 32 | 848.22 | 40.00 |
| 33 | 855.60 | 40.00 | 33 | 848.50 | 40.00 |
| 34 | 855.43 | 40.00 | 34 | 848.56 | 40.00 |
| 35 | 854.83 | 40.00 | 35 | 848.16 | 40.00 |
| 36 | 855.72 | 40.00 | 36 | 848.17 | 40.00 |
| 37 | 855.11 | 40.00 | 37 | 848.97 | 40.00 |

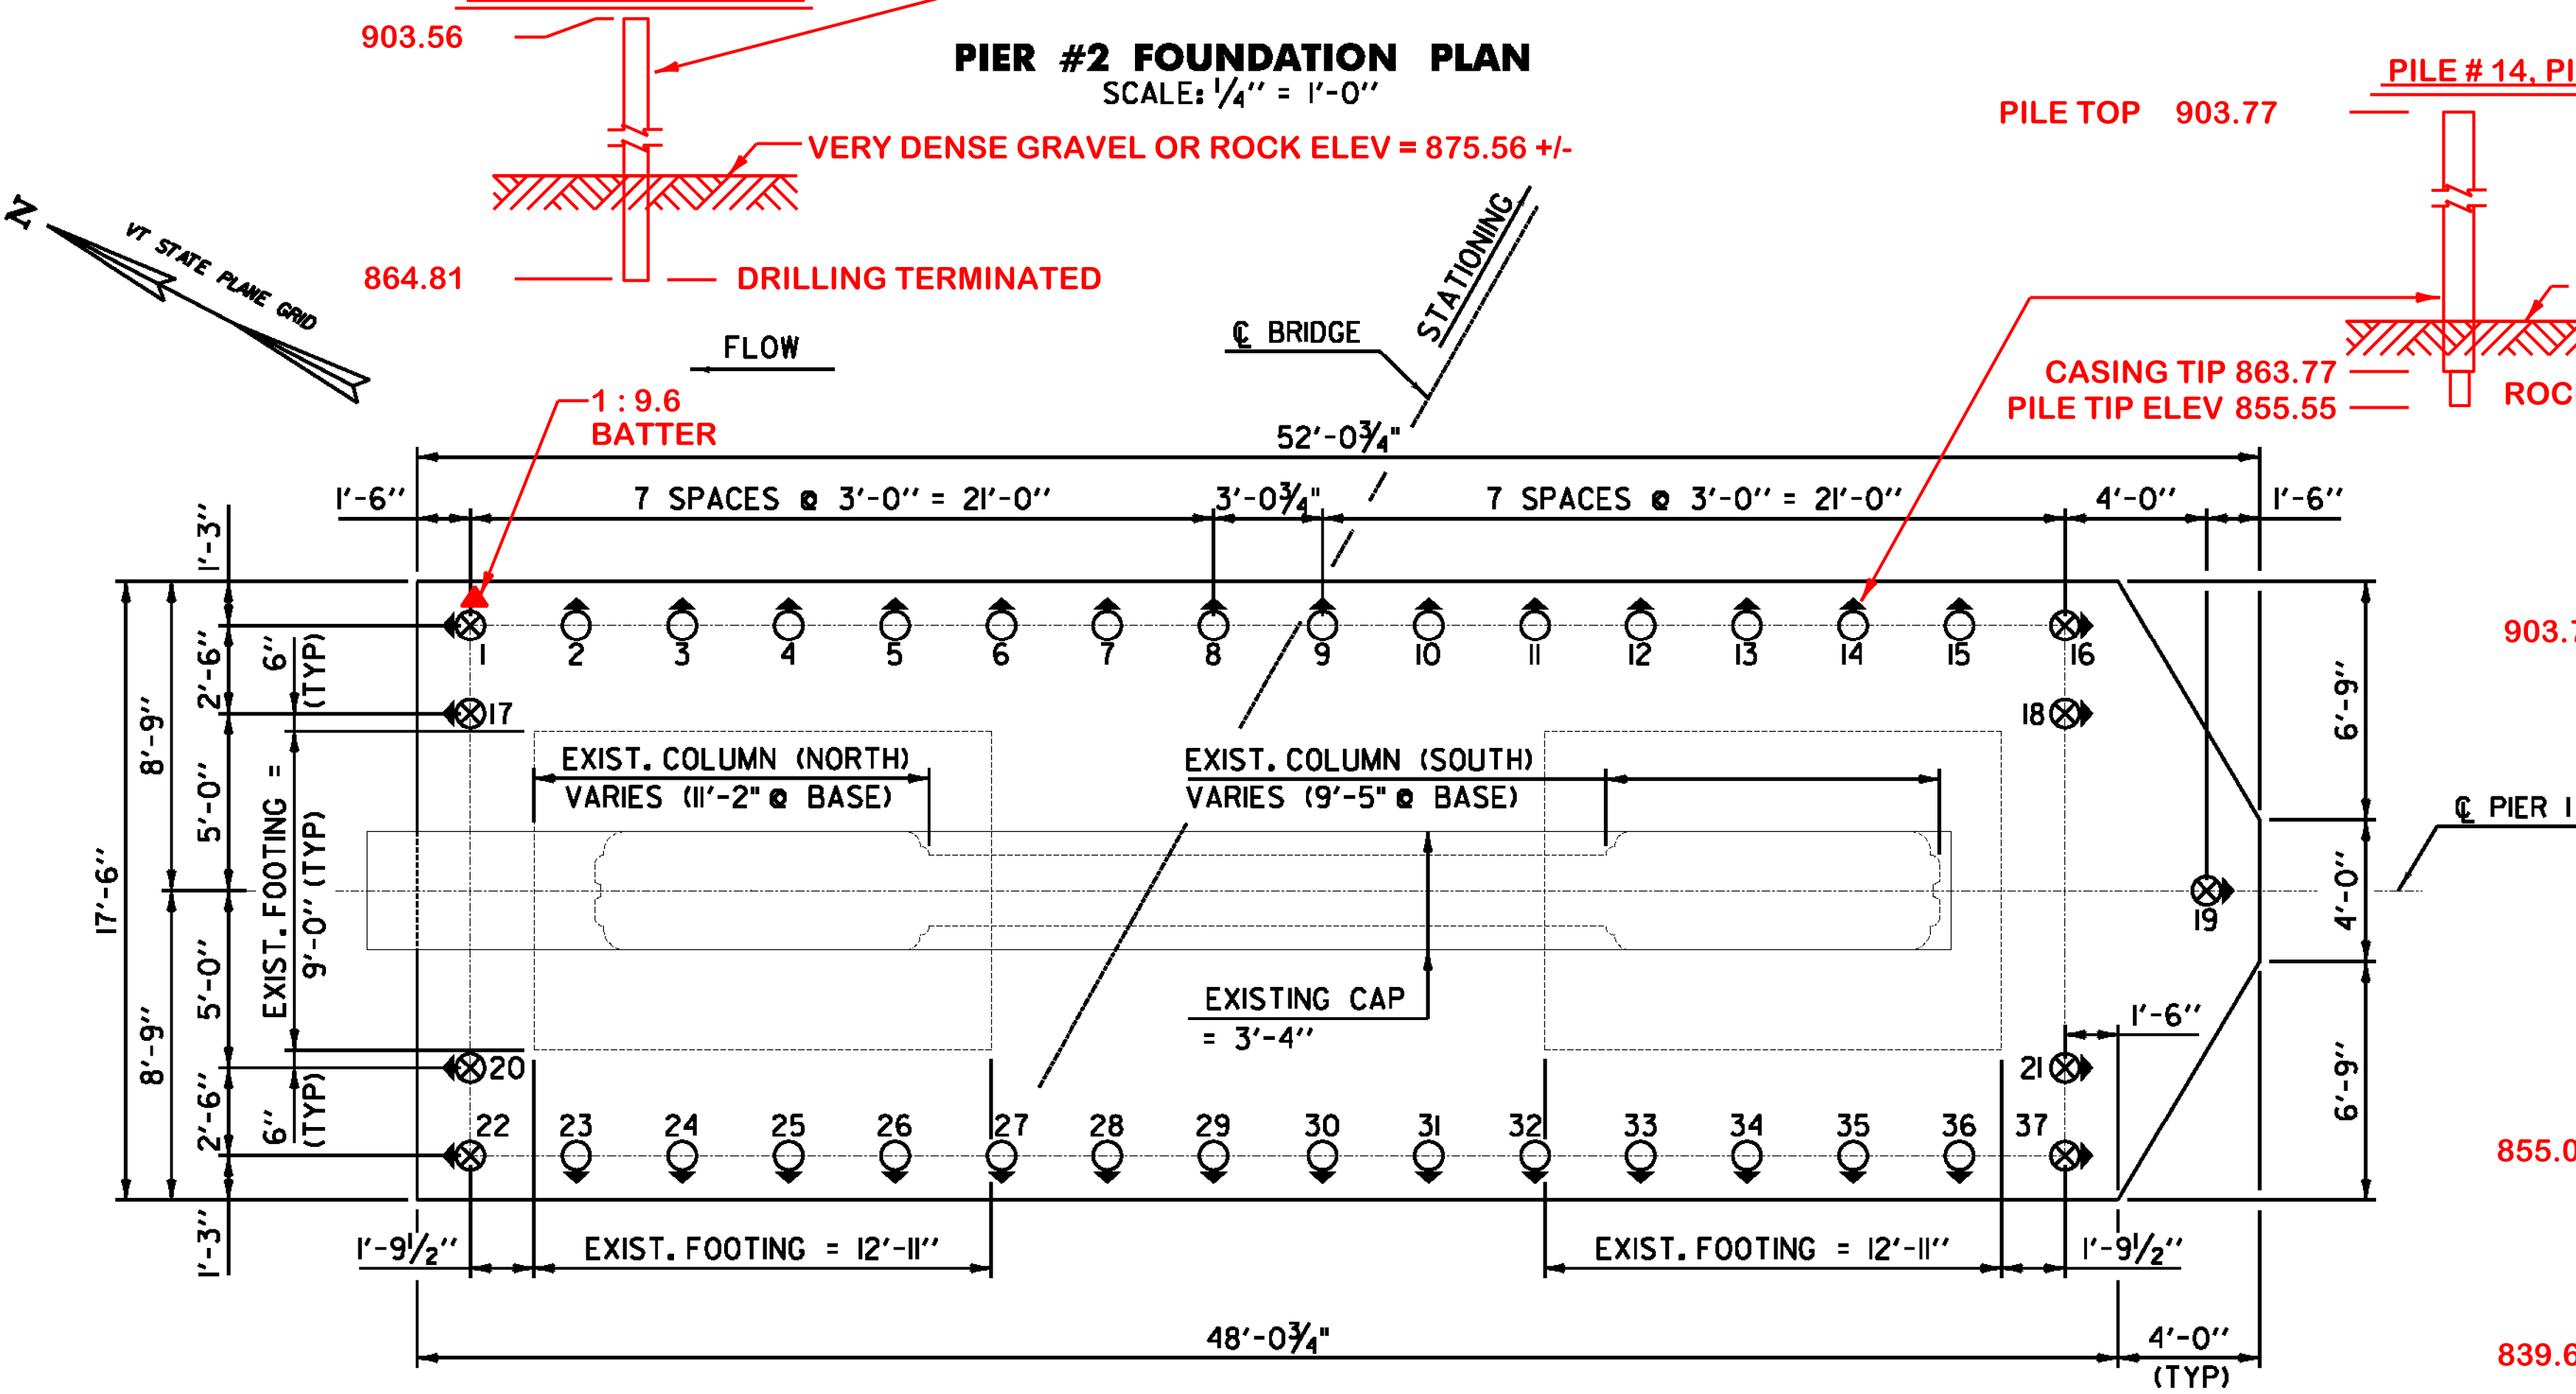

- LEGEND**
- ITEM 900.620 SPECIAL PROVISION (MICROPILE) INSTALLED ON A 1:6 BATTER
 - ⊗ ITEM 900.620 SPECIAL PROVISION (MICROPILE) INSTALLED ON A 1:4 BATTER

NOTE:

1. EXISTING COLUMN AND FOOTING DIMENSIONS ARE APPROXIMATE. THE CONTRACTOR SHALL VERIFY ALL DIMENSIONS AND ELEVATIONS PRIOR TO FABRICATING STEEL REINFORCING.



| | | |
|---------------------------------|-----------------------------------|----------------------|
| RETROFIT FOUNDATION PLAN | PROJECT NAME: BENNINGTON | PLOT DATE: 8/21/2012 |
| | PROJECT NUMBER: ER BHF 010-I(45) | DRAWN BY: M.E.D. |
| | FILE NAME: zllb326_foundation.dgn | CHECKED BY: A.M.P. |
| | DWG. NO.: zllb326foundation.i | SHEET 26 OF 40 |

FILE NAME = W:\Projects\BENNINGTON\23770\CADD\MSTN_zllb326_Foundation.dgn
 DATE/TIME = 8/21/2012 4:06