



**PIER 1 SECTION A-A**  
SCALE: 1/2" = 1'-0"

CONSTRUCTION JOINT  
MODIFIED PER C.O. #2

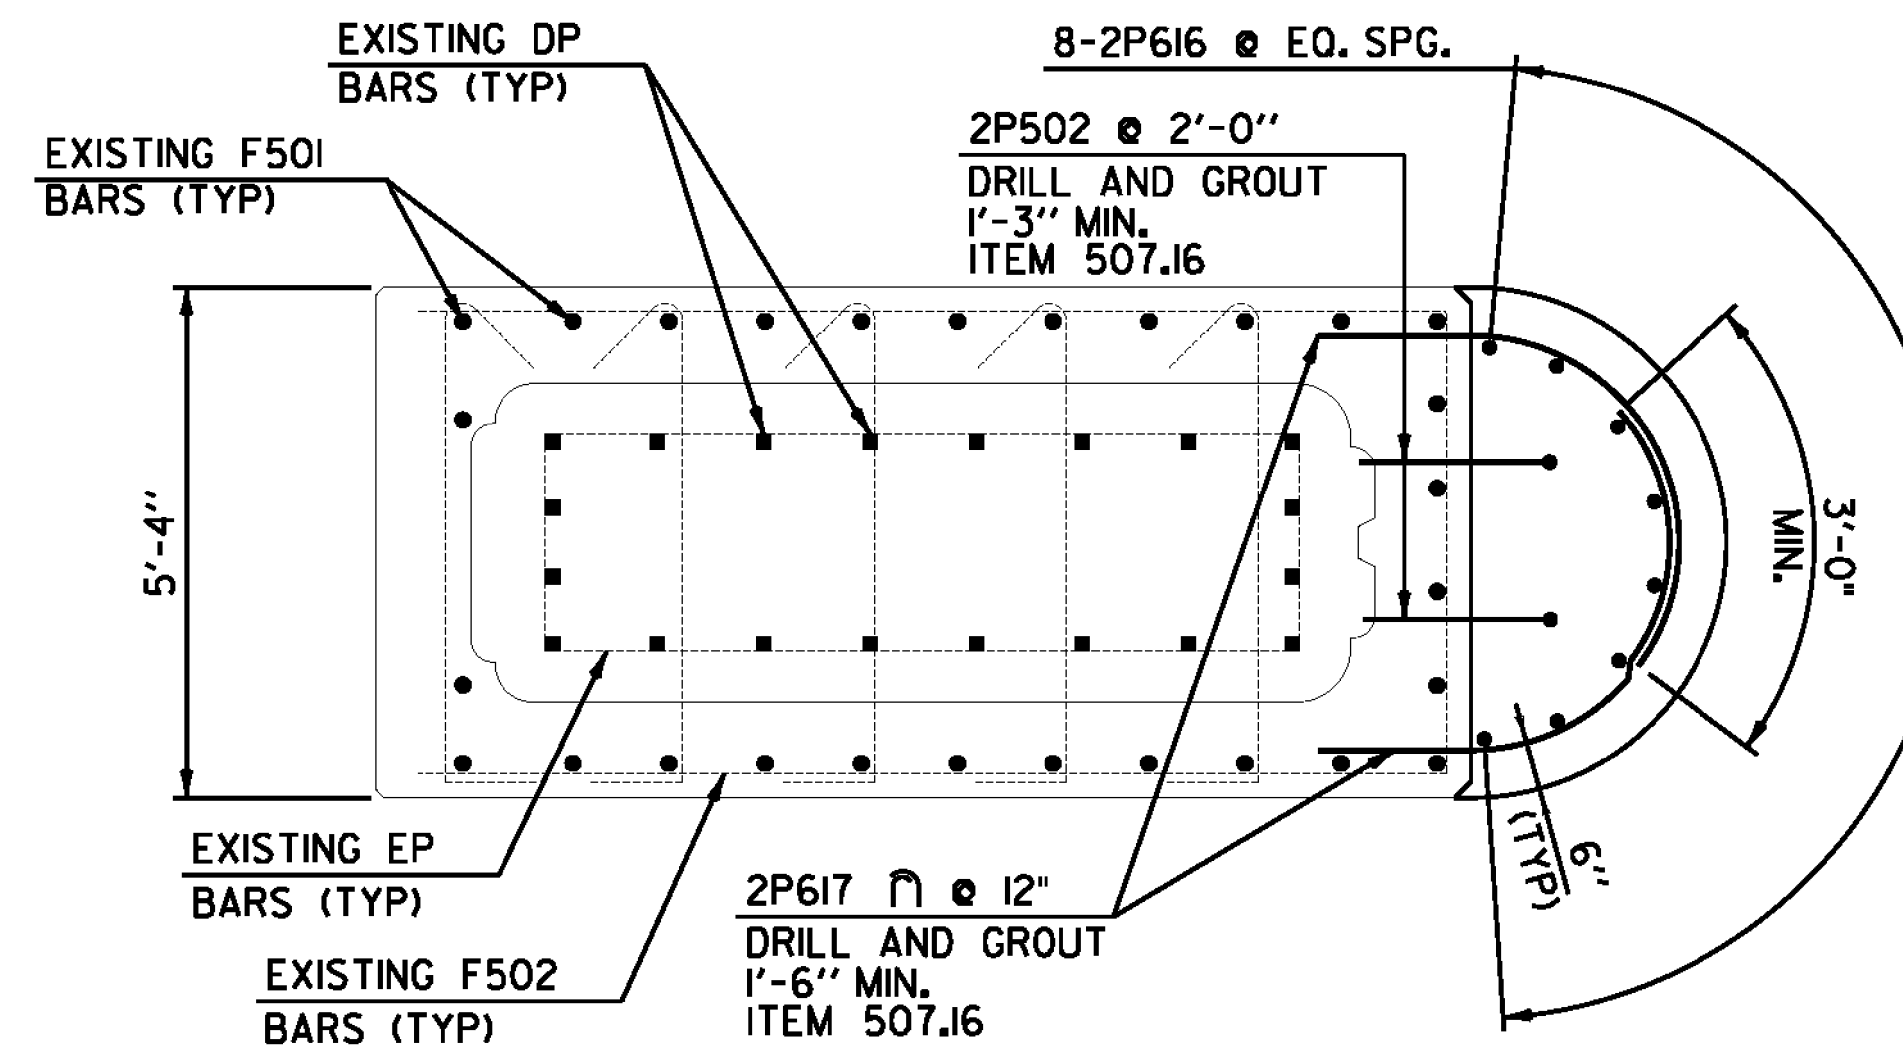


**PIER 2 SECTION B-B**  
SCALE: 1/2" = 1'-0"

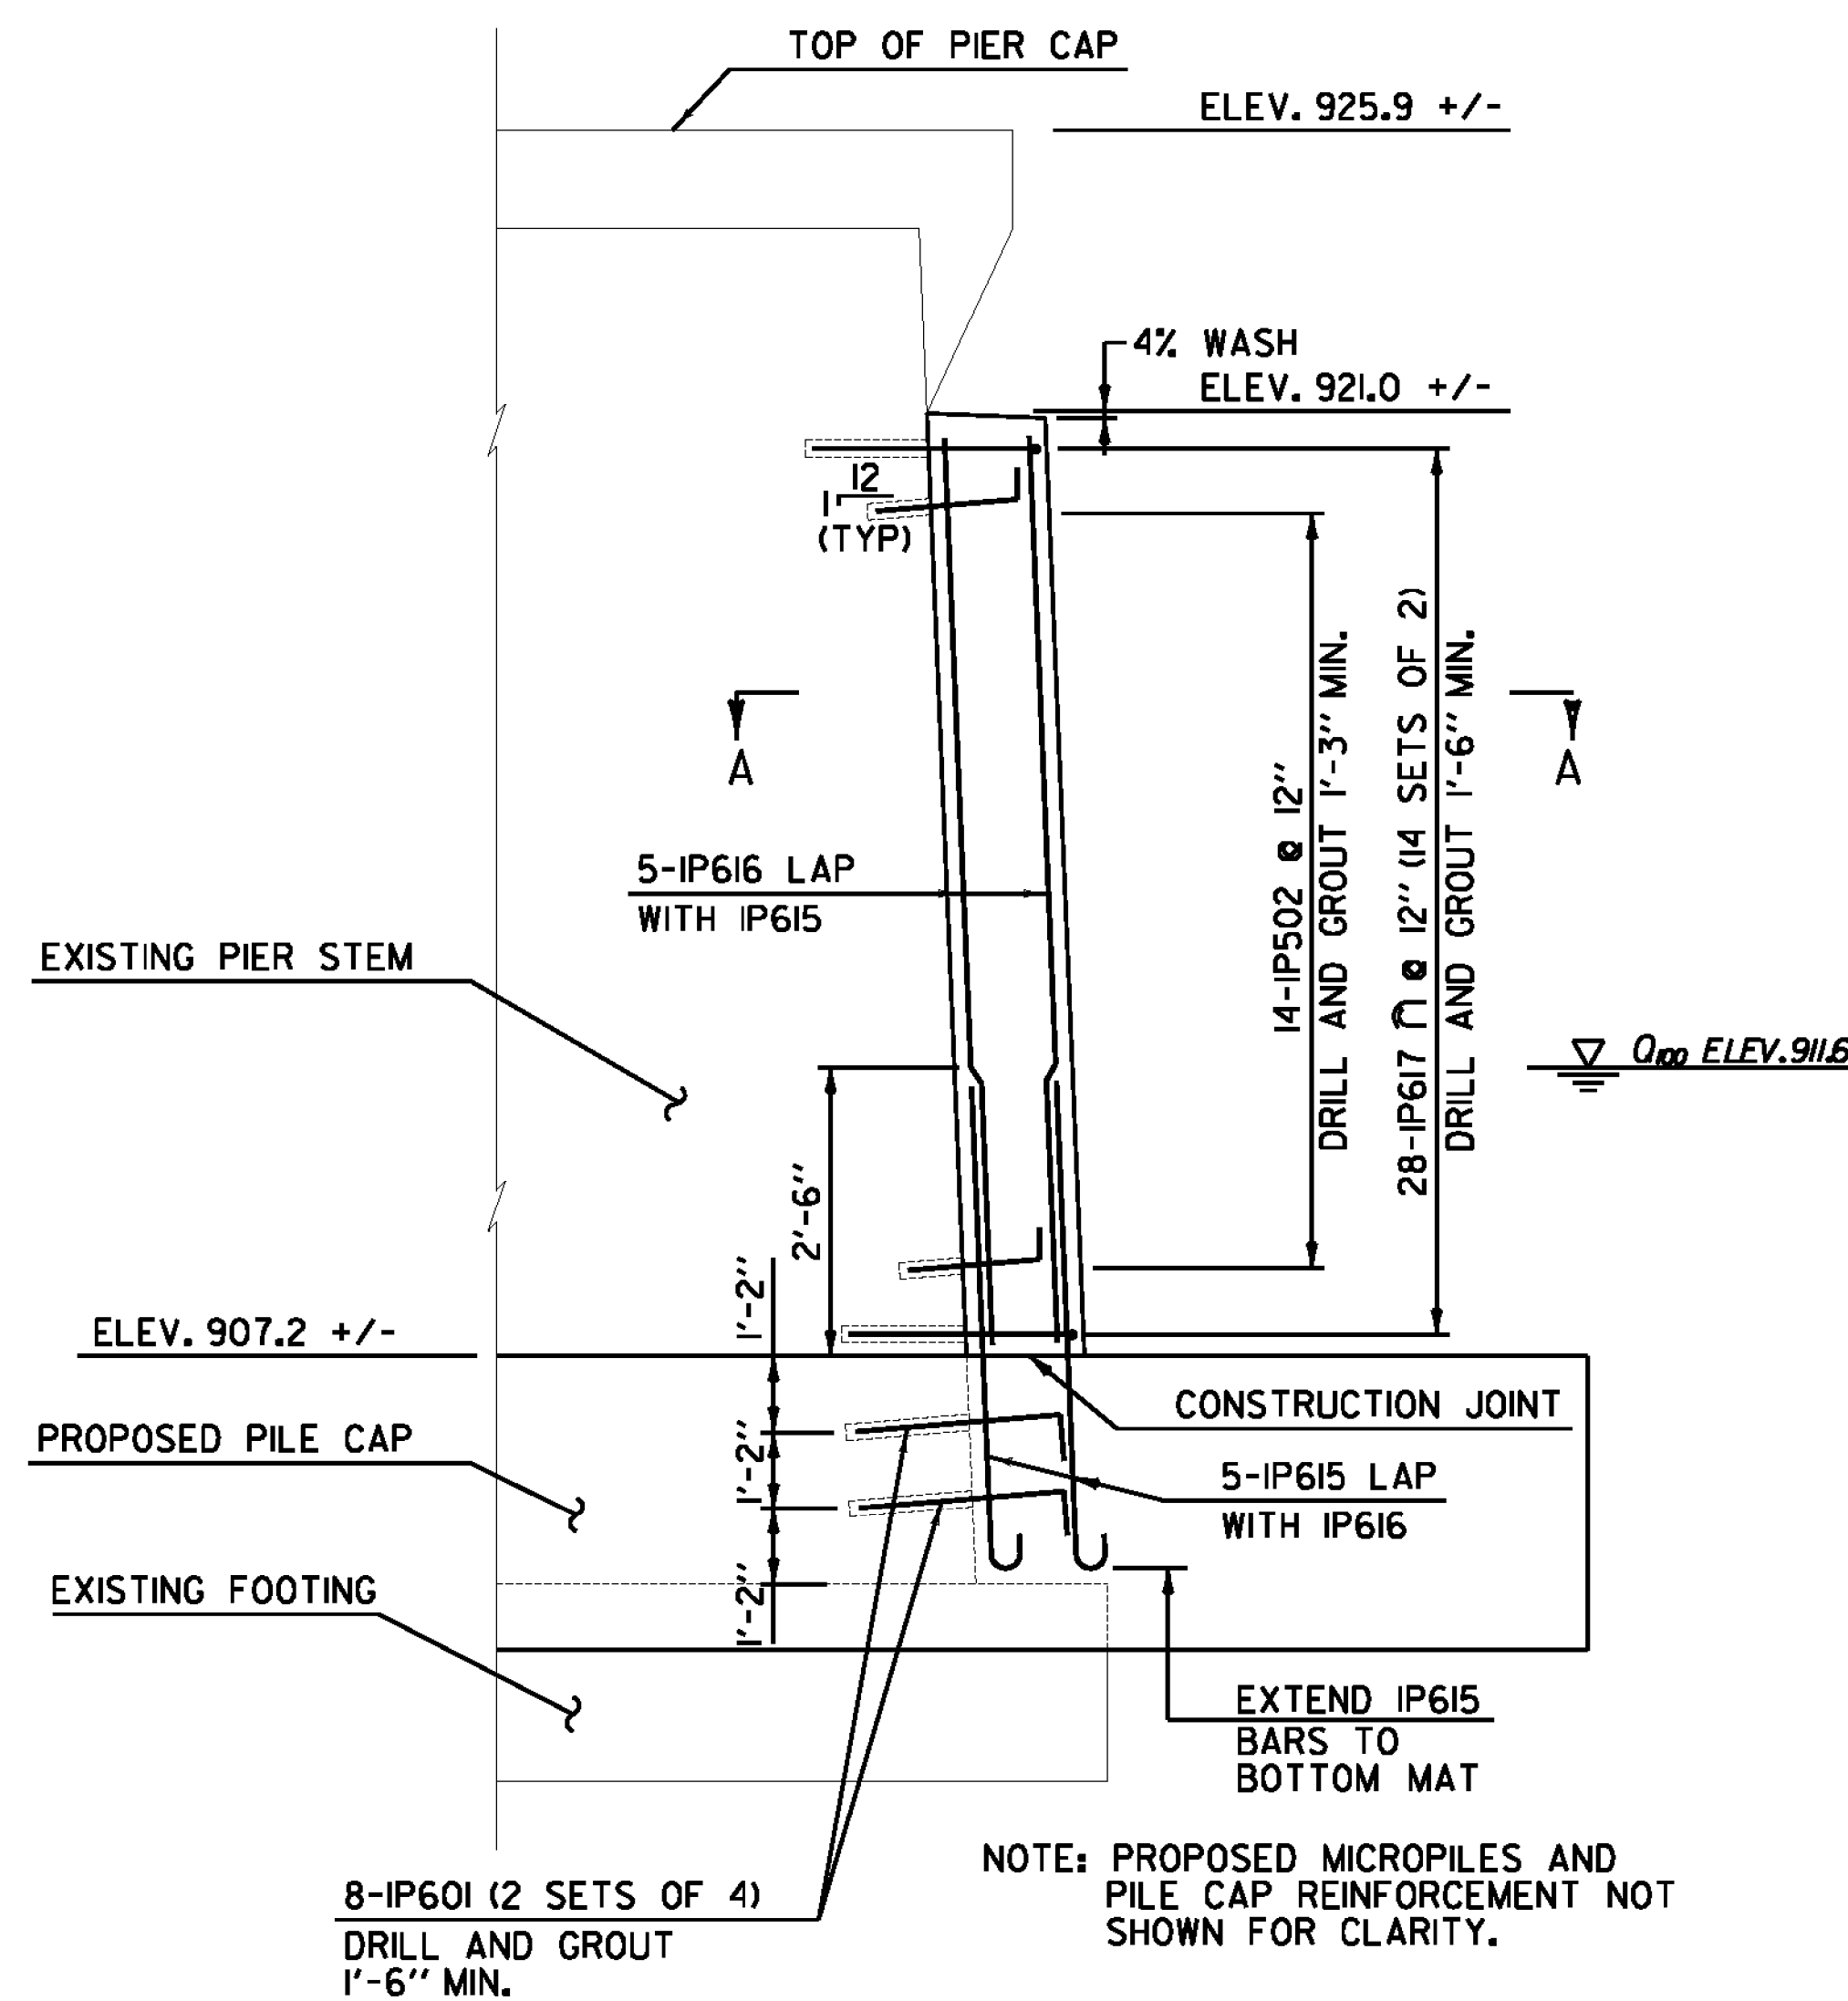

**PIER 1 NOSING ELEVATION**  
SCALE: 3/8" = 1'-0"

NOTE: PROPOSED MICROPILES AND PILE CAP REINFORCEMENT NOT SHOWN FOR CLARITY.

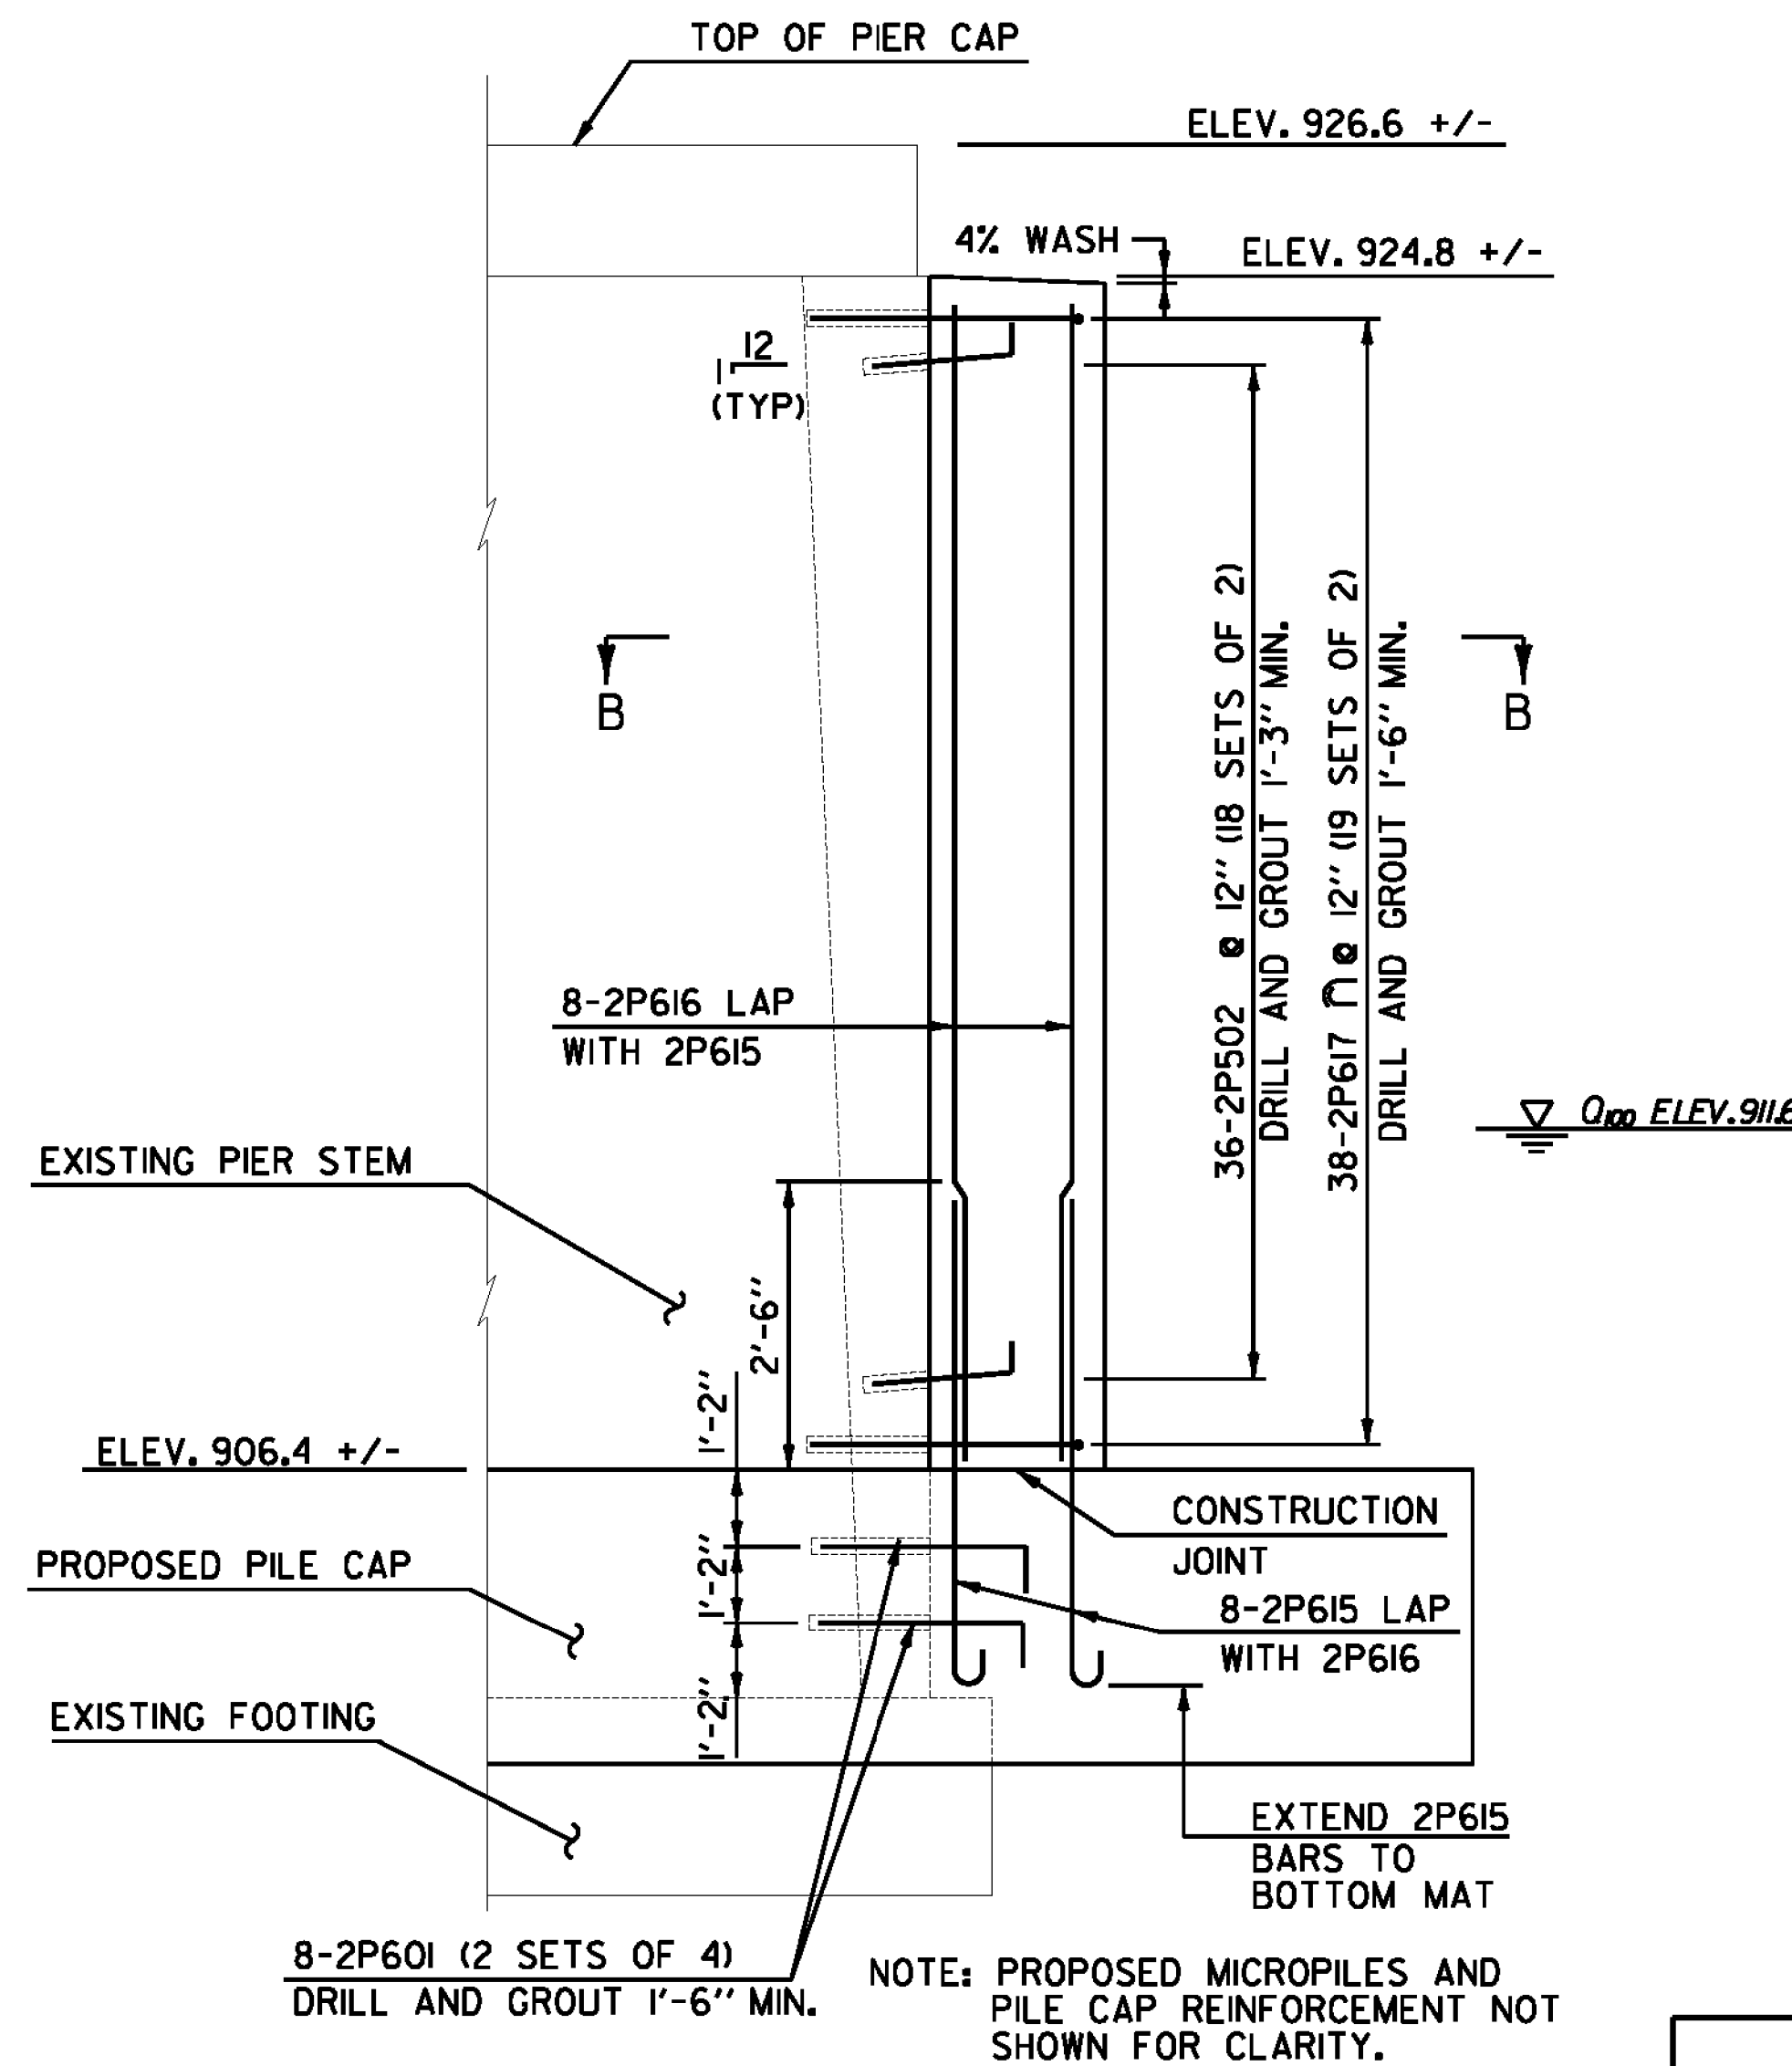

**PIER 2 NOSING ELEVATION**  
SCALE: 3/8" = 1'-0"

NOTE: PROPOSED MICROPILES AND PILE CAP REINFORCEMENT NOT SHOWN FOR CLARITY.

<b>PIER NOSING DETAIL SHEET</b>	PROJECT NAME: BENNINGTON	PLOT DATE: 8/21/2012
	PROJECT NUMBER: ER BHF 010-I(45)	DRAWN BY: M.E.D.
	FILE NAME: z1lb326_pier_detail.02.dgn	CHECKED BY: A.M.P.
	DWG. NO.: z1lb326pierdetail02.i	SHEET 30 OF 40



FILE NAME: \\V:\Projects\BENNINGTON\237770\CADD\MSTN\z1lb326\_pier\_detail.02.dgn  
DATE/TIME: 8/21/2012 4:46:46  
USER: jk