



21+25.00

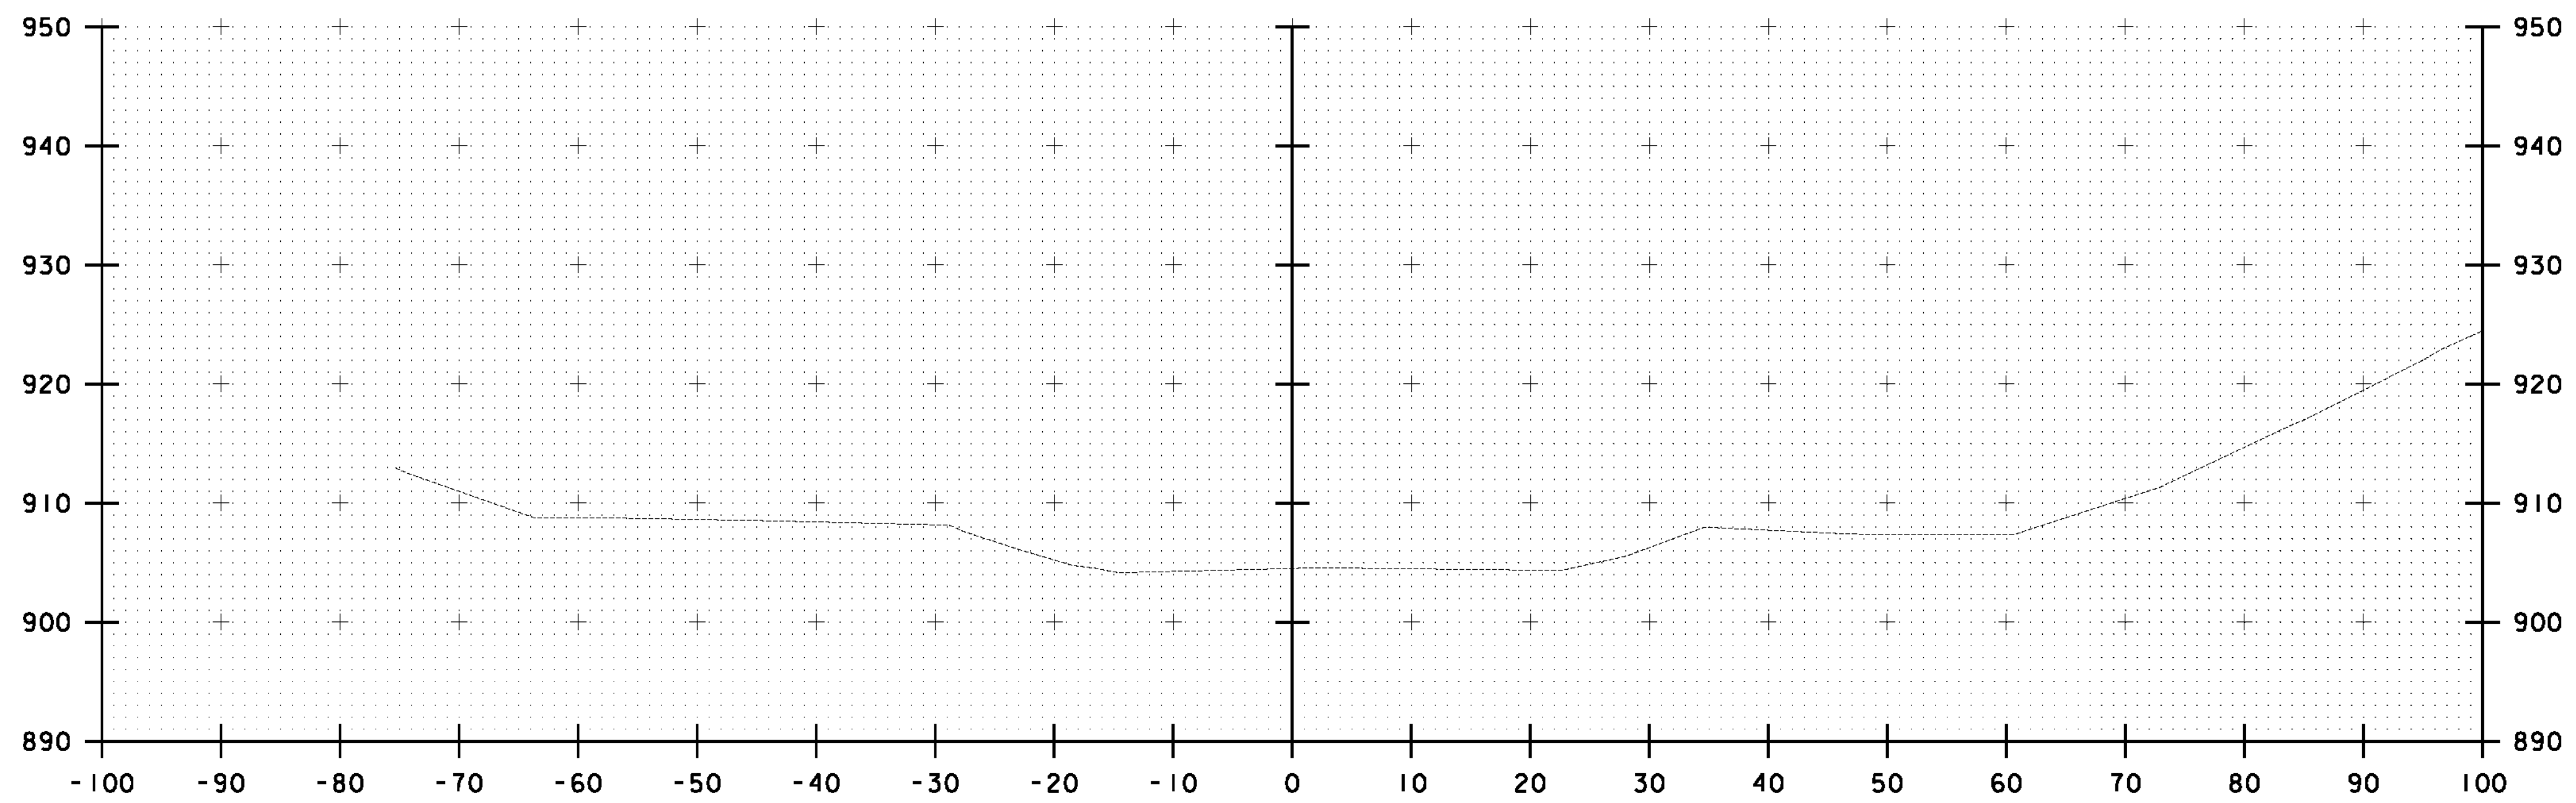

21+00.00

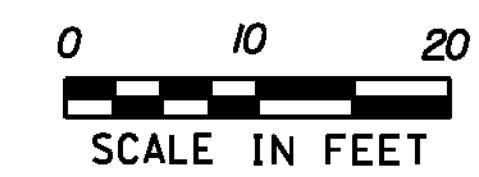

<b>CHANNEL CROSS SECTIONS SHEET #1</b>	PROJECT NAME: BENNINGTON	PLOT DATE: 8/21/2012
	PROJECT NUMBER: ER BHF 010-I(45)	DRAWN BY: W.E.P.
	FILE NAME: z1lb326_xs_channel.dgn	CHECKED BY: D.E.G.
	PROJECT LEADER: D.E.G.	SHEET 32 OF 40
	DESIGNED BY: B.T.H.	
	DWG. NO.: z1lb326xs.1	