



21+75.00

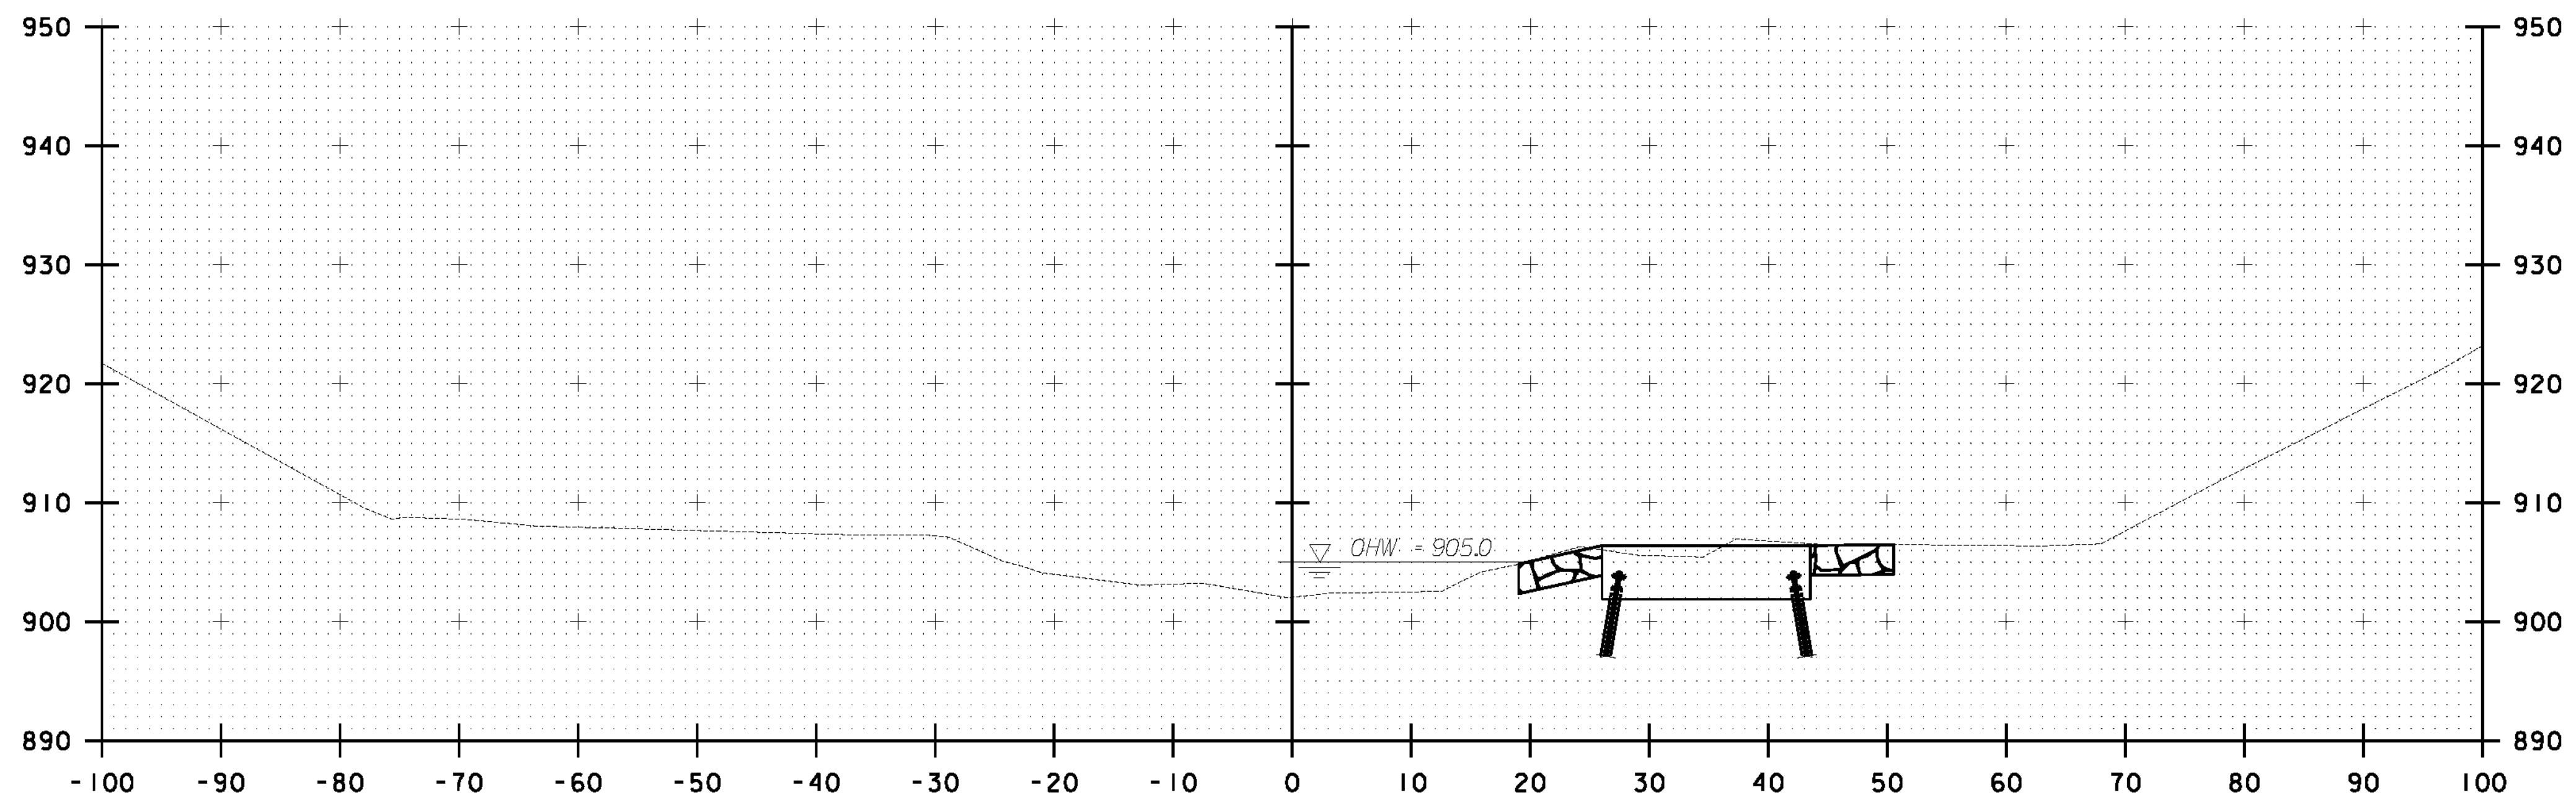

21+50.00

STA 21+45.00 RT
 BEGIN RIPRAP, HEAVY TYPE
 BEGIN STRUCTURE EXCAVATION
 BEGIN GEOTEXTILE UNDER STONE FILL

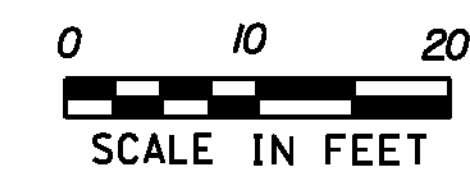

**CHANNEL
 CROSS
 SECTIONS
 SHEET #2**

PROJECT NAME: BENNINGTON
 PROJECT NUMBER: ER BHF 010-I(45)

FILE NAME: z1lb326_xs_channel.dgn
 PROJECT LEADER: D.E.G.
 DESIGNED BY: B.T.H.
 DWG. NO.: z1lb326xs.1

PLOT DATE: 8/21/2012
 DRAWN BY: W.E.P.
 CHECKED BY: D.E.G.
 SHEET 33 OF 40

