



22+25.00

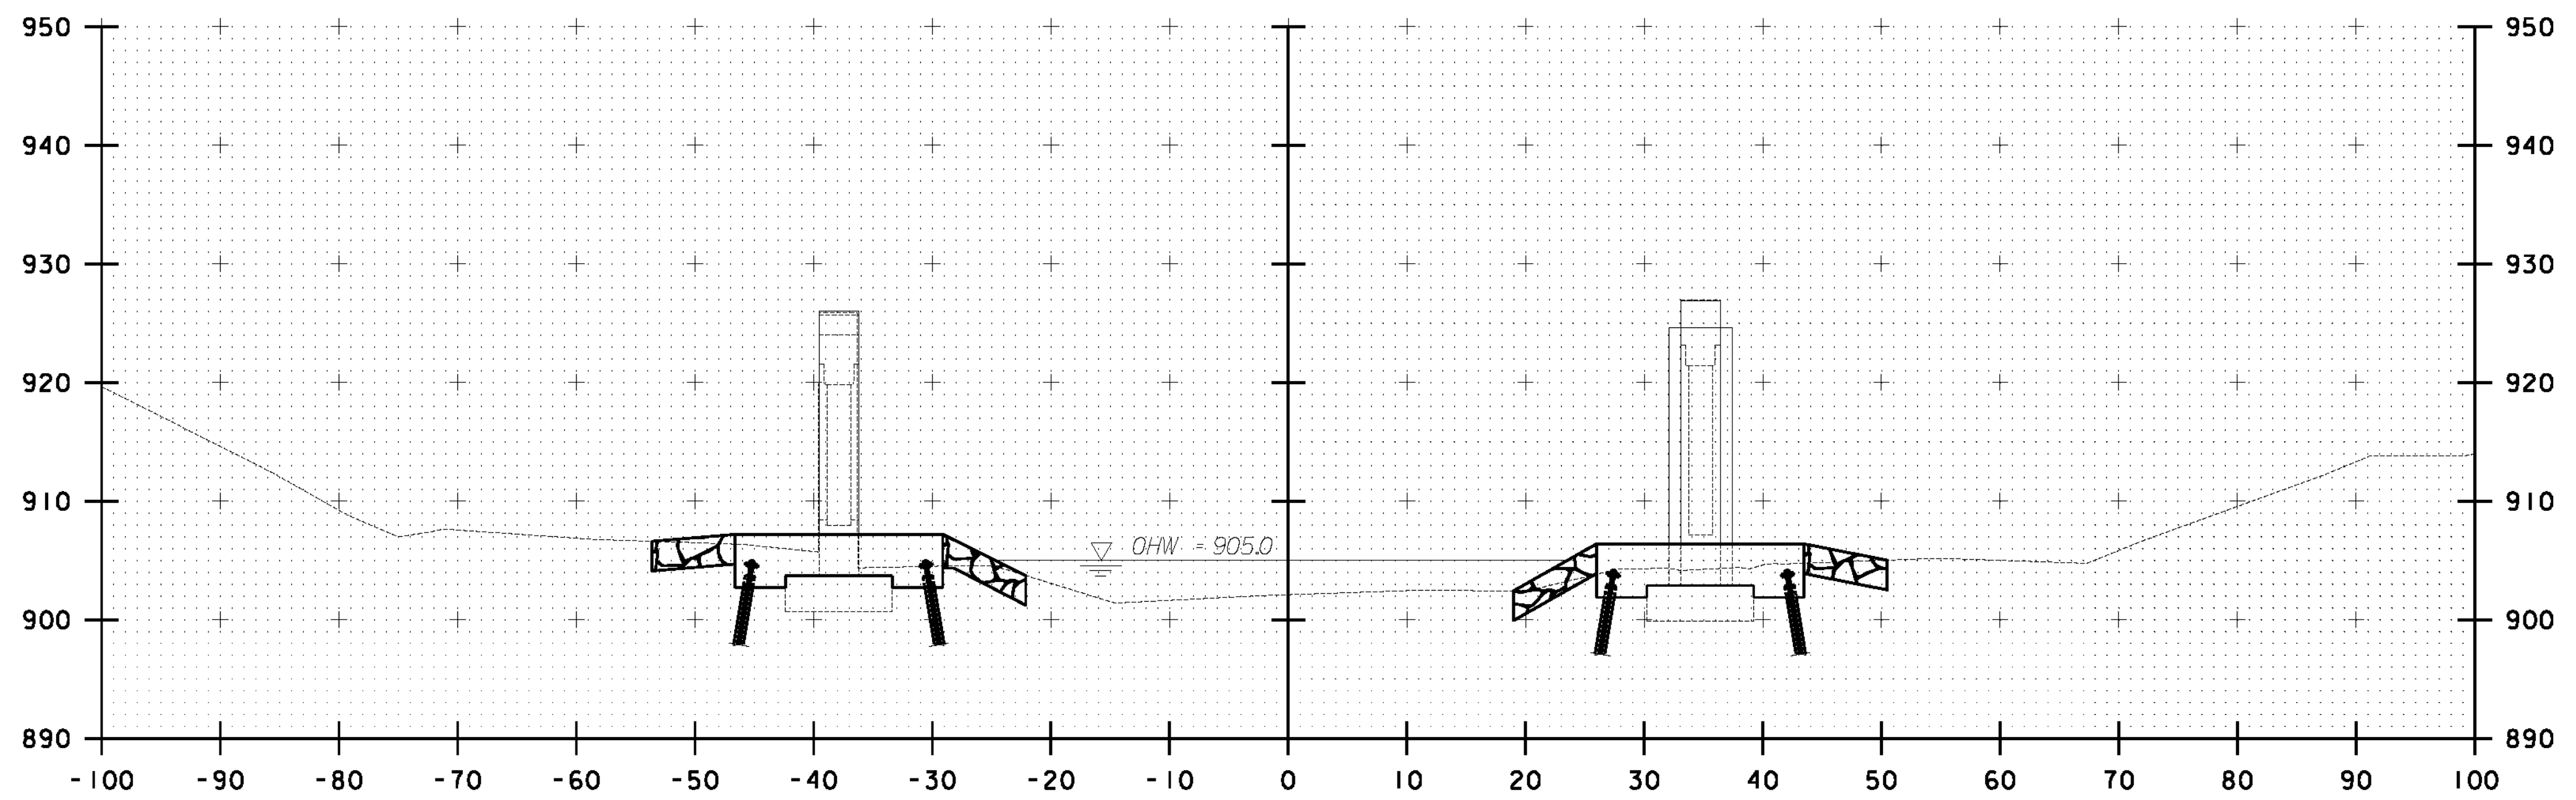

22+00.00

STA 21+87.00 LT  
 BEGIN RIPRAP, HEAVY TYPE  
 BEGIN STRUCTURE EXCAVATION  
 BEGIN GEOTEXTILE UNDER STONE FILL

STA 22+07.00 RT  
 END RIPRAP, HEAVY TYPE  
 END STRUCTURE EXCAVATION  
 END GEOTEXTILE UNDER STONE FILL

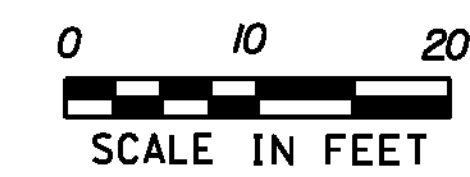

**CHANNEL  
 CROSS  
 SECTIONS  
 SHEET #3**

PROJECT NAME: BENNINGTON  
 PROJECT NUMBER: ER BHF 010-I(45)

FILE NAME: z1b326\_xs\_channel.dgn  
 PROJECT LEADER: D.E.G.  
 DESIGNED BY: B.T.H.  
 DWG. NO.: z1b326xs.1

PLOT DATE: 8/21/2012  
 DRAWN BY: W.E.P.  
 CHECKED BY: D.E.G.  
 SHEET 34 OF 40

