



FILE NAME: V:\Projects\ANY\K2\23770\CADD\MSTN\zlib326_xs_channel.dgn
DATE/TIME: 8/21/2012
USER: 4866

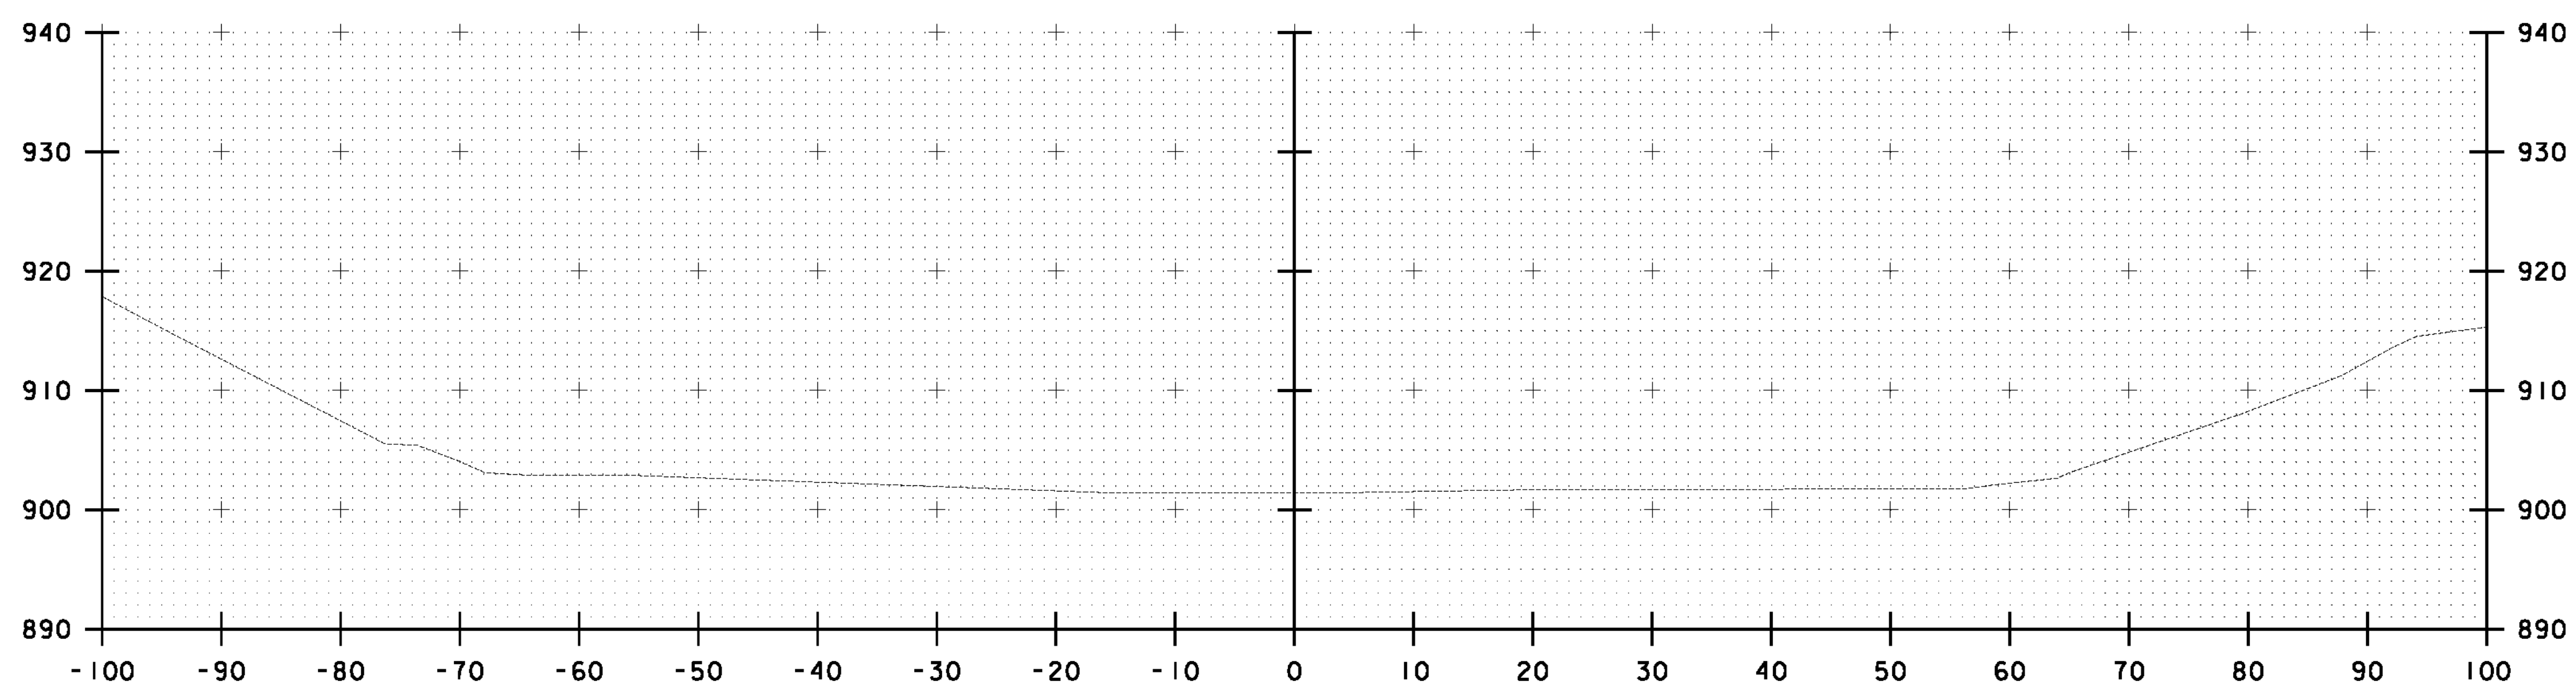

23+00.00

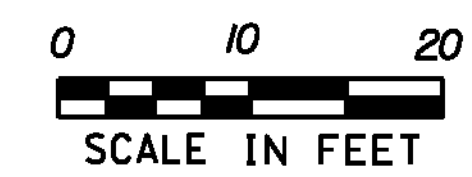

**CHANNEL
CROSS
SECTIONS
SHEET #5**

PROJECT NAME: BENNINGTON
PROJECT NUMBER: ER BHF 010-I(45)

FILE NAME: zlb326_xs_channel.dgn
PROJECT LEADER: D.E.G.
DESIGNED BY: B.T.H.
DWG. NO.: zlb326xs.1

PLOT DATE: 8/21/2012
DRAWN BY: W.E.P.
CHECKED BY: D.E.G.
SHEET 36 OF 40