
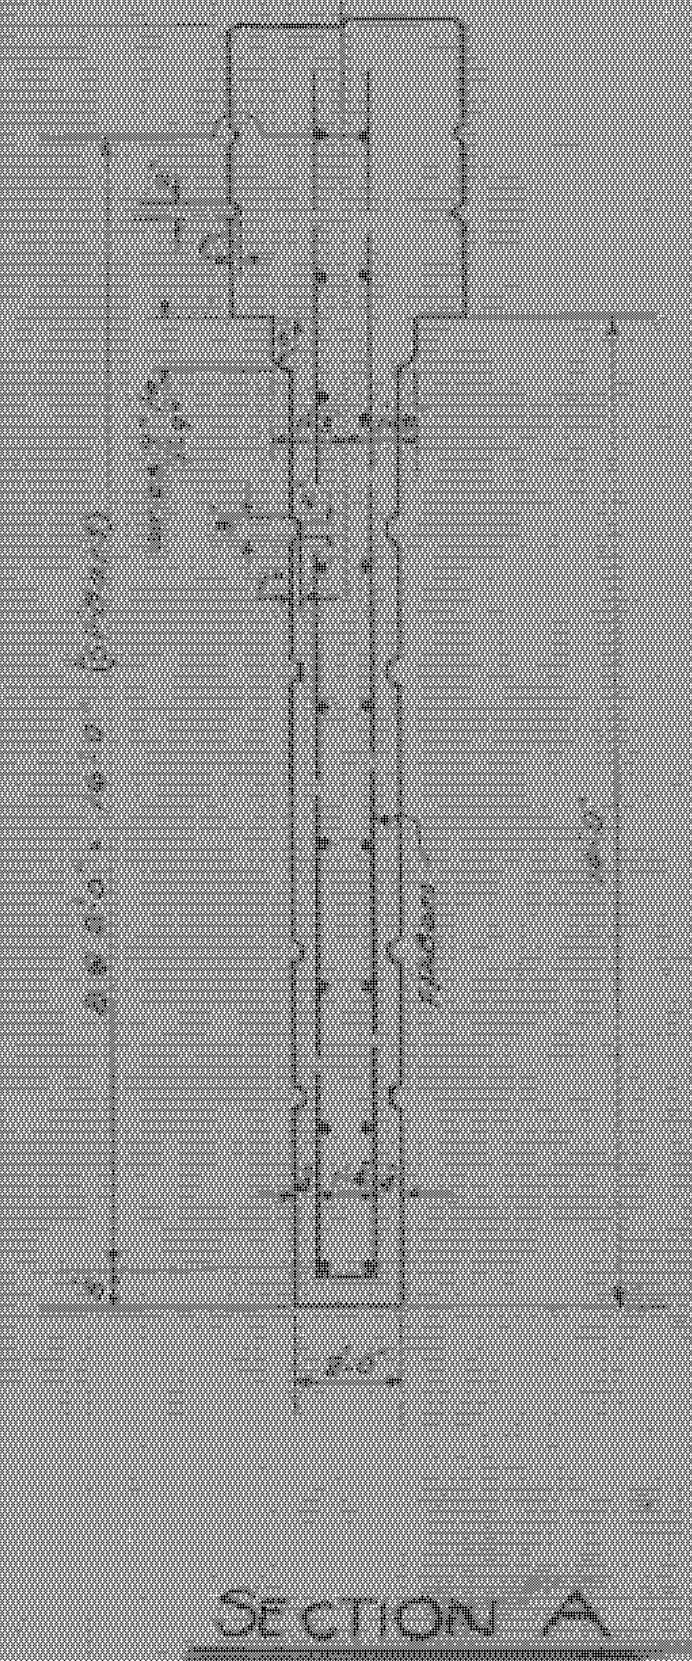


REINFORCING STEEL				
MARK	REQD.	SIZE	TOTL LQTY	SHAPE
AP	24	1/2"	1253	straight
BP	30	1/4"	874	straight
CP	40	1/2"	978	tee
DP	20	1/2"	216	straight
EP	38	5/8"	210 (long) lengths vary from 22'-0" to 23'-0" (long 210)	tee
FP	10	5/8"	3514	tee
GP	18	5/8"	2270	straight

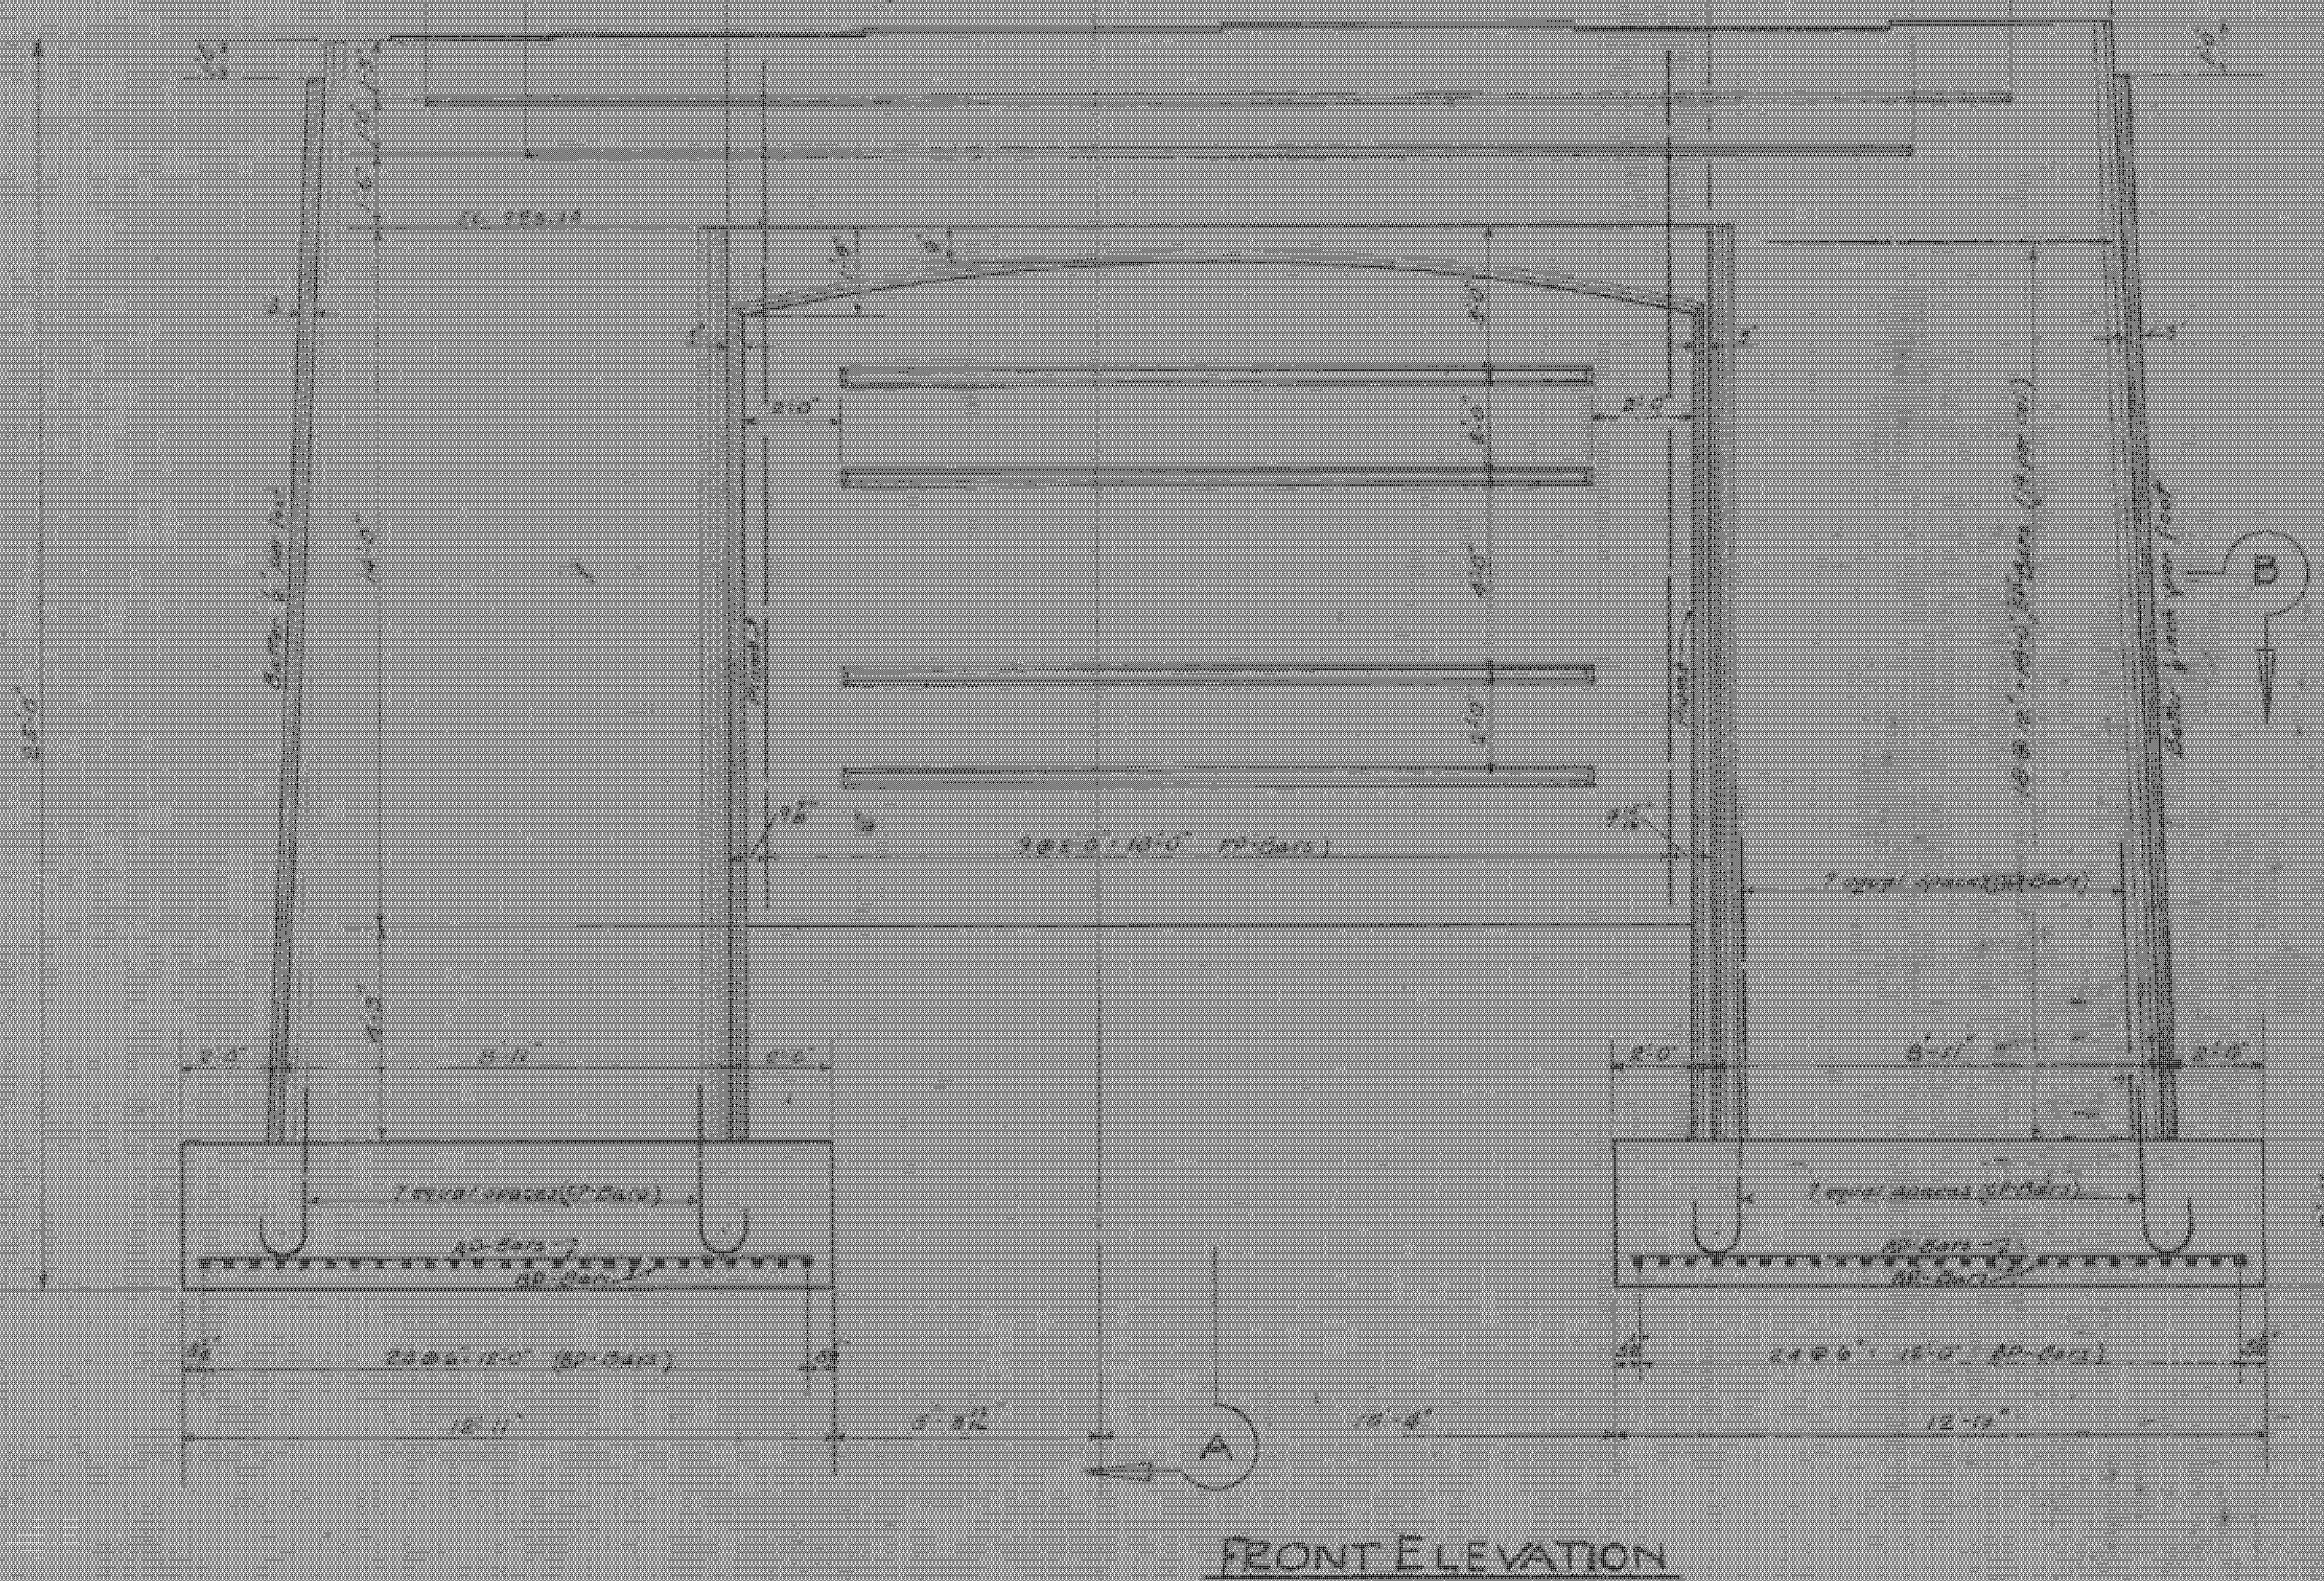

FOR REFERENCE ONLY  
 Revision  
 BHF 010-2(21)S  
 Sheet 126 of 126

DETAILS OF PIER 2  
 FURNACE BRIDGE  
 BENNINGTON, VT  
 SCALE 1/2"=1'

ESTIMATED QUANTITIES			
Structural Excavation	96 CY	103	
Concrete Class A	183 CY	1045	
Reinforcing Steel	18128 LB	1018	