



PLAN

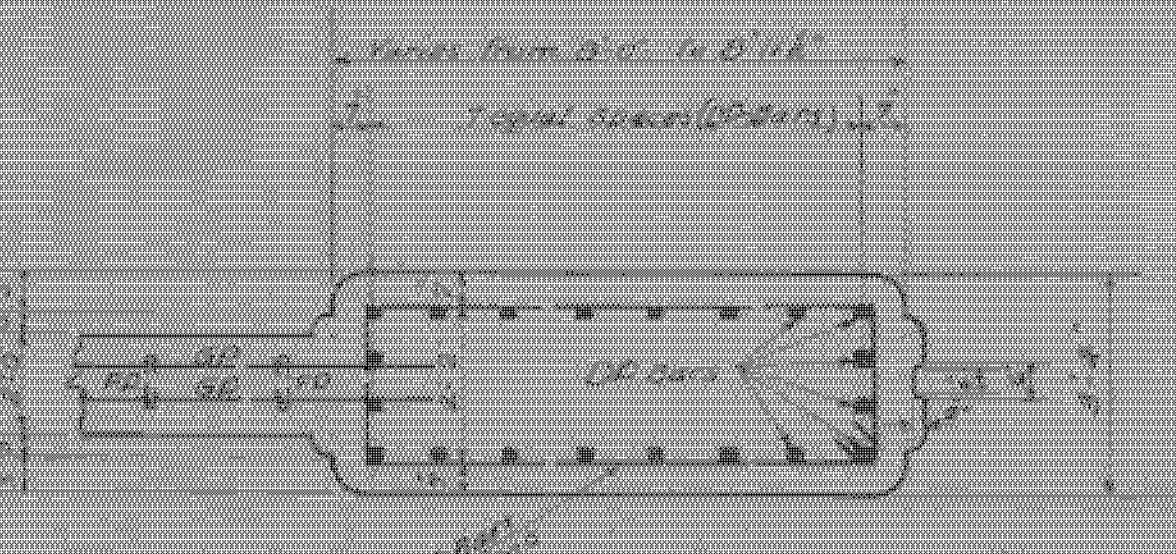


SECTION-B

REINFORCING STEEL

MARK	REIN. SIZE	TO LATH.	SHAPE	
AP	26	1'-0"	12'-3"	Straight
BP	30	1'-0"	6'-5"	"
CP	40	1'-0"	9'-3"	"
DP	40	1'-0"	22'-6"	Straight
EP	40	8'-0"	21'-0" Lath, varies from 20'-0" to 22'-0" (avg 21'-0")	"
FP	10	8'-0"	33'-4"	"
GP	18	8'-0"	22'-0"	Straight

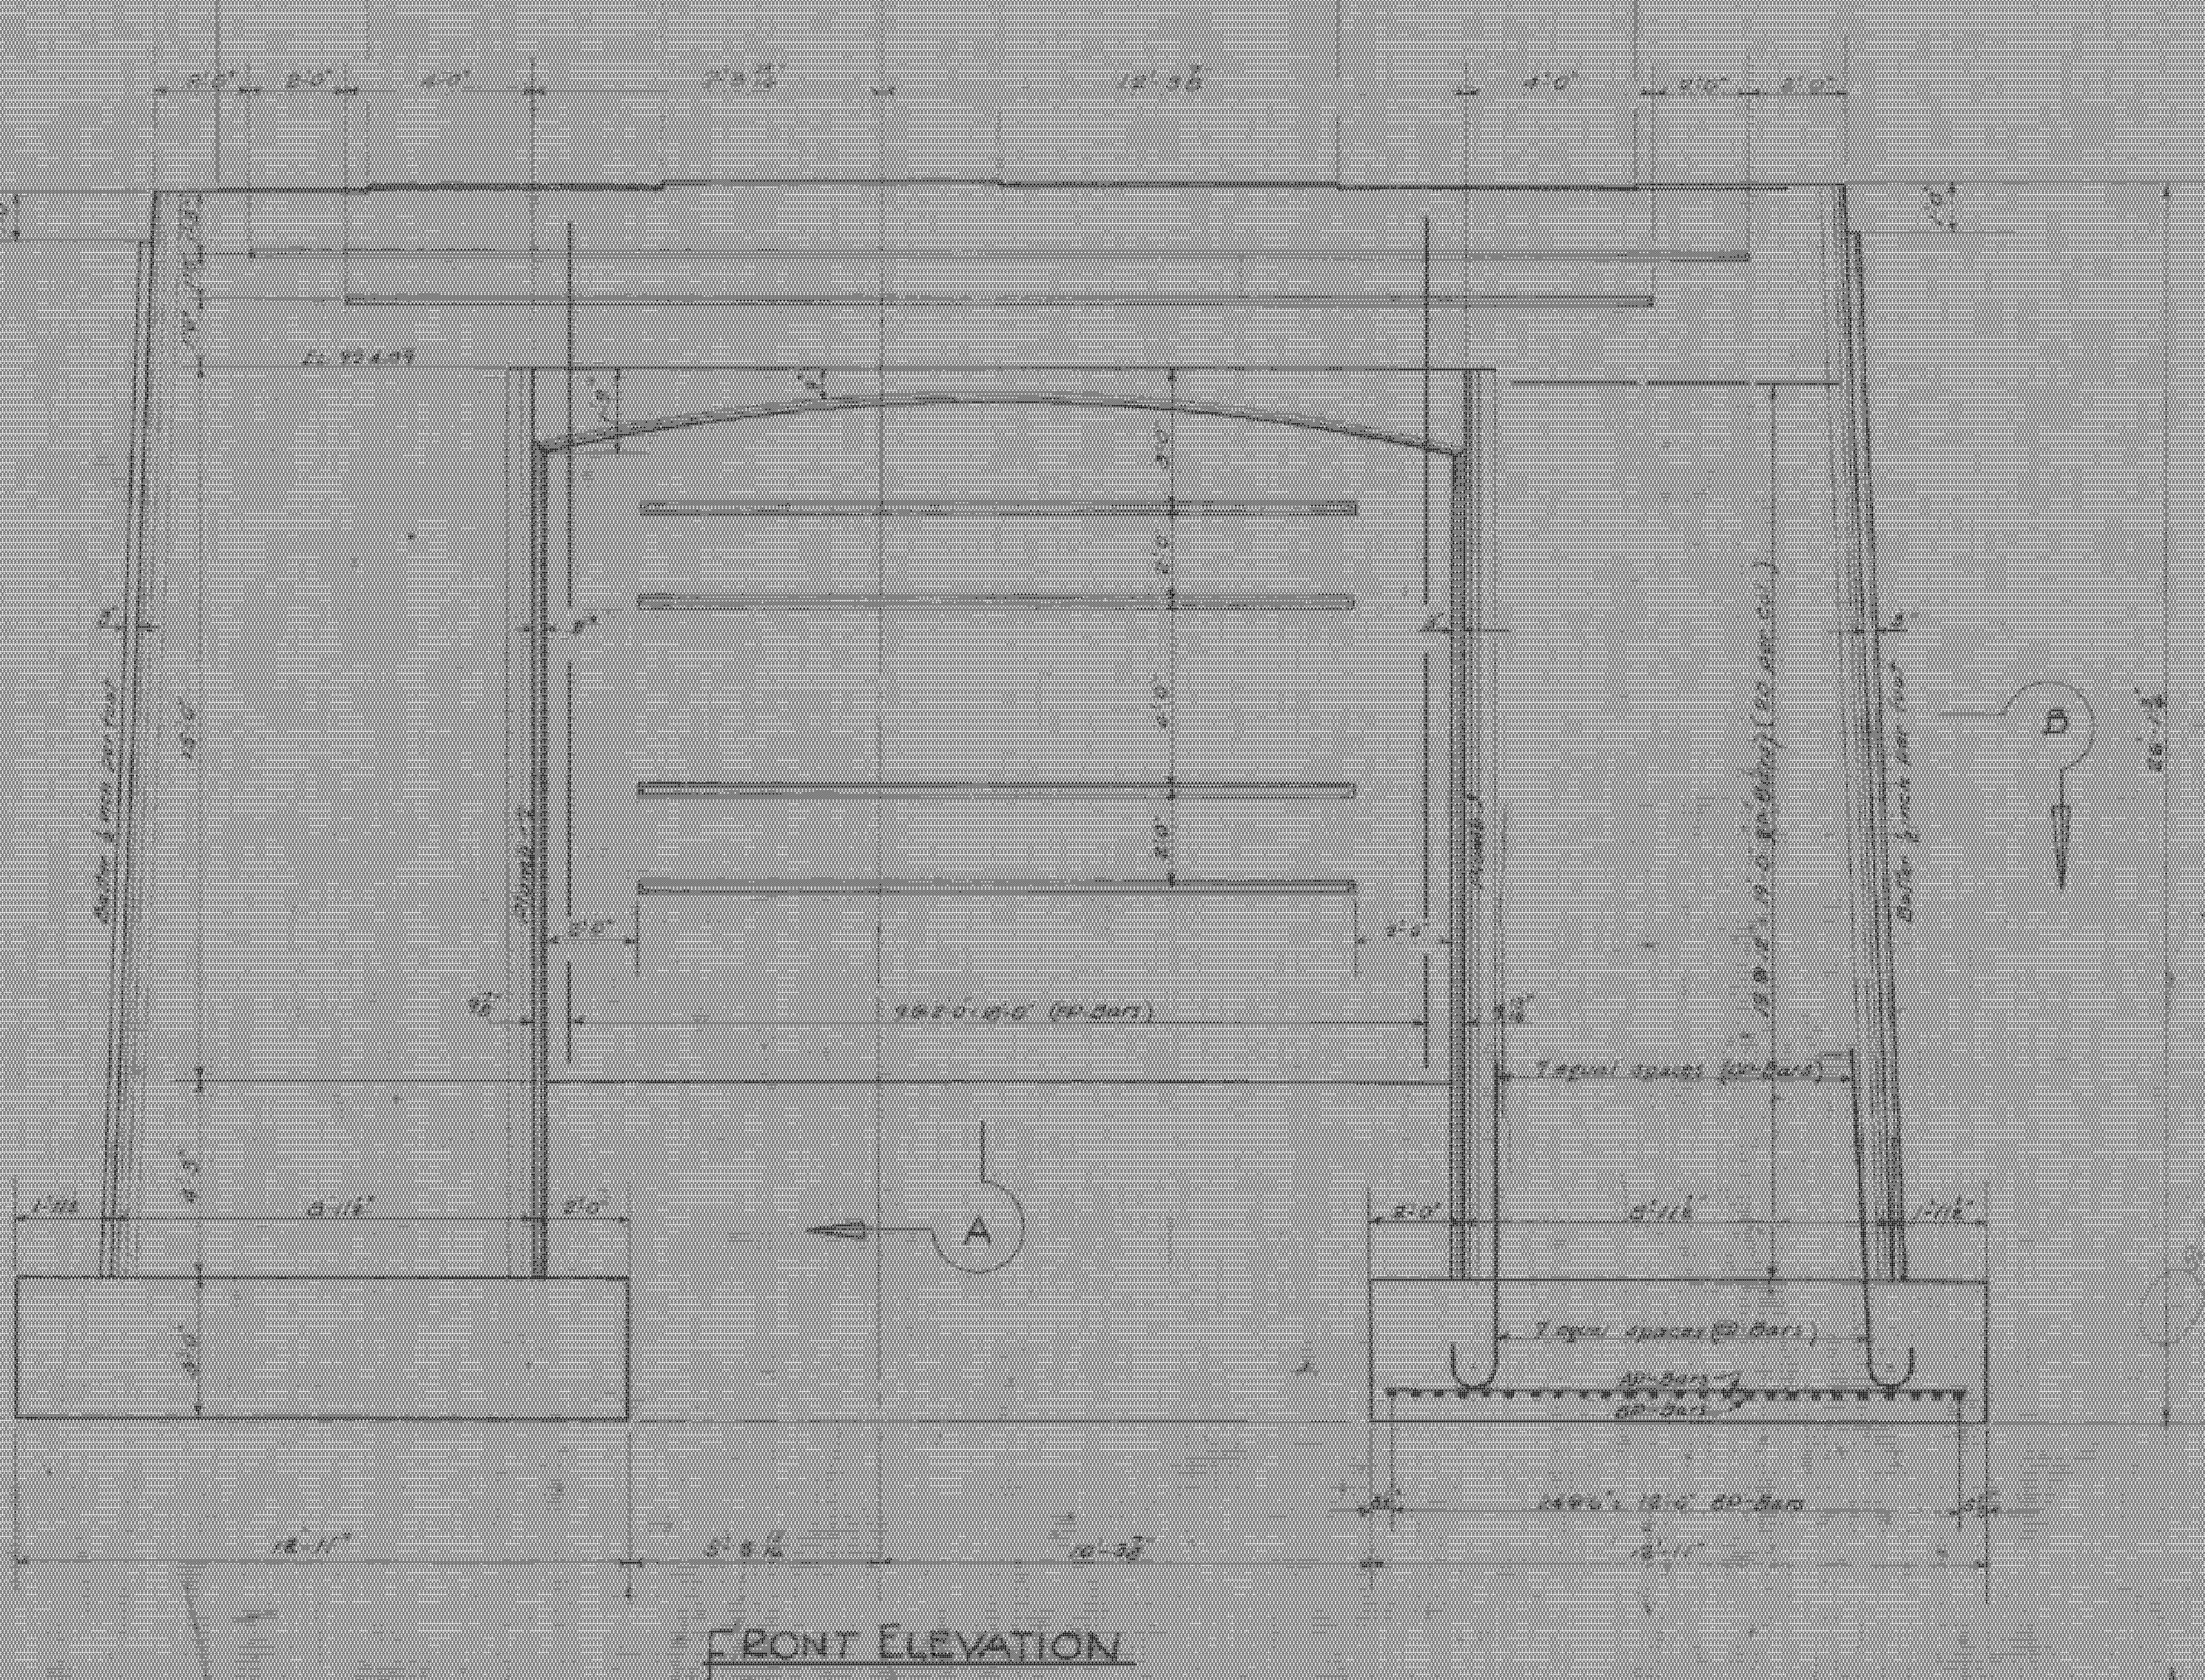

FRONT ELEVATION

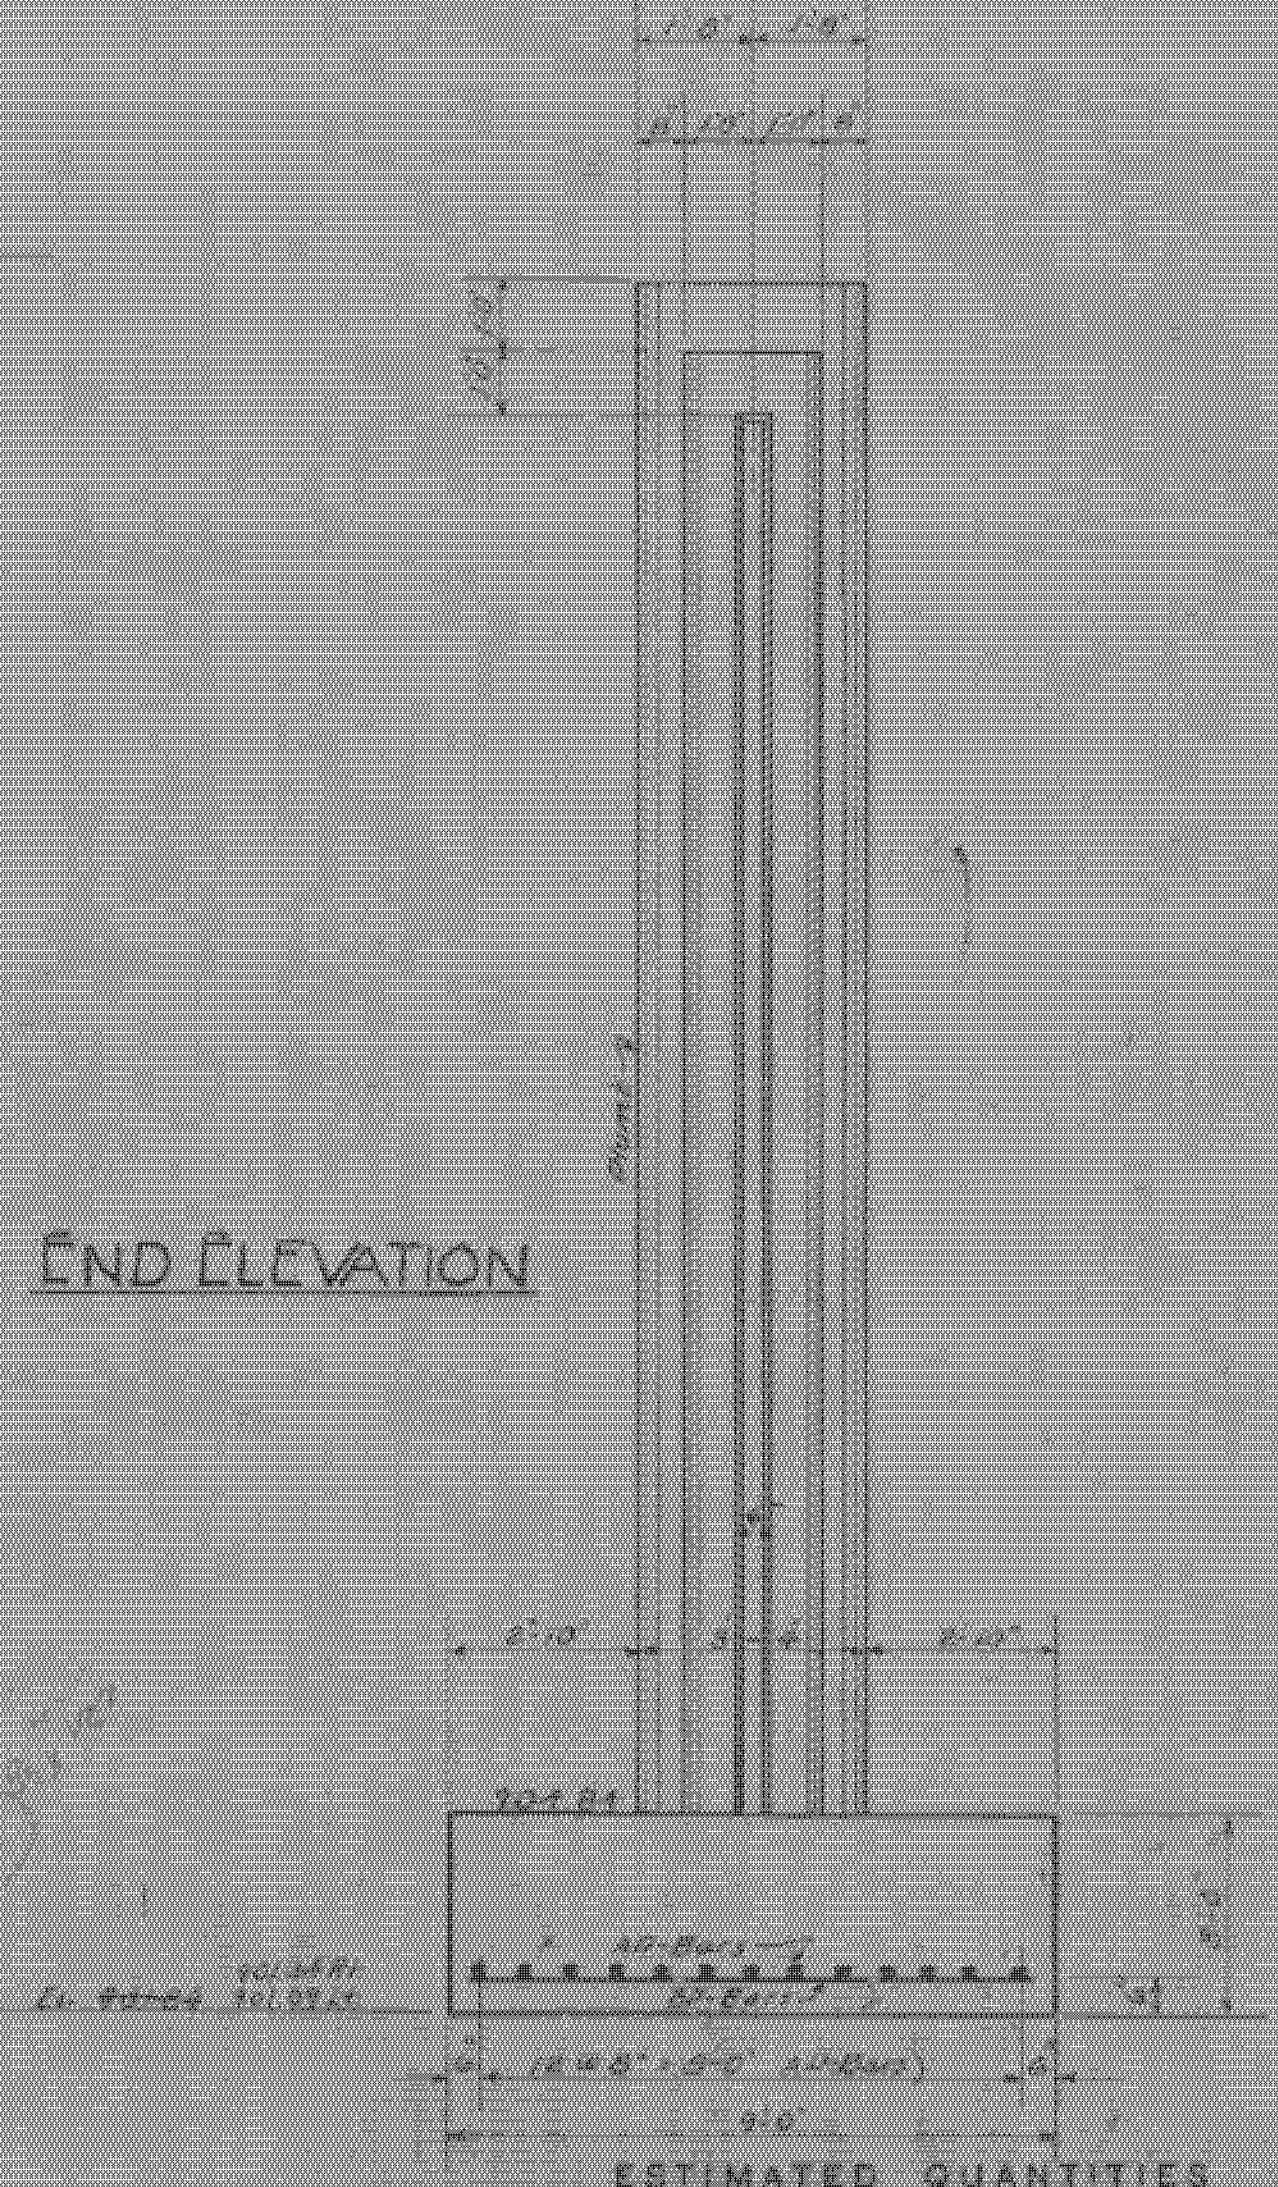

END ELEVATION



SECTION A

FOR REFERENCE ONLY  
 Bennington  
 BHF 010-2(21)S  
 Sheet BR127 of  
 DETAILS OF DIER 2  
 FURNACE BRIDGE,  
 BENNINGTON, VT.  
 Scale 3/4"=1'-0"

ESTIMATED QUANTITIES

Structure Excavation	100.00	1127
Concrete Class A	100.00	1127
Reinforcing Steel	100.00	10300

Checked by J. H. G. 2-29-45  
 Designed by J. H. G.  
 Drawn by J. H. G.  
 Tested by J. H. G.  
 Constructed by C. H. B.  
 Survey F&M No. 1000(1) 1945  
 Date 11-1-45