

**Record Plans**

Contractor: KUBRICKY CONSTRUCTION, INC.  
 Resident Engineer: JOHN SLADYK  
 Construction Began: 08/24/2016  
 Construction Complete: 12/06/2017  
 Record Plans By: JOHN SLADYK & RYAN CORKINS


I hereby certify that all construction required by this set of drawings has been accomplished as indicated herein.

BY: John N Sladyk Resident Engineer


Date: 05-20-2020

NOTE: Any further information concerning final quantities, amounts or other details relative to this project may be found at Central Files in the electronic archives.

# STATE OF VERMONT AGENCY OF TRANSPORTATION

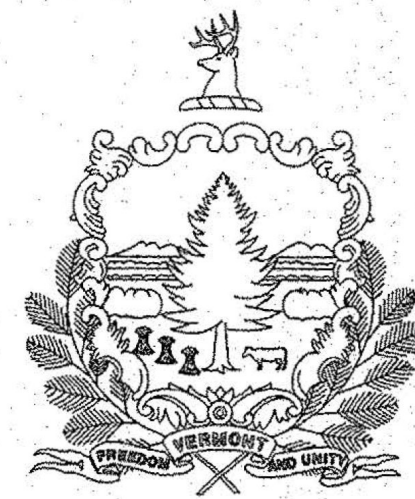



## PROPOSED IMPROVEMENT TOWNS OF BERLIN AND BARRE TOWN COUNTY OF WASHINGTON VT ROUTE 63 - MINOR ARTERIAL TOWNS OF NORTHFIELD & WILLIAMSTOWN COUNTY OF WASHINGTON & ORANGE VT ROUTE 64 - MAJOR COLLECTOR TOWN OF BROOKFIELD COUNTY OF ORANGE VT ROUTE 65 - MINOR COLLECTOR

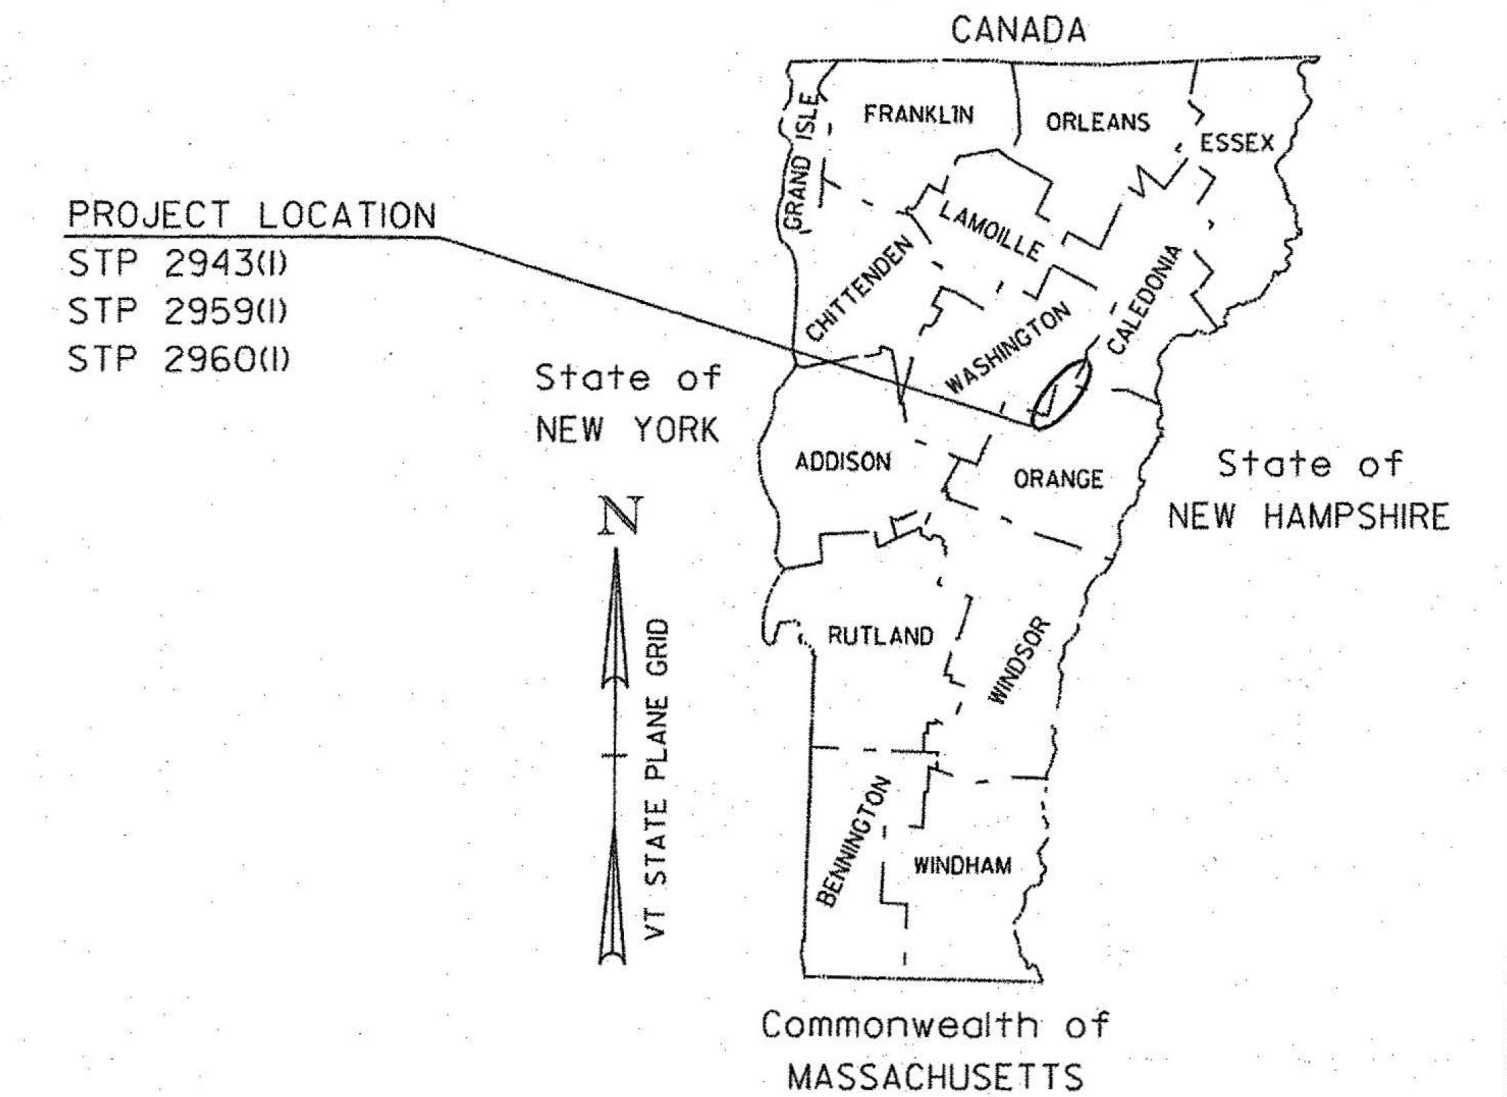

**BERLIN - BARRE TOWN**  
 STP 2943(I)  
 VT 63  
 (SEE SHEET 14 OF 197)

**NORTHFIELD - WILLIAMSTOWN**  
 STP 2959(I)  
 VT 64  
 (SEE SHEET 71 OF 197)

**BROOKFIELD**  
 STP 2960(I)  
 VT 65  
 (SEE SHEET 143 OF 197)

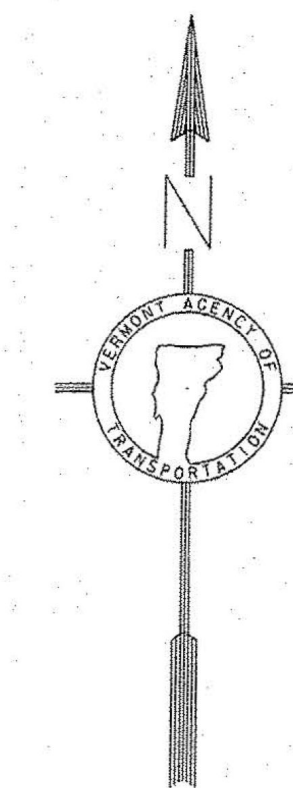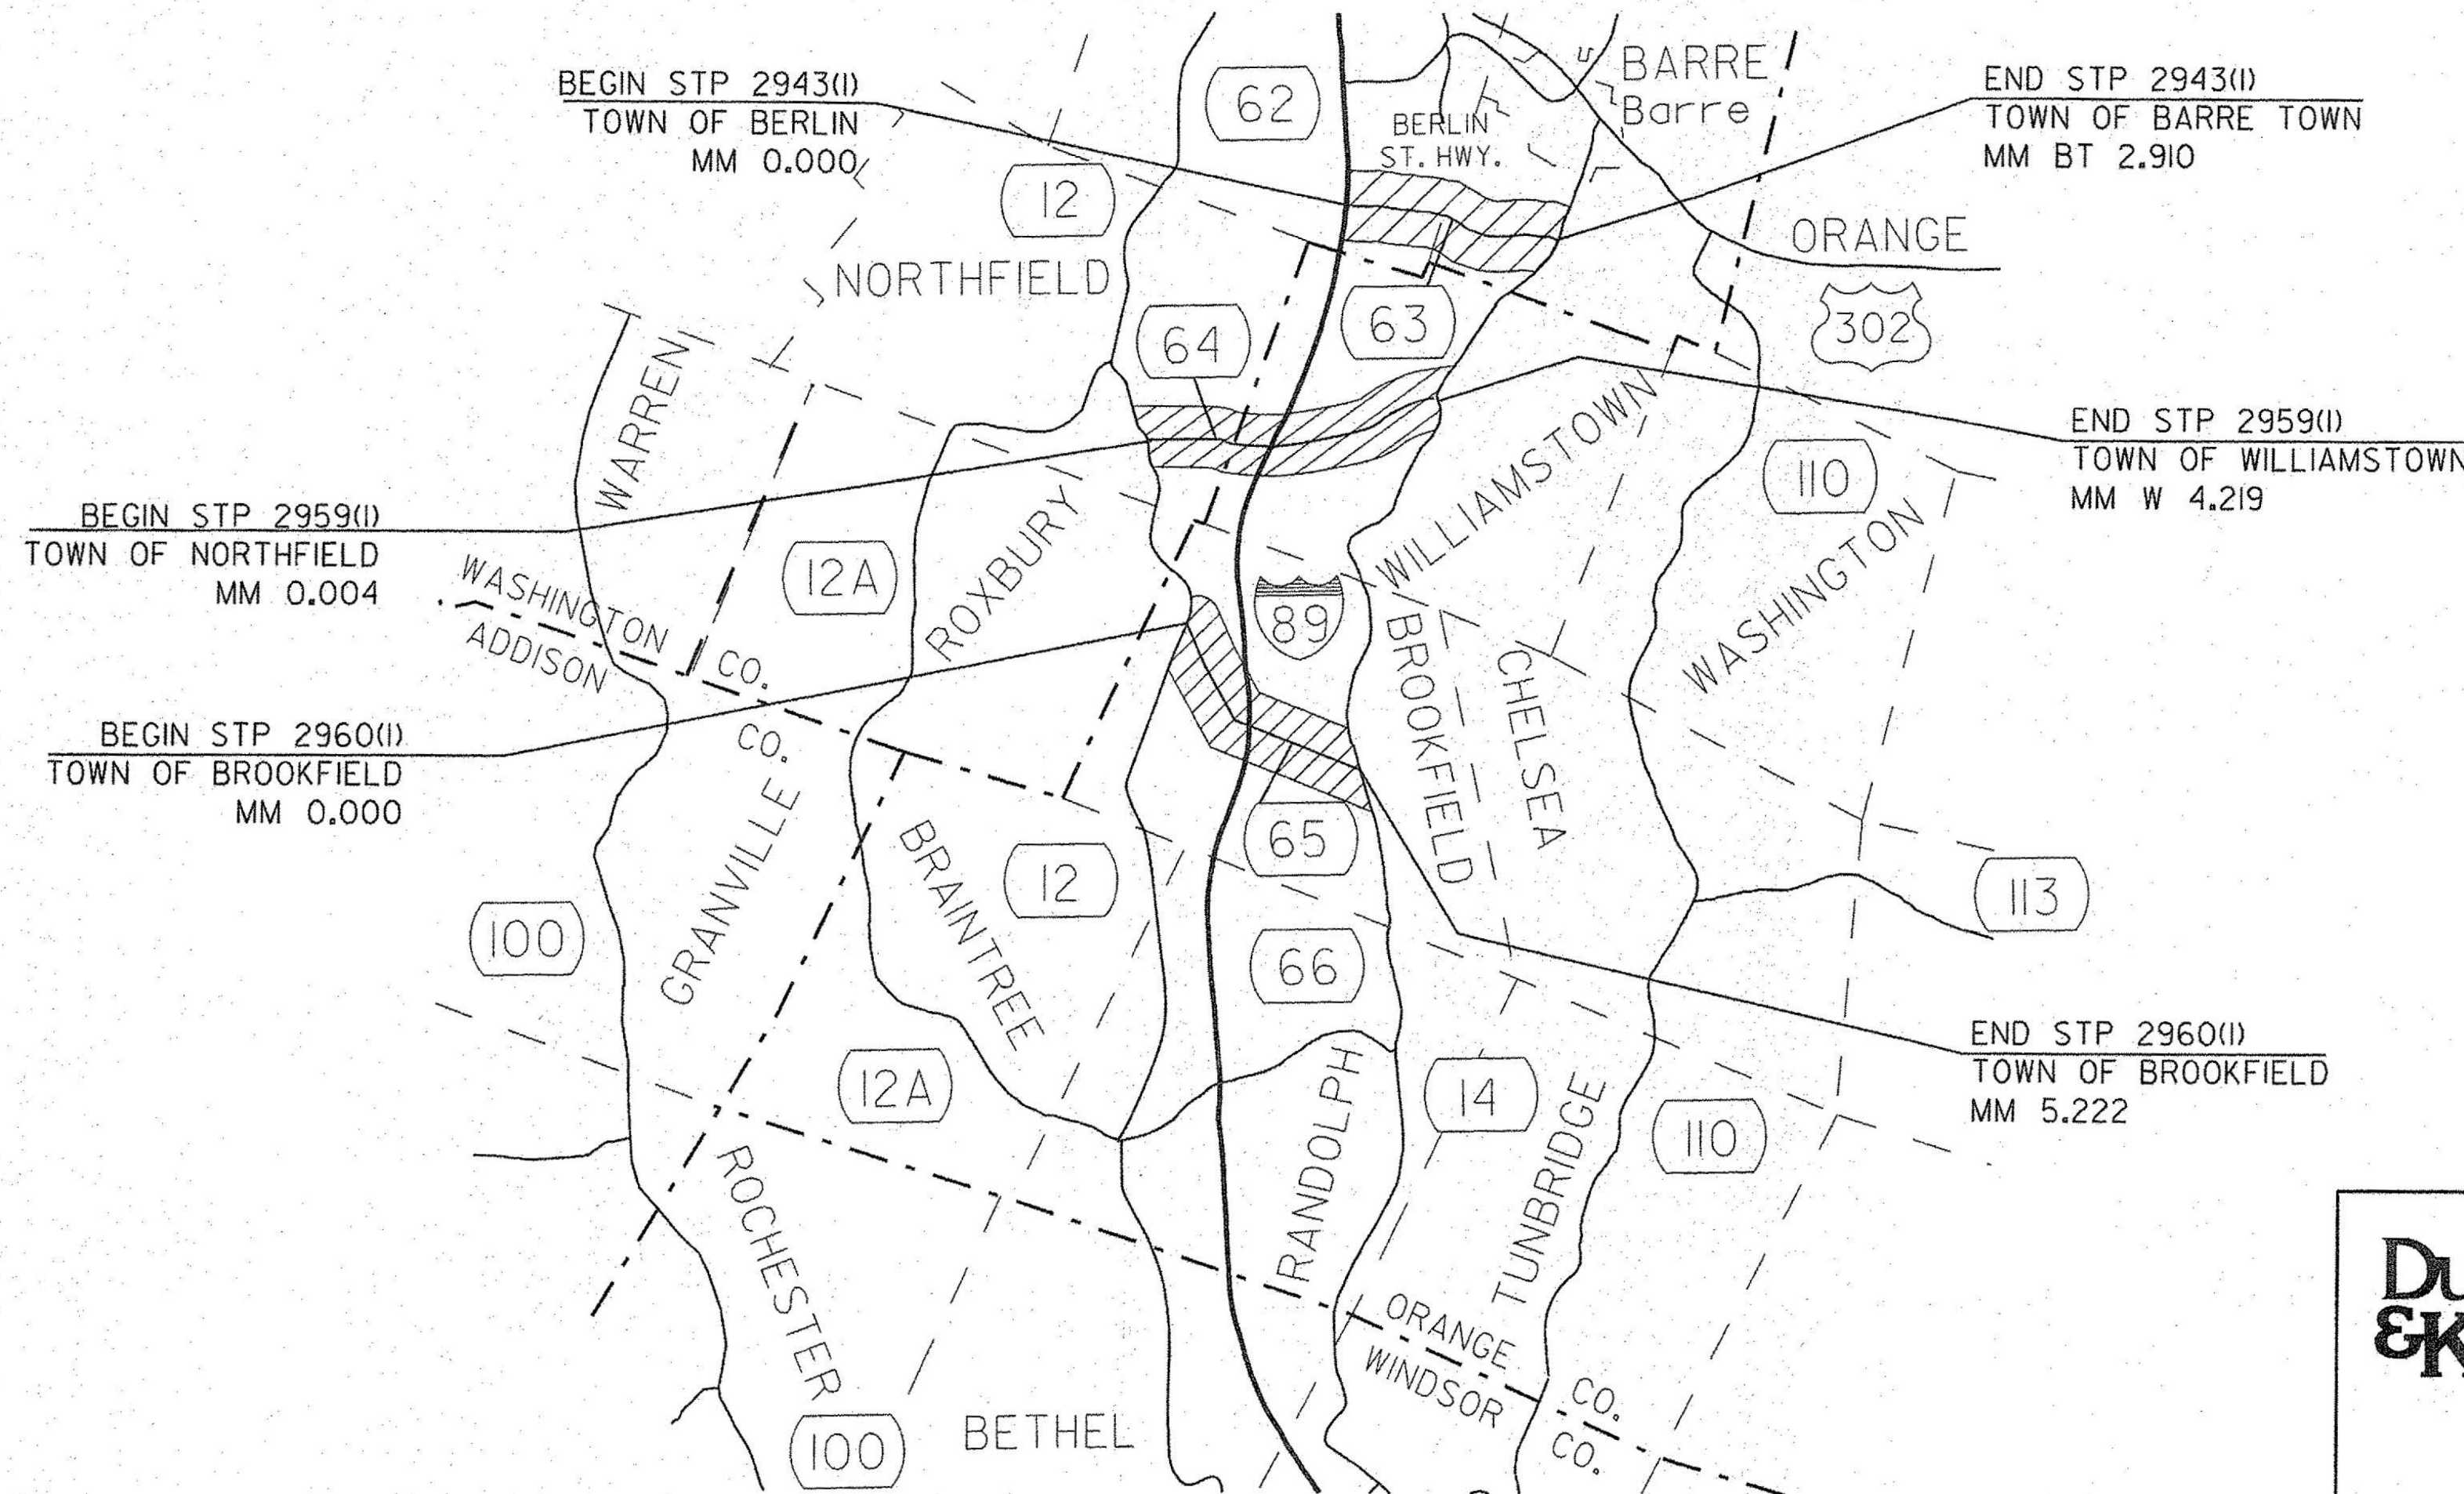


CONSTRUCTION IS TO BE CARRIED ON IN ACCORDANCE WITH THESE PLANS AND THE STANDARD SPECIFICATIONS FOR CONSTRUCTION DATED 2011, AS APPROVED BY THE FEDERAL HIGHWAY ADMINISTRATION ON JULY 20, 2011 FOR USE ON THIS PROJECT, INCLUDING ALL SUBSEQUENT REVISIONS AND SUCH REVISED SPECIFICATIONS AND SPECIAL PROVISIONS AS ARE INCORPORATED IN THESE PLANS.

QUALITY ASSURANCE PROGRAM : LEVEL 3
SURVEYED BY : N/A
SURVEYED DATE : N/A
DATUM
VERTICAL : NAVD 88
HORIZONTAL : NAD 83 (2011)

NOT TO SCALE

**DuBois & King**  
 INC.

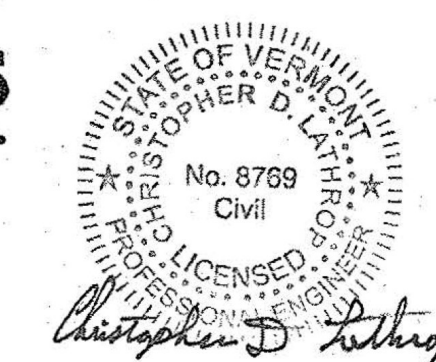

DIRECTOR OF PROJECT DELIVERY
APPROVED: <u>J.A.R.</u> DATE <u>4/27/2010</u>
PROJECT MANAGER : JONATHAN C. HARRINGTON, P. E.
PROJECT NAME : BERLIN-BARRE TOWN/NORTHFIELD-WILLIAMSTOWN/BROOKFIELD
PROJECT NUMBER : STP 2943 (I) / STP 2959 (I) / STP 2960 (I)
SHEET 1 OF 202 SHEETS