

CLEARING AND GRUBBING
(INCLUDING INDIVIDUAL TREES AND STUMPS)
MM 0.028 - MM 0.078 RT

REMOVAL AND DISPOSAL OF GUARDRAIL
MM 0.024 - MM 0.030 LT & RT


MANUFACTURED TERMINAL SECTION, FLARED
MM 0.053 - MM 0.060 RT
MM 0.060 - MM 0.069 LT
MM 0.089 - MM 0.097 RT
MM 0.097 - MM 0.100 LT

STEEL BEAM GUARDRAIL, GALVANIZED
MM 0.024 - MM 0.060 LT
MM 0.024 - MM 0.053 RT
MM 0.097 - MM 0.100 RT

DURABLE 6 INCH WHITE LINE (SEE OPTION ITEMS) & TEMPORARY 6 INCH WHITE LINE, PAINT
MM 0.000 - MM 0.100 (SOLID LT & RT EDGE LINES)

DURABLE 6 INCH YELLOW LINE (SEE OPTION ITEMS) & TEMPORARY 6 INCH YELLOW LINE, PAINT
MM 0.000 - MM 0.100 (SOLID LT & RT)

DURABLE LETTER OR SYMBOL (SEE OPTION ITEMS) & TEMPORARY LETTER OR SYMBOL, PAINT
MM 0.083 RT (THROUGH ARROW)

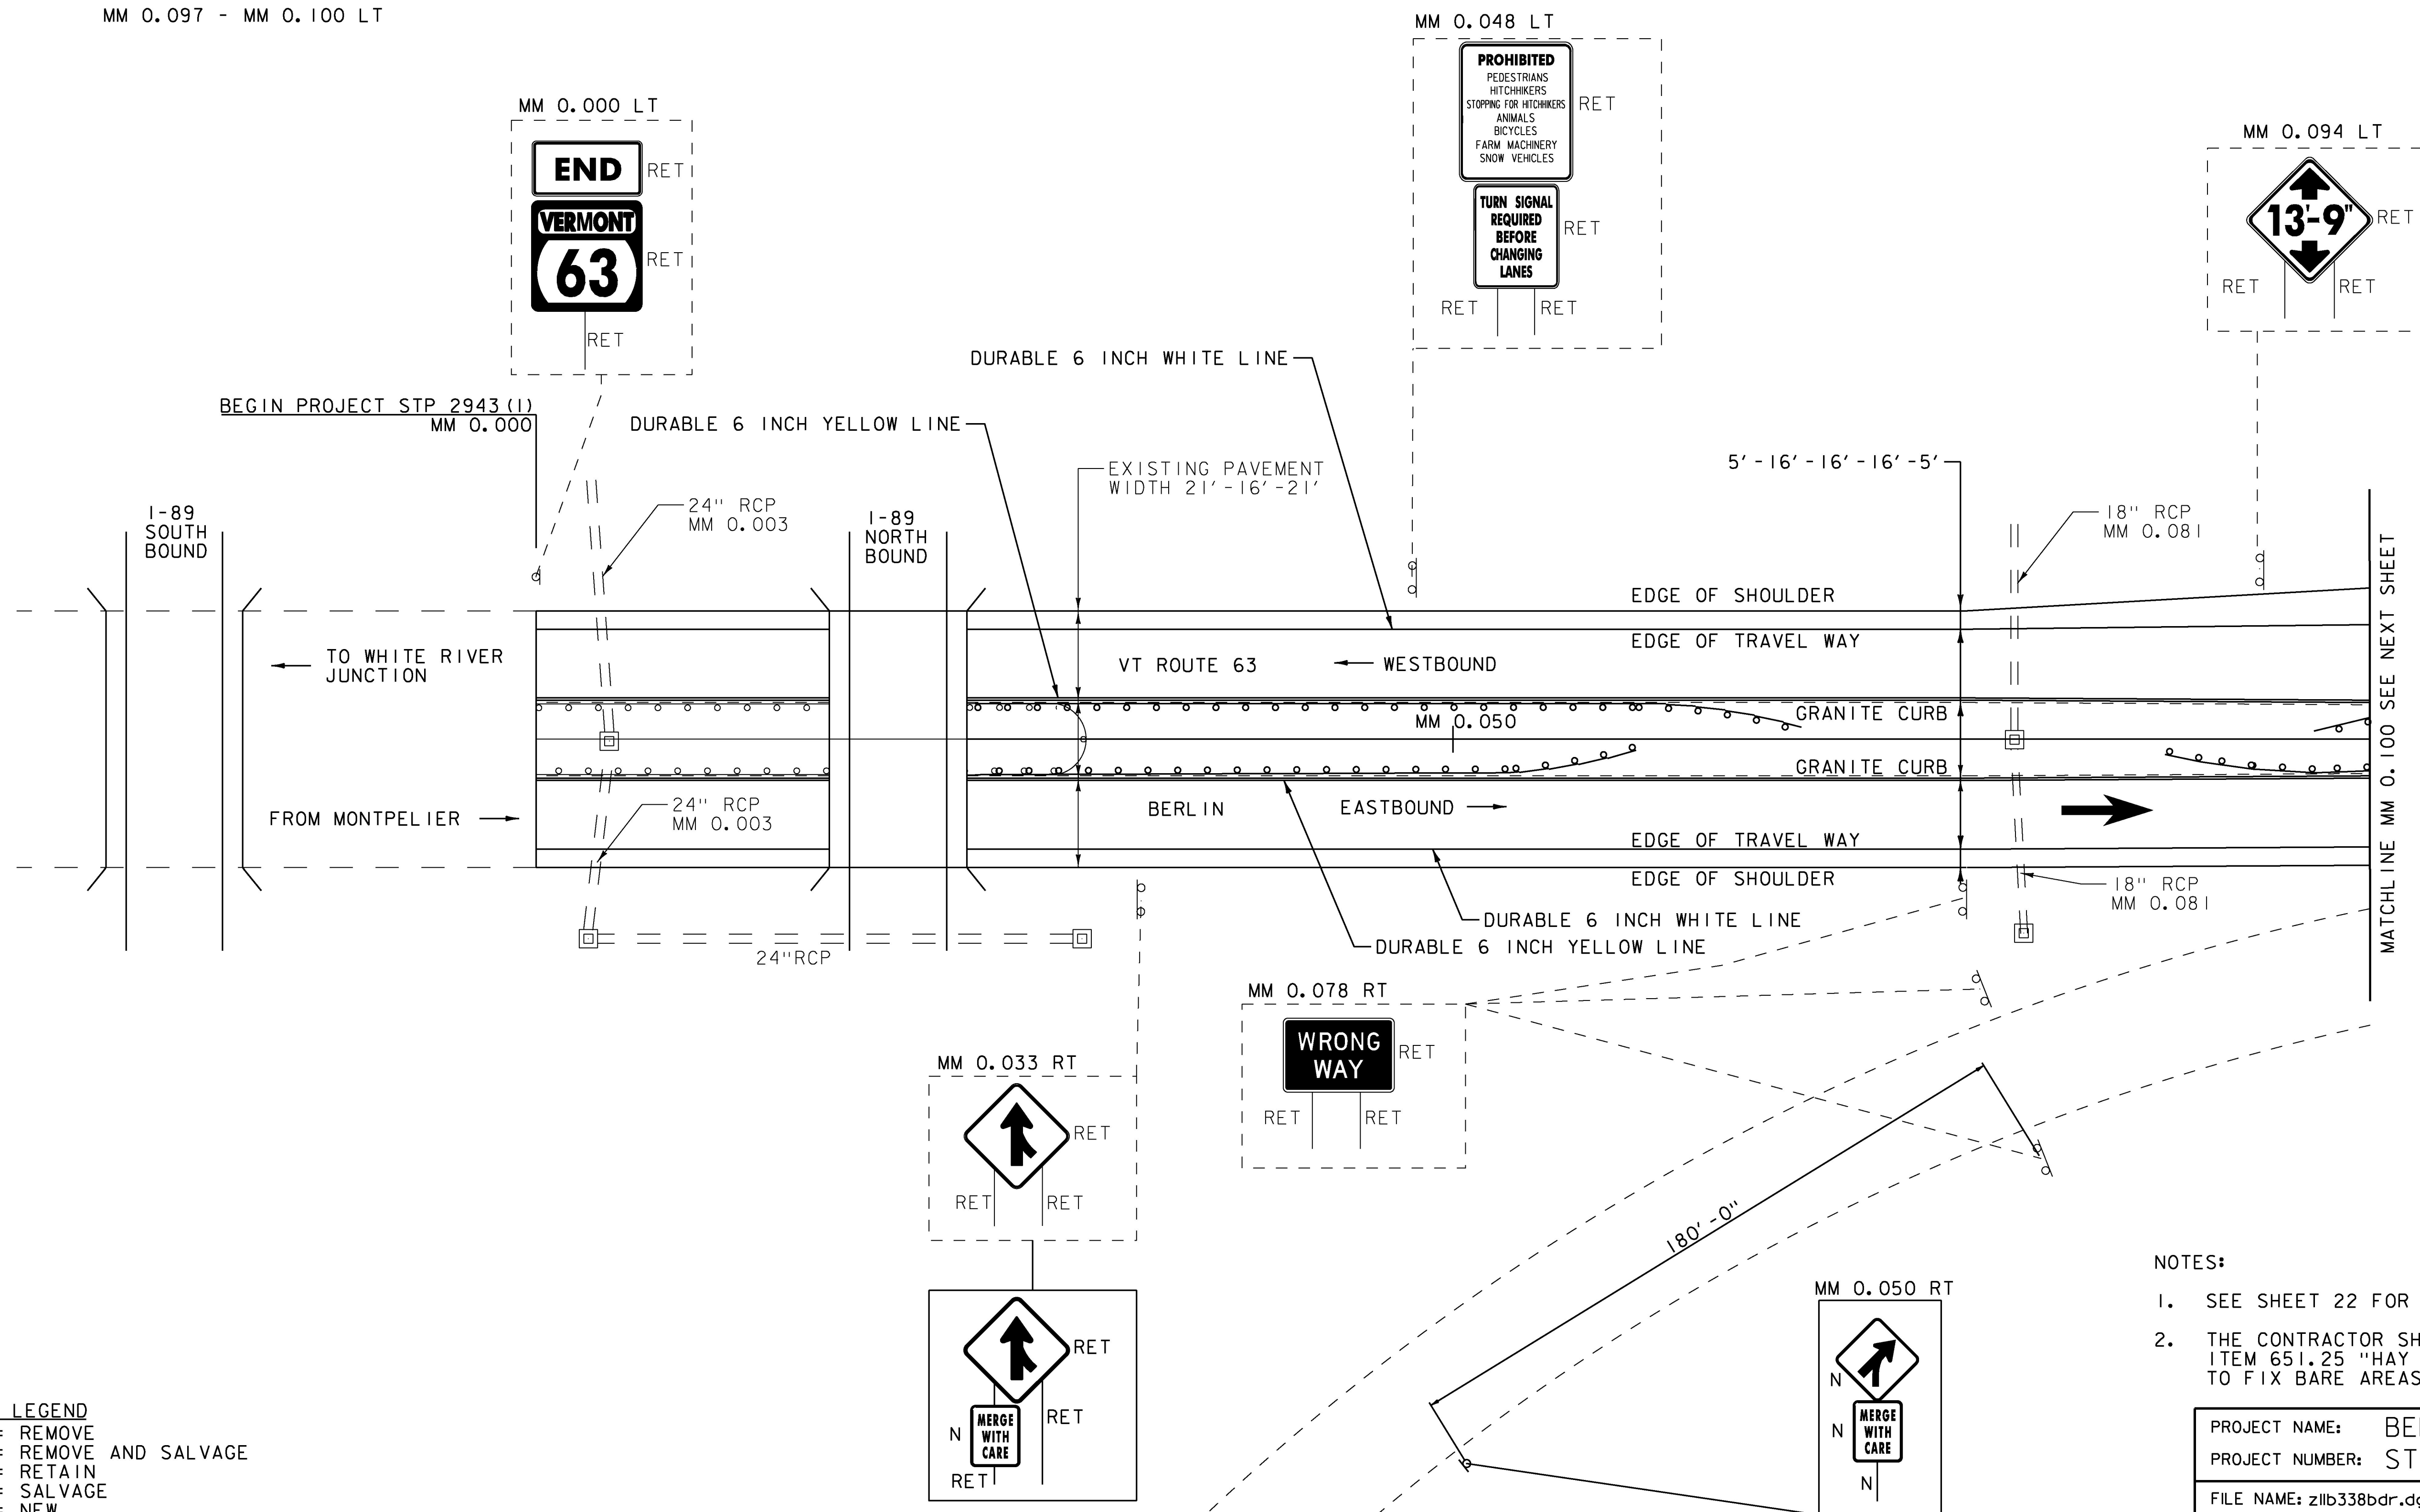

SIGN LEGEND
R = REMOVE
R&S = REMOVE AND SALVAGE
RET = RETAIN
S = SALVAGE
N = NEW
B-B = BACK TO BACK
- - = EXISTING
— = NEW

NOTES:

- SEE SHEET 22 FOR MEDIAN RAIL DETAILS
- THE CONTRACTOR SHALL PLACE ITEM 651.15 "SEED", ITEM 651.25 "HAY MULCH", AND ITEM 651.35 "TOPSOIL" TO FIX BARE AREAS INSIDE EXISTING BULLNOSE AREA.

PROJECT NAME:	BERLIN-BARRE TOWN
PROJECT NUMBER:	STP 2943(I)
FILE NAME:	z11b338bdr.dgn
PROJECT LEADER:	C. LATHROP
DESIGNED BY:	S. SOLLA
PLAN SHEET I	
PLOT DATE:	4/26/2016
DRAWN BY:	O. DALMER
CHECKED BY:	C. LATHROP
SHEET	29 OF 202

NOT TO SCALE