

MILLED RUMBLE STRIPS (CENTERLINE)
MM 0.300 - MM 0.600 CTR

STEEL BEAM GUARDRAIL, GALVANIZED
MM 0.300 - MM 0.320 RT
MM 0.537 - MM 0.600 RT 0.568

STEEL BEAM GUARDRAIL, W/8FT POST
MM 0.568 - 0.600 RT
ANCHOR FOR STEEL BEAM RAIL
MM 0.320 RT
MM 0.537 RT


REMOVAL AND DISPOSAL OF GUARDRAIL
MM 0.300 - MM 0.320 RT
MM 0.537 - MM 0.600 RT

DURABLE 4 INCH WHITE LINE (SEE OPTION ITEMS) &
TEMPORARY 4 INCH WHITE LINE, PAINT
MM 0.300 - MM 0.600 (SOLID LT & RT)
MM 0.300 - MM 0.600 (DASHED LANE LINE/RT)

DURABLE 4 INCH YELLOW LINE (SEE OPTION ITEMS) &
TEMPORARY 4 INCH YELLOW LINE, PAINT
MM 0.300 - MM 0.600 (SOLID LT & RT)

REMOVING SIGNS (TYPE A)
AS SHOWN - 6

DURABLE LETTER OR SYMBOL (SEE OPTION ITEMS) &
TEMPORARY LETTER OR SYMBOL, PAINT
MM 0.323 LT (AHEAD)
MM 0.331 LT (STOP)

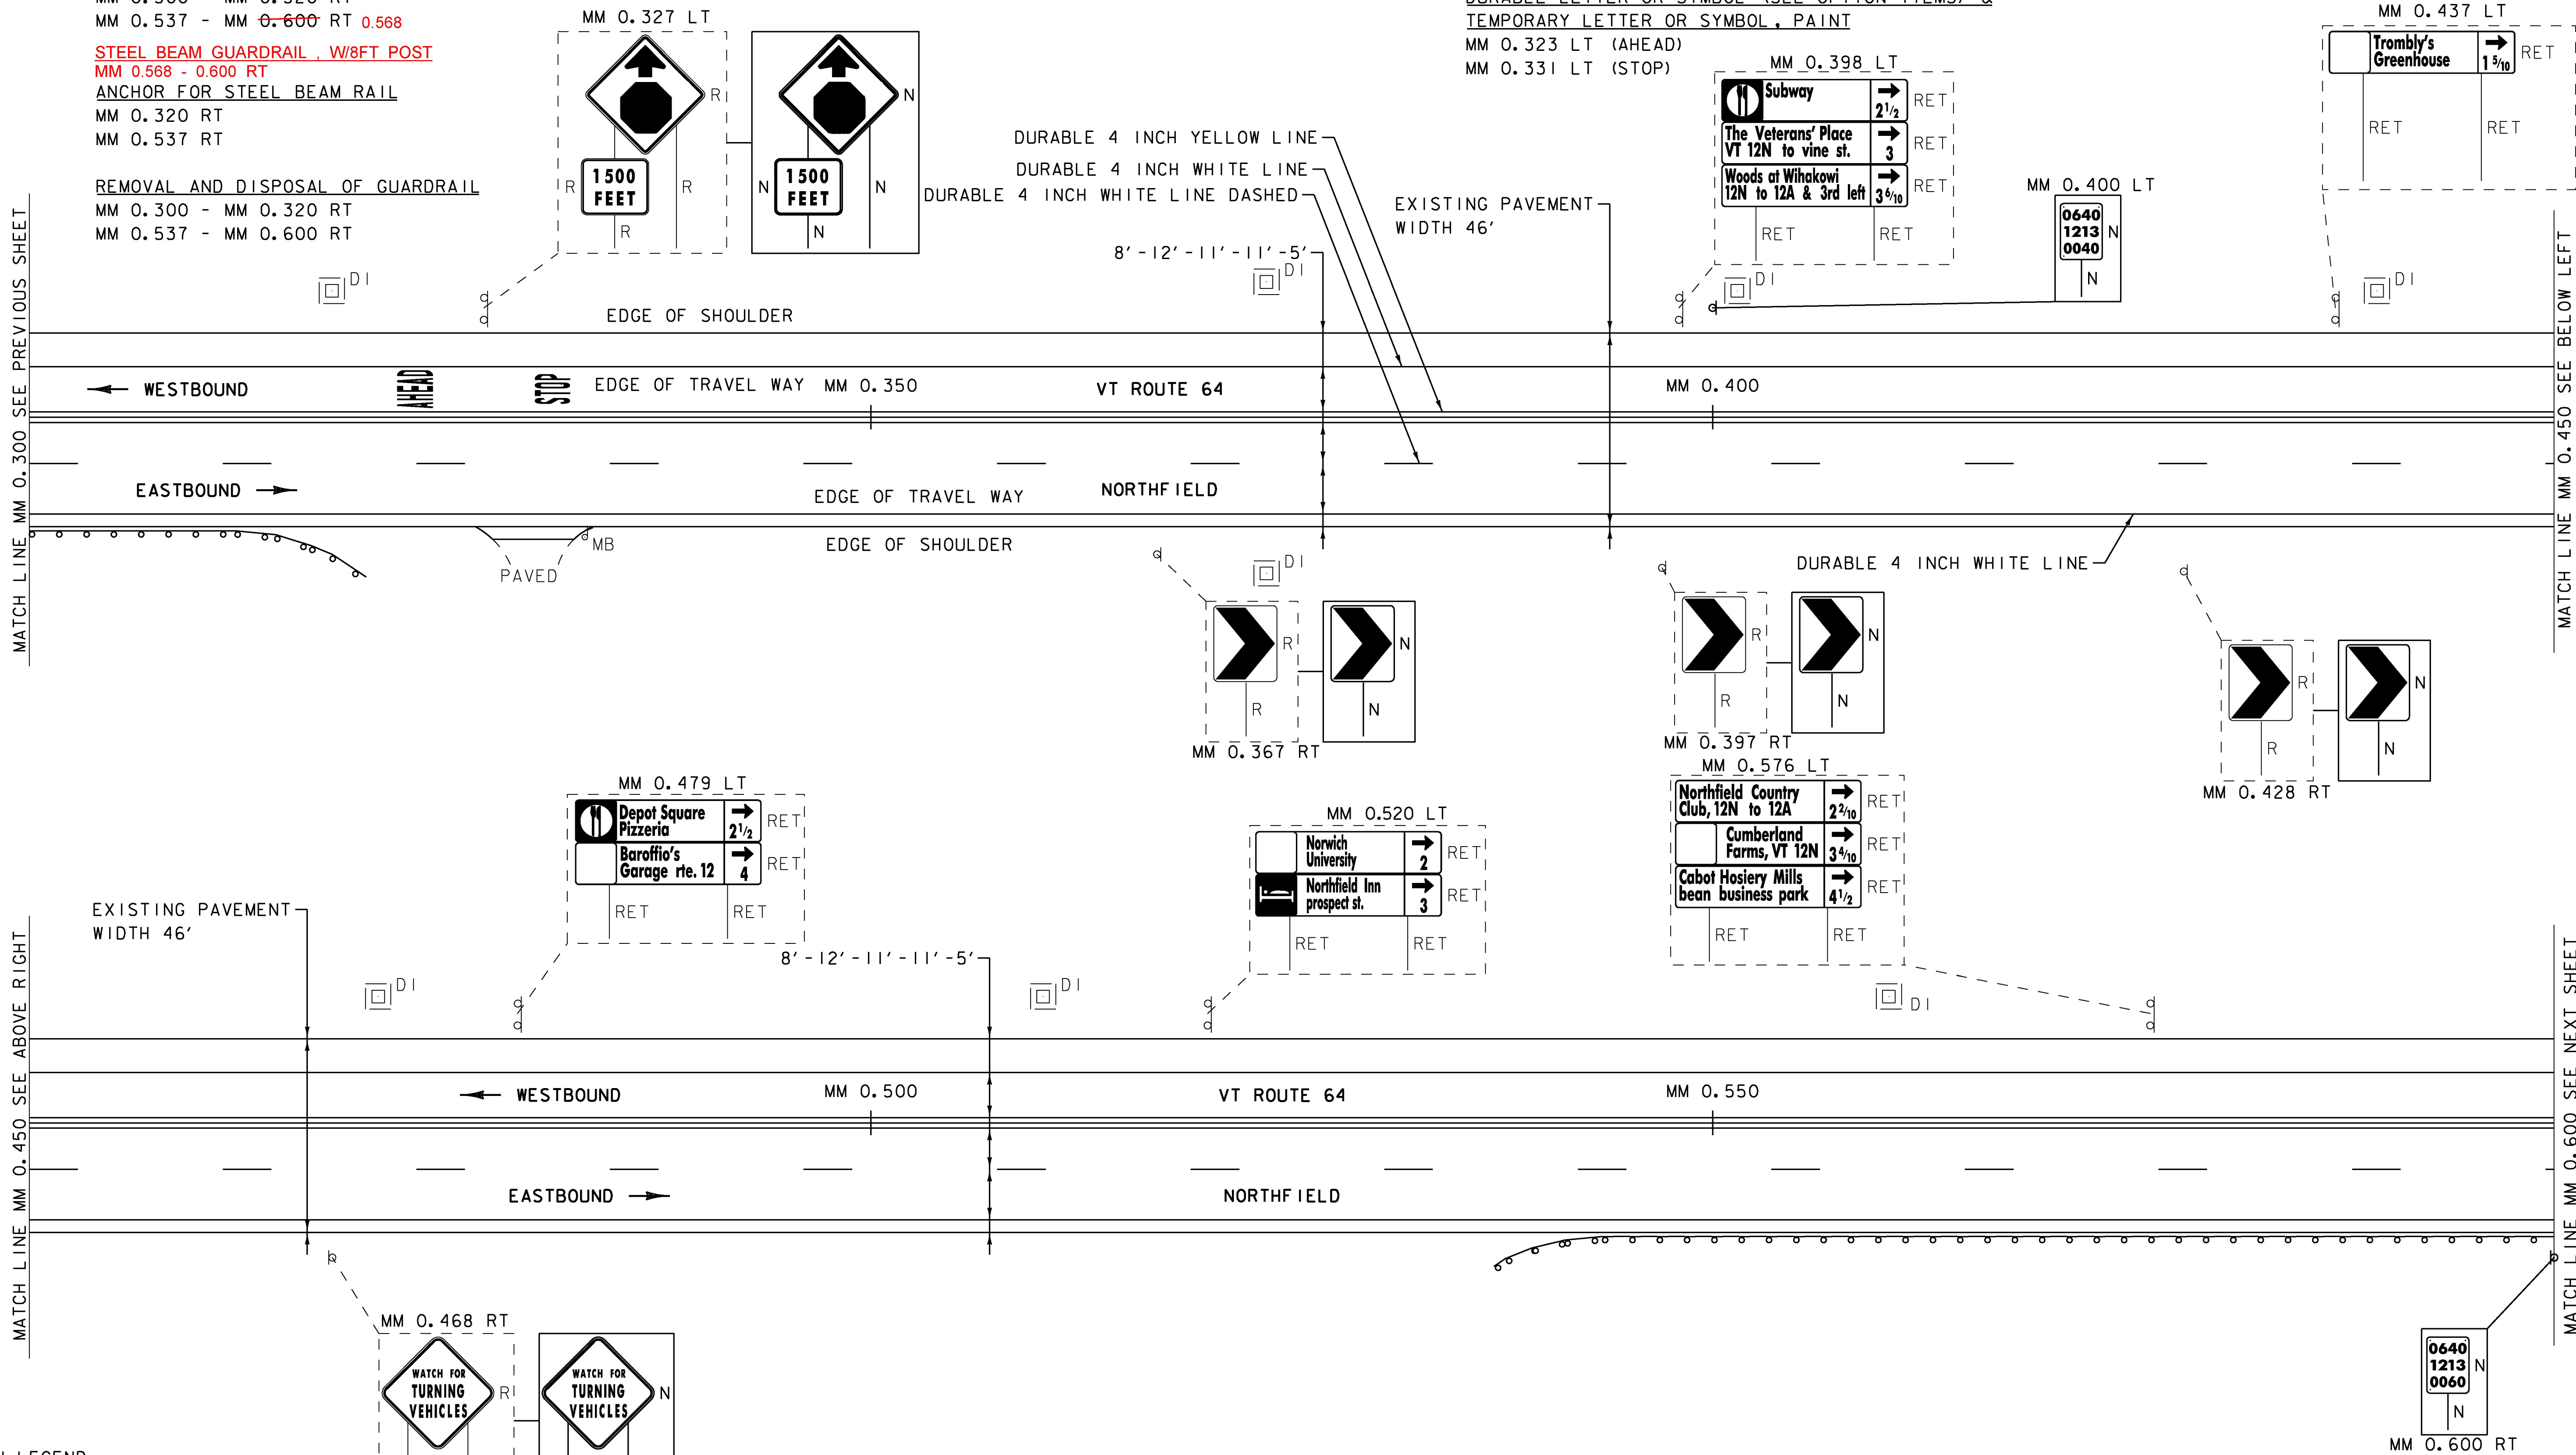

SIGN LEGEND
R = REMOVE
R&S = REMOVE AND SALVAGE
RET = RETAIN
S = SALVAGE
N = NEW
B-B = BACK TO BACK
- - = EXISTING
— = NEW

NOT TO SCALE

PROJECT NAME: NORTHFIELD-WILLIAMSTOWN	
PROJECT NUMBER: STP 2959(I)	
FILE NAME: z15v022bdr.dgn	PLOT DATE: 4/26/2016
PROJECT LEADER: C. LATHROP	DRAWN BY: J. GOODALL
DESIGNED BY: J. GOODALL	CHECKED BY: C. LATHROP
PLAN SHEET 3	SHEET 93 OF 202