



MILLED RUMBLE STRIPS (CENTERLINE)
MM 0.600 - MM 0.900 CTR

STEEL BEAM GUARDRAIL, GALVANIZED
0.698 MM 0.600 - MM 0.900 RT
STEEL BEAM GUARDRAIL, W/8FT POSTS
MM 0.600 - 0.698 RT
REMOVAL AND DISPOSAL OF GUARDRAIL
MM 0.600 - MM 0.900 RT

DURABLE 4 INCH WHITE LINE (SEE OPTION ITEMS) &
TEMPORARY 4 INCH WHITE LINE, PAINT
MM 0.600 - MM 0.900 (SOLID LT & RT)
MM 0.600 - MM 0.900 (DASHED LANE LINE/RT)

DURABLE 4 INCH YELLOW LINE (SEE OPTION ITEMS) &
TEMPORARY 4 INCH YELLOW LINE, PAINT
MM 0.600 - MM 0.900 (SOLID LT & RT)

REMOVING SIGNS (TYPE A)
AS SHOWN - 3
REMOVING SIGNS (TYPE B)
AS SHOWN - 1

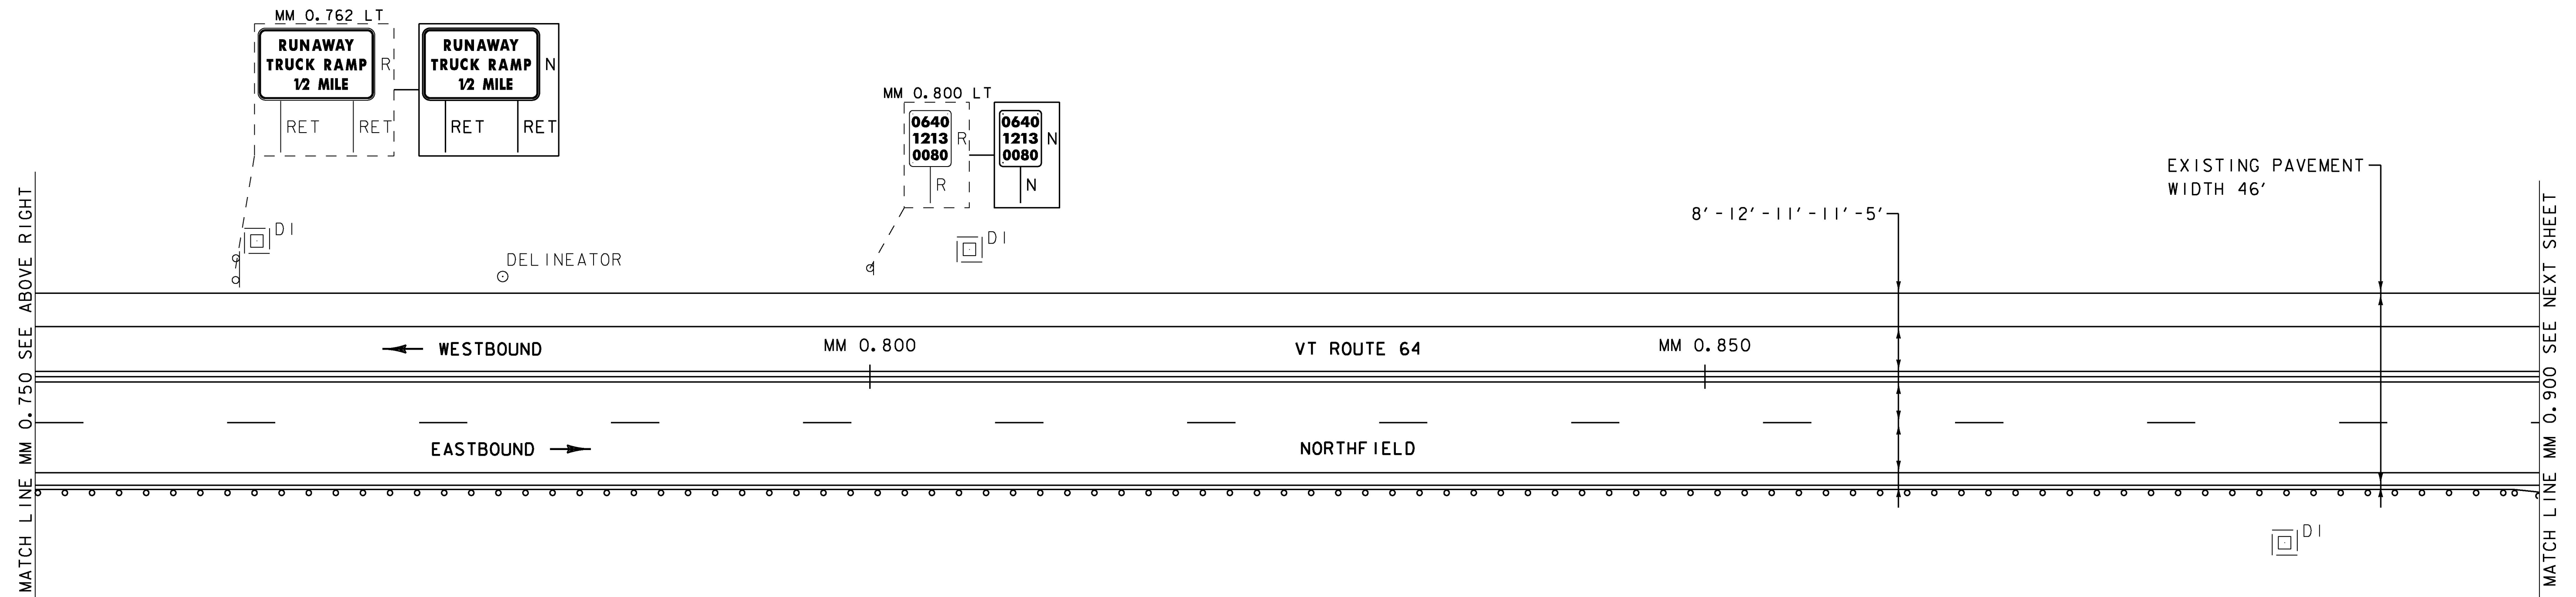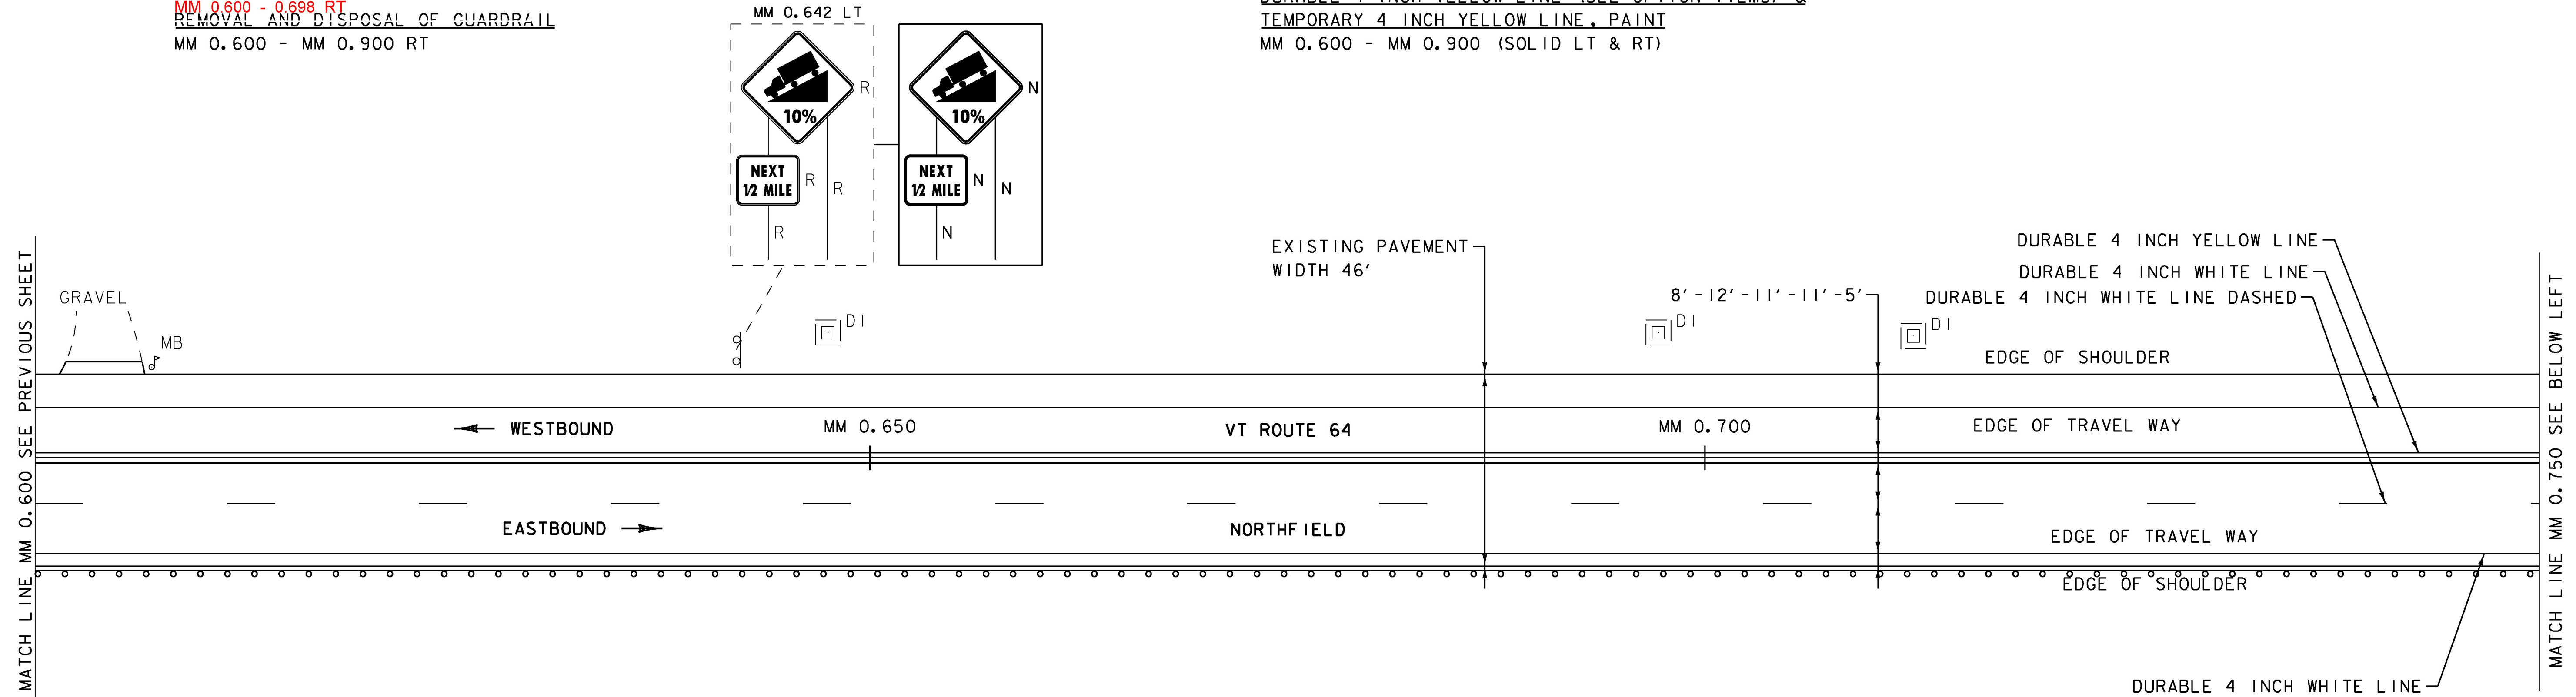

SIGN LEGEND
R = REMOVE
R&S = REMOVE AND SALVAGE
RET = RETAIN
S = SALVAGE
N = NEW
B-B = BACK TO BACK
- - = EXISTING
— = NEW

NOT TO SCALE

PROJECT NAME:	NORTHFIELD-WILLIAMSTOWN
PROJECT NUMBER:	STP 2959(I)
FILE NAME:	z15v022bdr.dgn
PROJECT LEADER:	C. LATHROP
DESIGNED BY:	J. GOODALL
PLAN SHEET 4	
PLOT DATE:	4/26/2016
DRAWN BY:	J. GOODALL
CHECKED BY:	C. LATHROP
SHEET	94 OF 202