

MILLED RUMBLE STRIPS (CENTERLINE)
 MM 2.400 - MM 2.478 CTR
 MM 2.492 - MM 2.551 CTR
 MM W 0.000 - MM W 0.150 CTR

STEEL BEAM GUARDRAIL, GALVANIZED
 MM 2.400 - MM 2.465 RT
 MM 2.454 - MM 2.483 LT

ANCHOR FOR STEEL BEAM RAIL
 MM 2.454 LT
 MM 2.463 RT
 MM 2.475 LT

REMOVAL AND DISPOSAL OF GUARDRAIL
 MM 2.400 - MM 2.447 RT
 MM 2.454 - MM 2.483 LT


DURABLE 4 INCH WHITE LINE (SEE OPTION ITEMS) & TEMPORARY 4 INCH WHITE LINE, PAINT
 MM 2.400 - MM 2.551 (SOLID LT & RT)
 (WITH EDGE LINE BREAKS AT TH#4)
 MM 2.485 (EDGE LINES AT TH#4)
 MM W 0.000 - MM W 0.150 (SOLID LT & RT)
 MM W 0.101 LT (HATCH) (PARK AND RIDE)
 MM W 0.107 - MM W 0.131 LT (PARKING LT) (PARK AND RIDE)
 MM W 0.110 LT (HATCH) (PARK AND RIDE)
 MM W 0.111 - MM W 0.129 LT (PARKING LT) (PARK AND RIDE)

DURABLE 4 INCH YELLOW LINE (SEE OPTION ITEMS) & TEMPORARY 4 INCH YELLOW LINE, PAINT
 MM 2.400 - MM 2.439 (DASHED LT, SOLID RT)
 MM 2.439 - MM 2.551 (SOLID LT & RT)
 (WITH CENTERLINE BREAK AT TH#4)
 MM 2.485 (CENTERLINE AT TH#4)
 MM W 0.000 - MM W 0.150 (SOLID LT & RT)
 MM W 0.108 LT (CENTERLINE AT PARK AND RIDE)



DURABLE 24 INCH STOP BAR (SEE OPTION ITEMS) & TEMPORARY 24 INCH STOP BAR, PAINT
 MM 2.483 LT (TH#4)
 MM W 0.106 LT (PARK AND RIDE)

DURABLE LETTER OR SYMBOL (SEE OPTION ITEMS) & TEMPORARY LETTER OR SYMBOL, PAINT
 MM 2.483 LT (STOP) (TH#4)
 MM W 0.106 LT (STOP) (PARK AND RIDE)
 MM W 0.108 LT (HANDICAP) (PARK AND RIDE)
 MM W 0.111 LT (HANDICAP) (PARK AND RIDE)

REMOVING SIGNS (TYPE A)
 AS SHOWN - 11

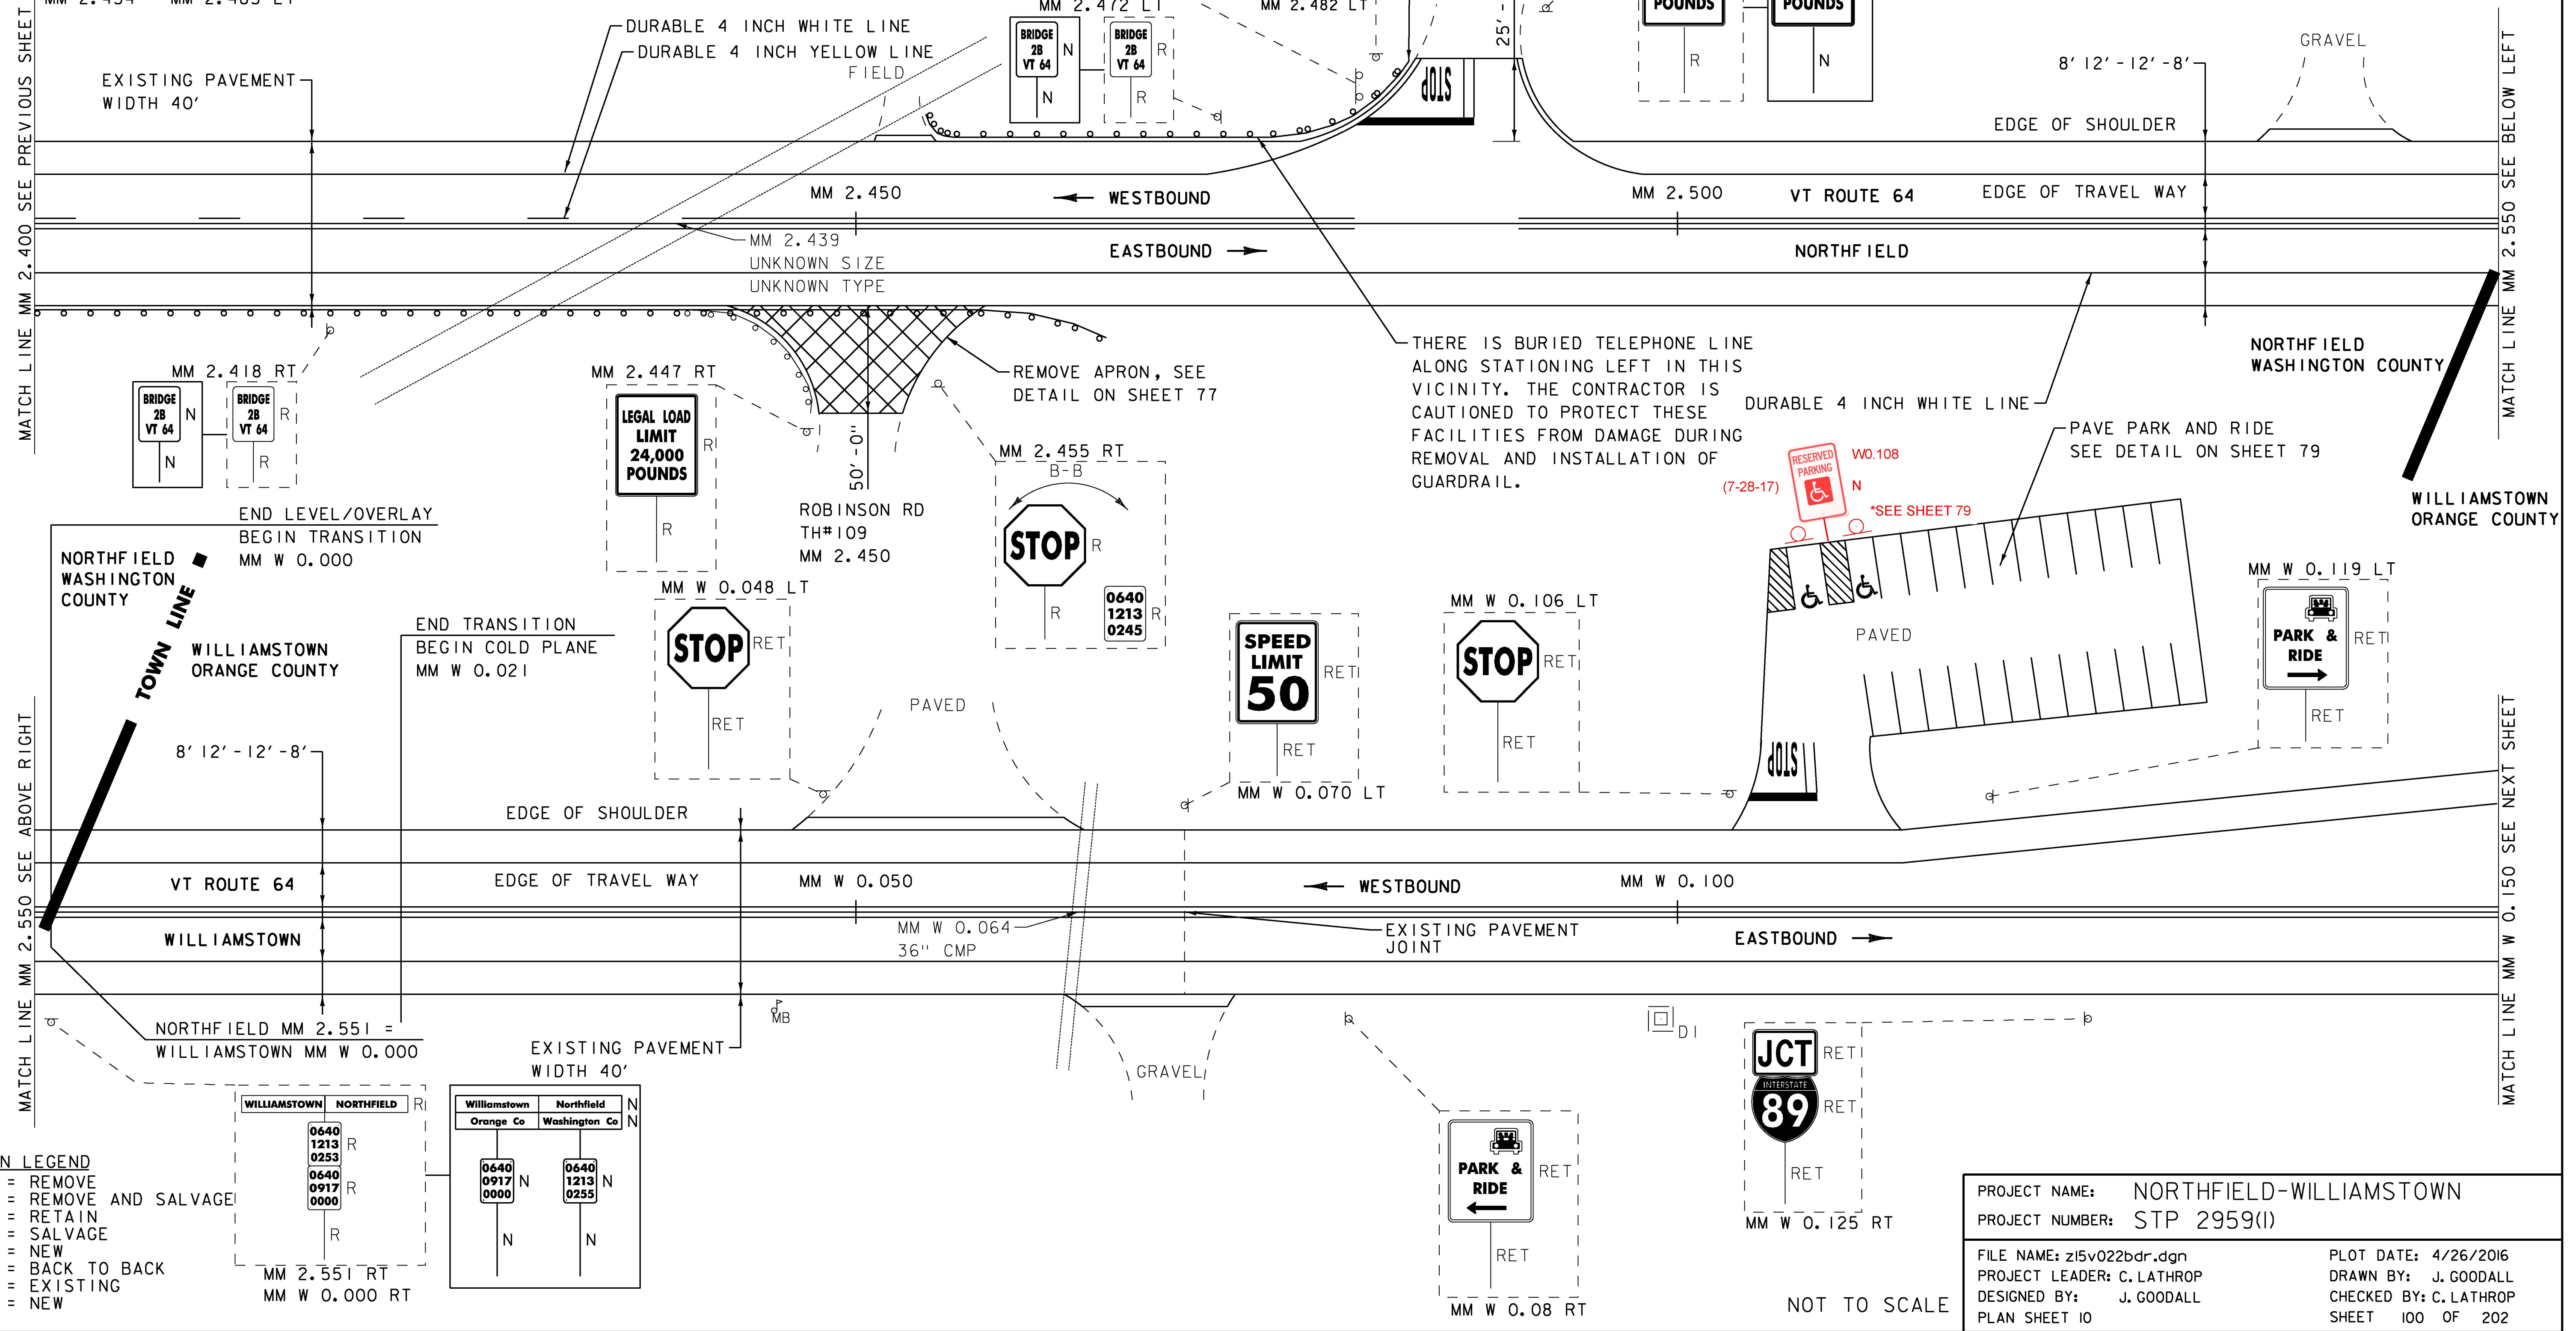

SIGN LEGEND
 R = REMOVE
 R&S = REMOVE AND SALVAGE
 RET = RETAIN
 S = SALVAGE
 N = NEW
 B-B = BACK TO BACK
 - - - = EXISTING
 — = NEW

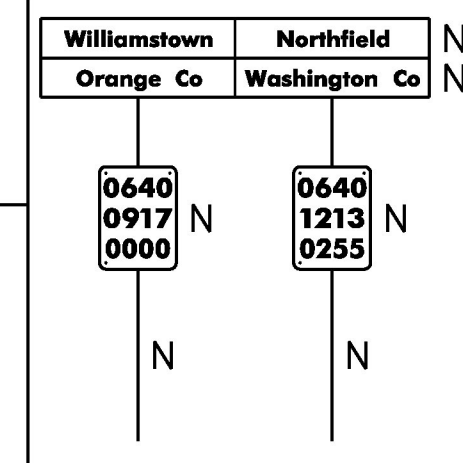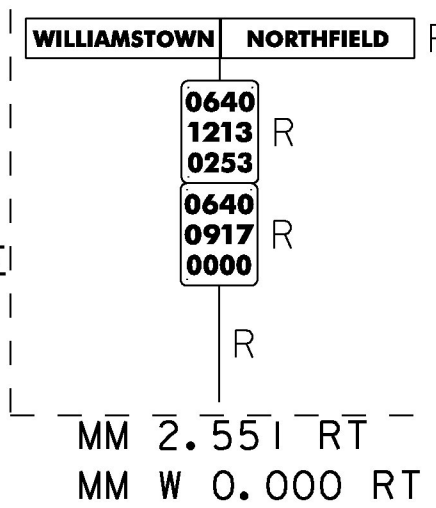

PROJECT NAME: NORTHFIELD-WILLIAMSTOWN
PROJECT NUMBER: STP 2959(I)
FILE NAME: z15v022bdr.dgn
PROJECT LEADER: C. LATHROP
DESIGNED BY: J. GOODALL
PLAN SHEET 10

PLOT DATE: 4/26/2016
DRAWN BY: J. GOODALL
CHECKED BY: C. LATHROP
SHEET 100 OF 202

NOT TO SCALE