

STEEL BEAM GUARDRAIL, GALVANIZED
 MM W 0.397 - MM W 0.450 LT
 MM W 0.436 - MM W 0.450 RT

ANCHOR FOR STEEL BEAM RAIL
 MM 0.436 RT

REMOVAL AND DISPOSAL OF GUARDRAIL
 MM W 0.397 - MM W 0.450 LT
 MM W 0.436 - MM W 0.450 RT


DURABLE 4 INCH WHITE LINE (SEE OPTION ITEMS) & TEMPORARY 4 INCH WHITE LINE, PAINT
 MM W 0.300 - MM W 0.450 (SOLID LT & RT)
 (WITH EDGE LINE BREAKS AT I-89 NB RAMP D, I-89 NB RAMP E, I-89 NB RAMP F, I-89 NB RAMP G)
 MM W 0.374 (EDGE LINE LT AT I-89 NB RAMP D)
 MM W 0.374 (EDGE LINE RT AT I-89 NB RAMP E)
 MM W 0.413 (EDGE LINES AT I-89 NB RAMP F)
 MM W 0.417 (EDGE LINES AT I-89 NB RAMP G)
 MM W 0.300 - MM W 0.303 LT (DOTTED)
 MM W 0.300 - MM W 0.310 RT (DOTTED)
 MM W 0.310 - MM W 0.369 RT (SOLID)

DURABLE 4 INCH YELLOW LINE (SEE OPTION ITEMS) & TEMPORARY 4 INCH YELLOW LINE, PAINT
 MM W 0.300 - MM W 0.364 (SOLID LT & RT, ISLAND)
 MM W 0.377 - MM W 0.450 (SOLID LT & RT, ISLAND)
 MM W 0.443 - MM W 0.450 (DOUBLE SOLID LT & RT, ISLAND)
 MM W 0.374 (EDGE LINE LT AT I-89 NB RAMP D)
 MM W 0.374 (EDGE LINE RT AT I-89 NB RAMP E)

DURABLE 24 INCH STOP BAR (SEE OPTION ITEMS) & TEMPORARY 24 INCH STOP BAR, PAINT
 MM W 0.374 RT (I-89 NB RAMP E)

DURABLE LETTER OR SYMBOL (SEE OPTION ITEMS) & TEMPORARY LETTER OR SYMBOL, PAINT
 MM W 0.311 RT (LT ARROW)
 MM W 0.325 RT (ONLY)
 MM W 0.338 RT (LT ARROW)
 MM W 0.351 RT (ONLY)
 MM W 0.365 RT (LT ARROW)
 MM W 0.374 LT (5 TRIANGLES)
 MM W 0.374 RT (STOP) (I-89 NB RAMP E)
 MM W 0.398 RT (6 TRIANGLES)

REMOVING SIGNS (TYPE A) AS SHOWN - 3

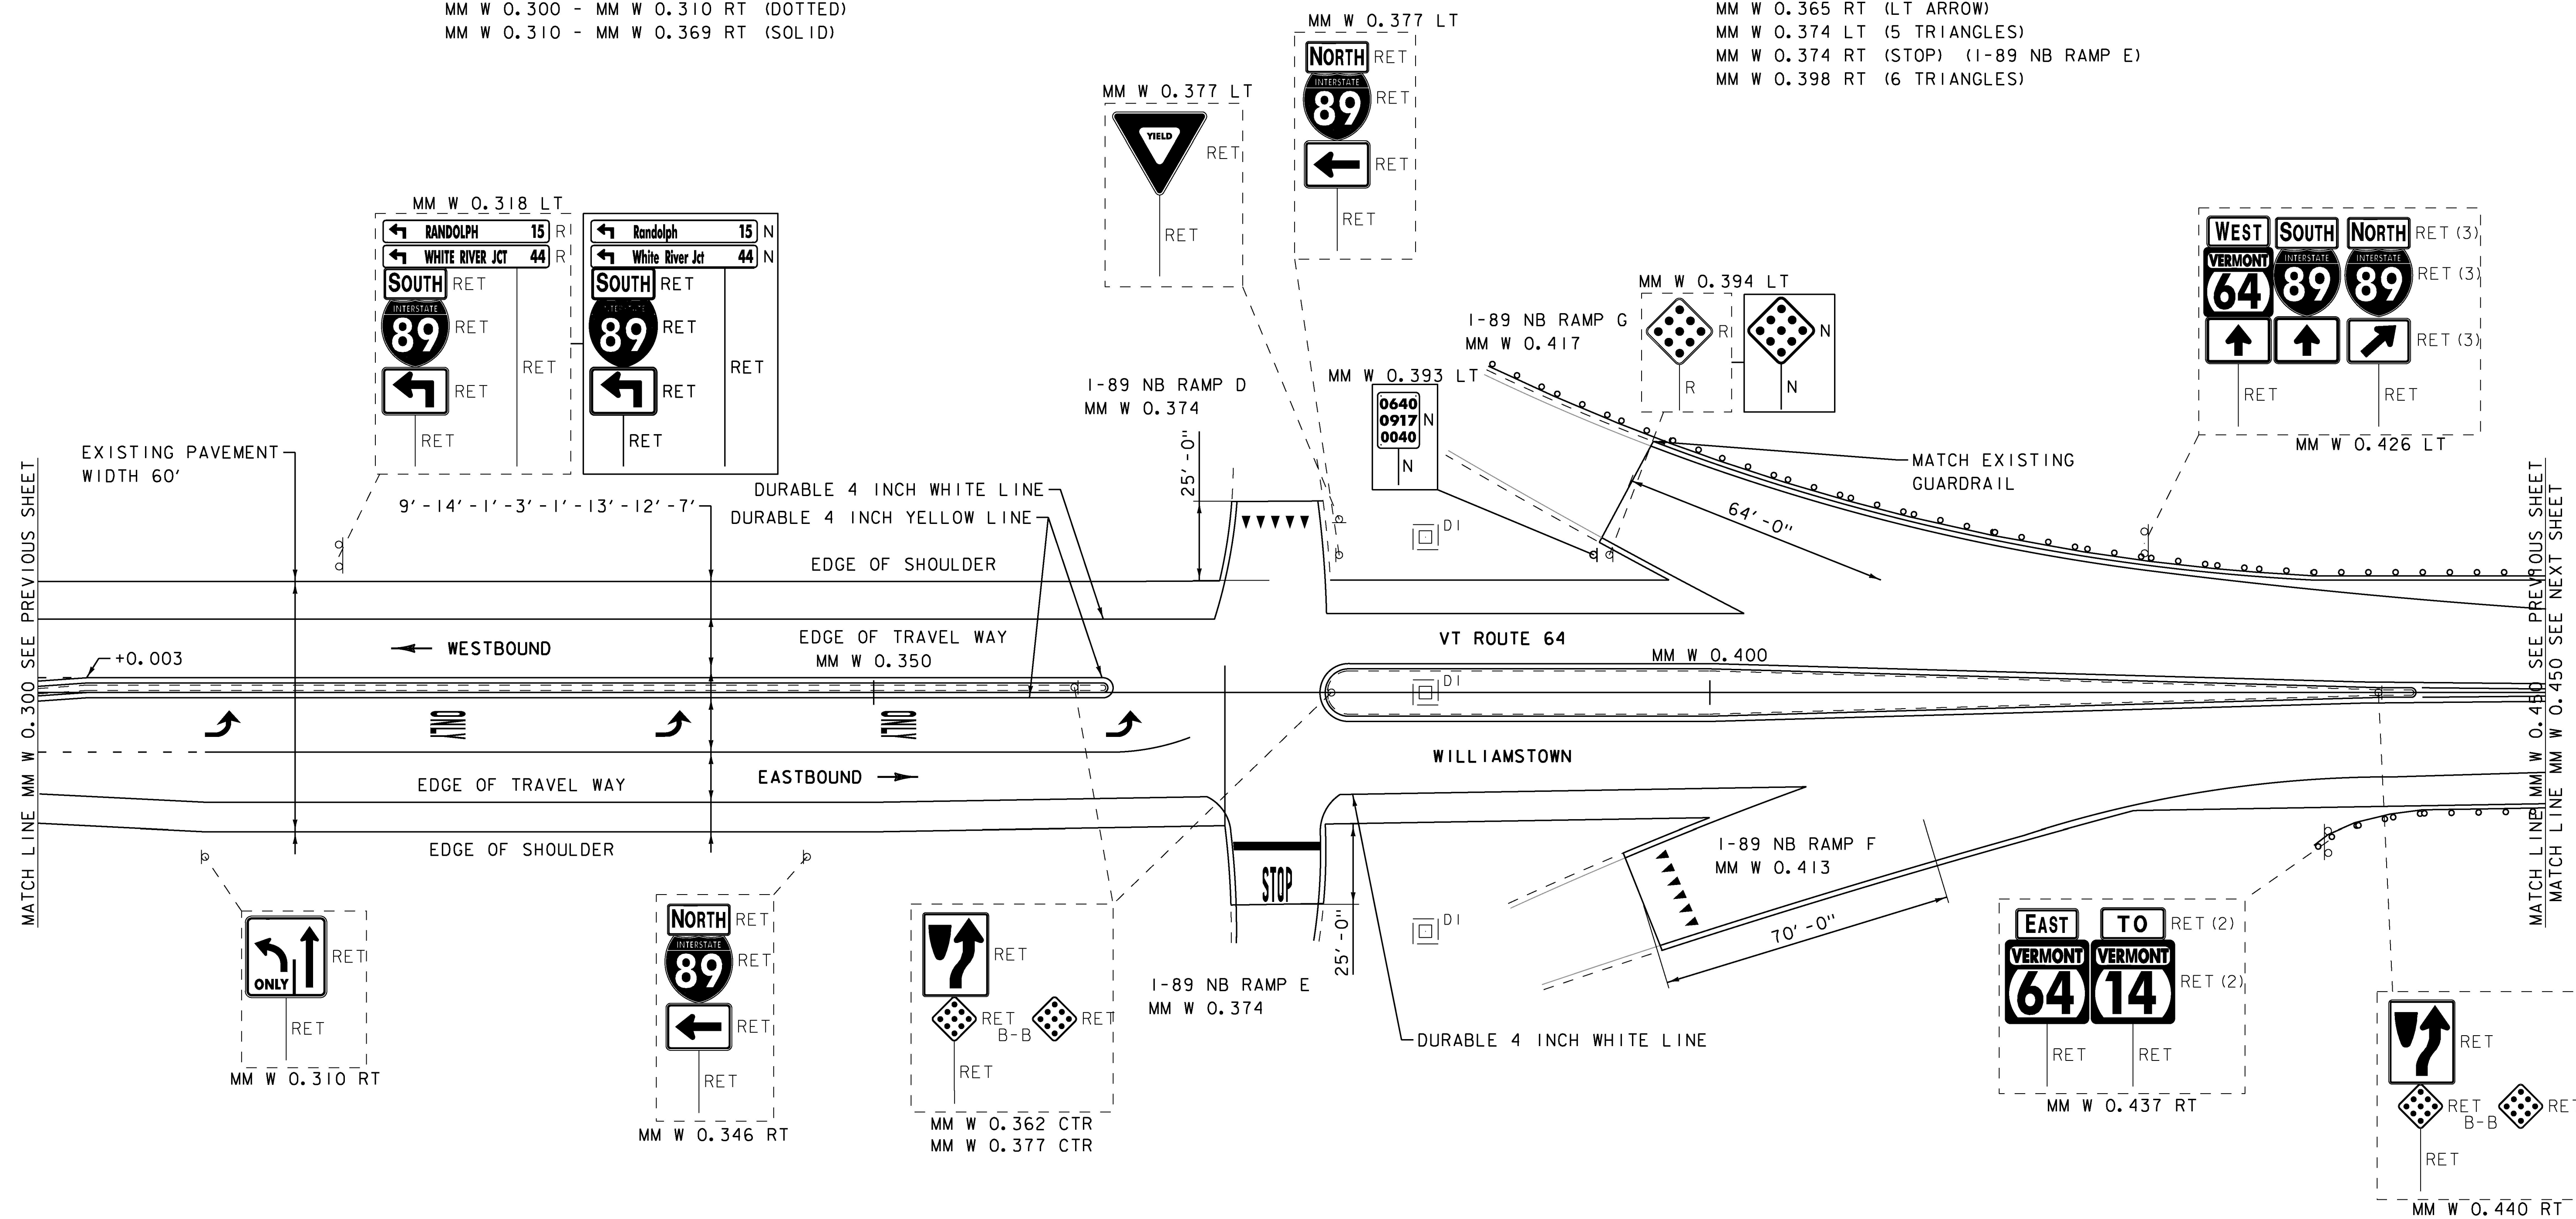

SIGN LEGEND
 R = REMOVE
 R&S = REMOVE AND SALVAGE
 RET = RETAIN
 S = SALVAGE
 N = NEW
 B-B = BACK TO BACK
 - - = EXISTING
 — = NEW

PROJECT NAME: NORTHFIELD-WILLIAMSTOWN
 PROJECT NUMBER: STP 2959(I)
 FILE NAME: z15v022bdr.dgn
 PROJECT LEADER: C. LATHROP
 DESIGNED BY: J. GOODALL
 PLAN SHEET 12
 PLOT DATE: 4/26/2016
 DRAWN BY: J. GOODALL
 CHECKED BY: C. LATHROP
 SHEET 102 OF 202

NOT TO SCALE