

STEEL BEAM GUARDRAIL, GALVANIZED  
 MM W 0.450 - MM W 0.502 LT  
 MM W 0.450 - MM W 0.545 RT  
 MM W 0.556 - MM W 0.619 RT

ANCHOR FOR STEEL BEAM RAIL  
 MM W 0.502 LT  
 MM W 0.545 RT  
 MM W 0.556 RT  
 MM W 0.619 RT

REMOVAL AND DISPOSAL OF GUARDRAIL  
 MM W 0.450 - MM W 0.502 LT  
 MM W 0.450 - MM W 0.545 RT  
 MM W 0.556 - MM W 0.619 RT

DURABLE 4 INCH WHITE LINE (SEE OPTION ITEMS) & TEMPORARY 4 INCH WHITE LINE, PAINT  
 MM W 0.450 - MM W 0.620 (SOLID LT & RT)  
 (WITH EDGE LINE BREAKS AT TH#47)  
 MM W 0.516 (EDGE LINES AT TH#47)

DURABLE 4 INCH YELLOW LINE (SEE OPTION ITEMS) & TEMPORARY 4 INCH YELLOW LINE, PAINT  
 MM W 0.450 - MM W 0.472 (DOUBLE SOLID LT & RT, ISLAND)  
 MM W 0.472 - MM W 0.620 (SOLID LT & RT)  
 (WITH CENTERLINE BREAK AT TH#47)  
 MM W 0.516 (CENTERLINE AT TH#47) MM W 0.506 LT

DURABLE 24 INCH STOP BAR (SEE OPTION ITEMS) & TEMPORARY 24 INCH STOP BAR, PAINT  
 MM W 0.512 LT (TH#47)


DURABLE LETTER OR SYMBOL (SEE OPTION ITEMS) & TEMPORARY LETTER OR SYMBOL, PAINT  
 MM W 0.512 LT (STOP) (TH#47)

REMOVING SIGNS (TYPE A)  
 AS SHOWN - 13

REMOVING SIGNS (TYPE B)  
 AS SHOWN - 1

ERECTING SALVAGED SIGNS  
 AS SHOWN - 1

**NOTE:**  
 ALL DURABLE PAVEMENT MARKINGS WILL BE CONTINUED TO THE END OF THE PROJECT AT MM W 4.219 IN WILLIAMSTOWN, WITH EDGE LINE AND CENTERLINE BREAKS AT ALL TOWN HIGHWAYS. SEE ITEM DETAIL SHEETS AND TRAFFIC SIGN SUMMARY SHEETS FOR ADDITIONAL QUANTITIES.

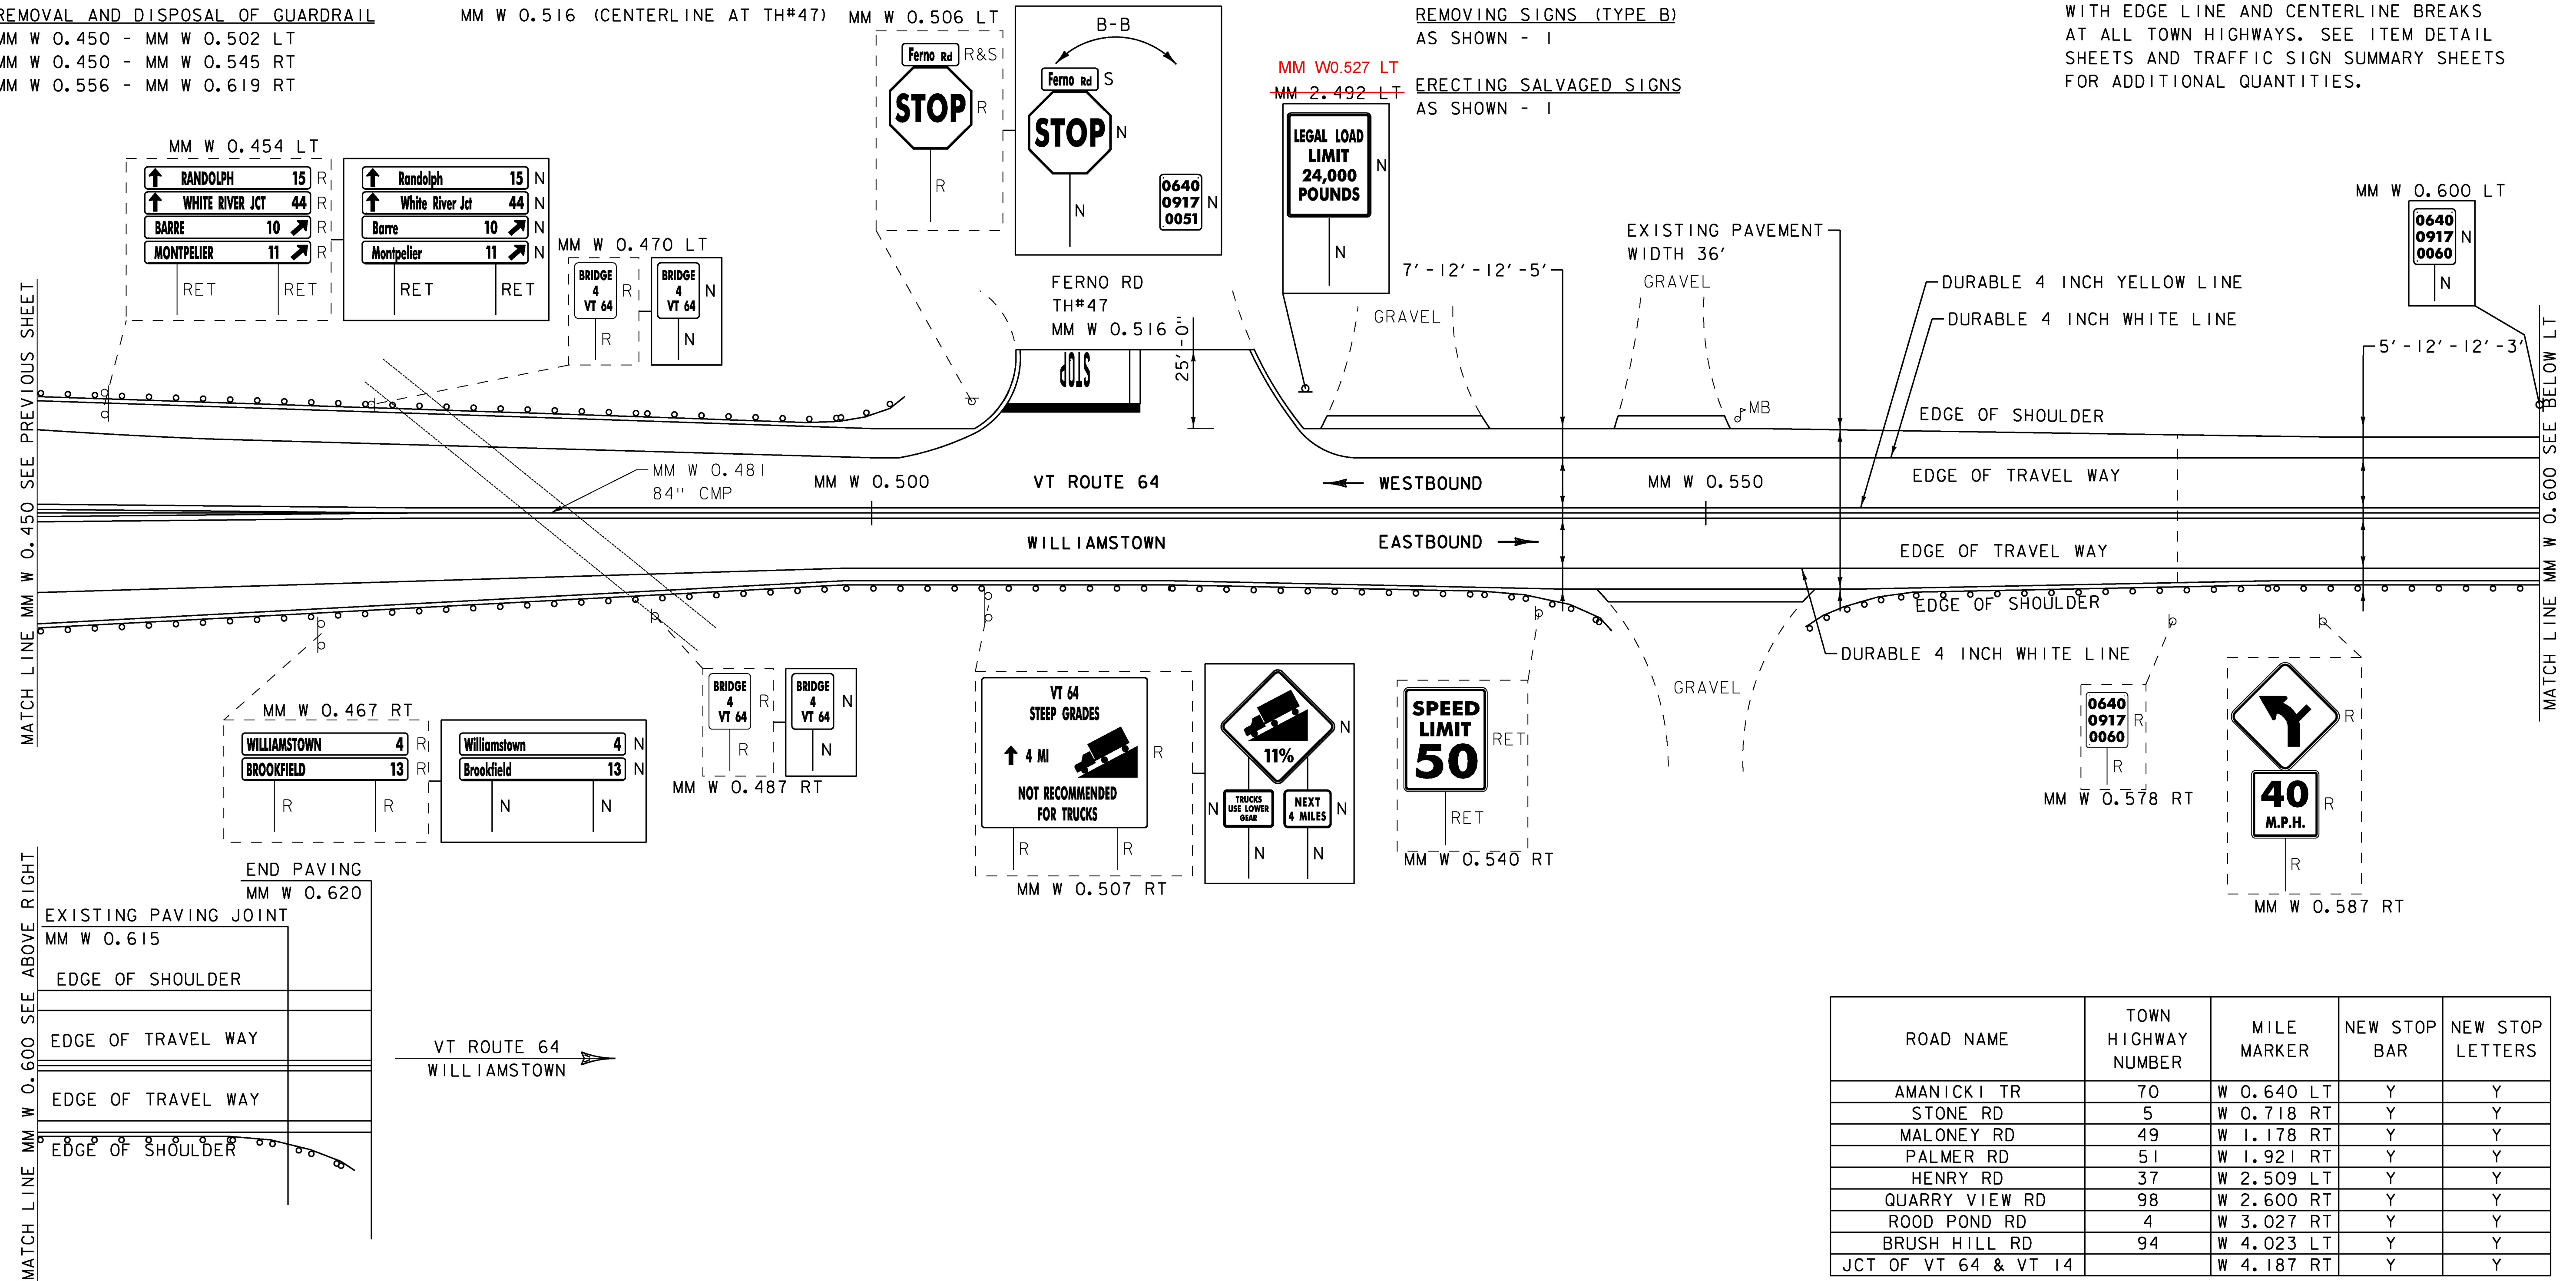

MATCH LINE MM W 0.450 SEE PREVIOUS SHEET

MATCH LINE MM W 0.600 SEE ABOVE RIGHT

MATCH LINE MM W 0.600 SEE BELOW LT

**SIGN LEGEND**  
 R = REMOVE  
 R&S = REMOVE AND SALVAGE  
 RET = RETAIN  
 S = SALVAGE  
 N = NEW  
 B-B = BACK TO BACK  
 - . = EXISTING  
 - = NEW

ROAD NAME	TOWN HIGHWAY NUMBER	MILE MARKER	NEW STOP BAR	NEW STOP LETTERS
AMANICKI TR	70	W 0.640 LT	Y	Y
STONE RD	5	W 0.718 RT	Y	Y
MALONEY RD	49	W 1.178 RT	Y	Y
PALMER RD	51	W 1.921 RT	Y	Y
HENRY RD	37	W 2.509 LT	Y	Y
QUARRY VIEW RD	98	W 2.600 RT	Y	Y
ROOD POND RD	4	W 3.027 RT	Y	Y
BRUSH HILL RD	94	W 4.023 LT	Y	Y
JCT OF VT 64 & VT 14		W 4.187 RT	Y	Y

PROJECT NAME: NORTHFIELD-WILLIAMSTOWN  
 PROJECT NUMBER: STP 2959(I)  
 FILE NAME: z15v022bdr.dgn  
 PROJECT LEADER: C. LATHROP  
 DESIGNED BY: J. GOODALL  
 PLAN SHEET 13  
 PLOT DATE: 4/26/2016  
 DRAWN BY: J. GOODALL  
 CHECKED BY: C. LATHROP  
 SHEET 103 OF 202

NOT TO SCALE