


SEED
STA 0+15 - 3+63

PROJECT DEMARCATION FENCE
STA 0+20 - 3+75

AREA OF PAVEMENT REMOVAL/FULL DEPTH CONSTRUCTION	6157.43 SF
AREA OF SLOPE RECONSTRUCTION	3064.15 SF
AREA BETWEEN PDF AND WORK LIMITS	2244.11 SF
TOTAL AREA OF DISTURBANCE	11465.69 SF

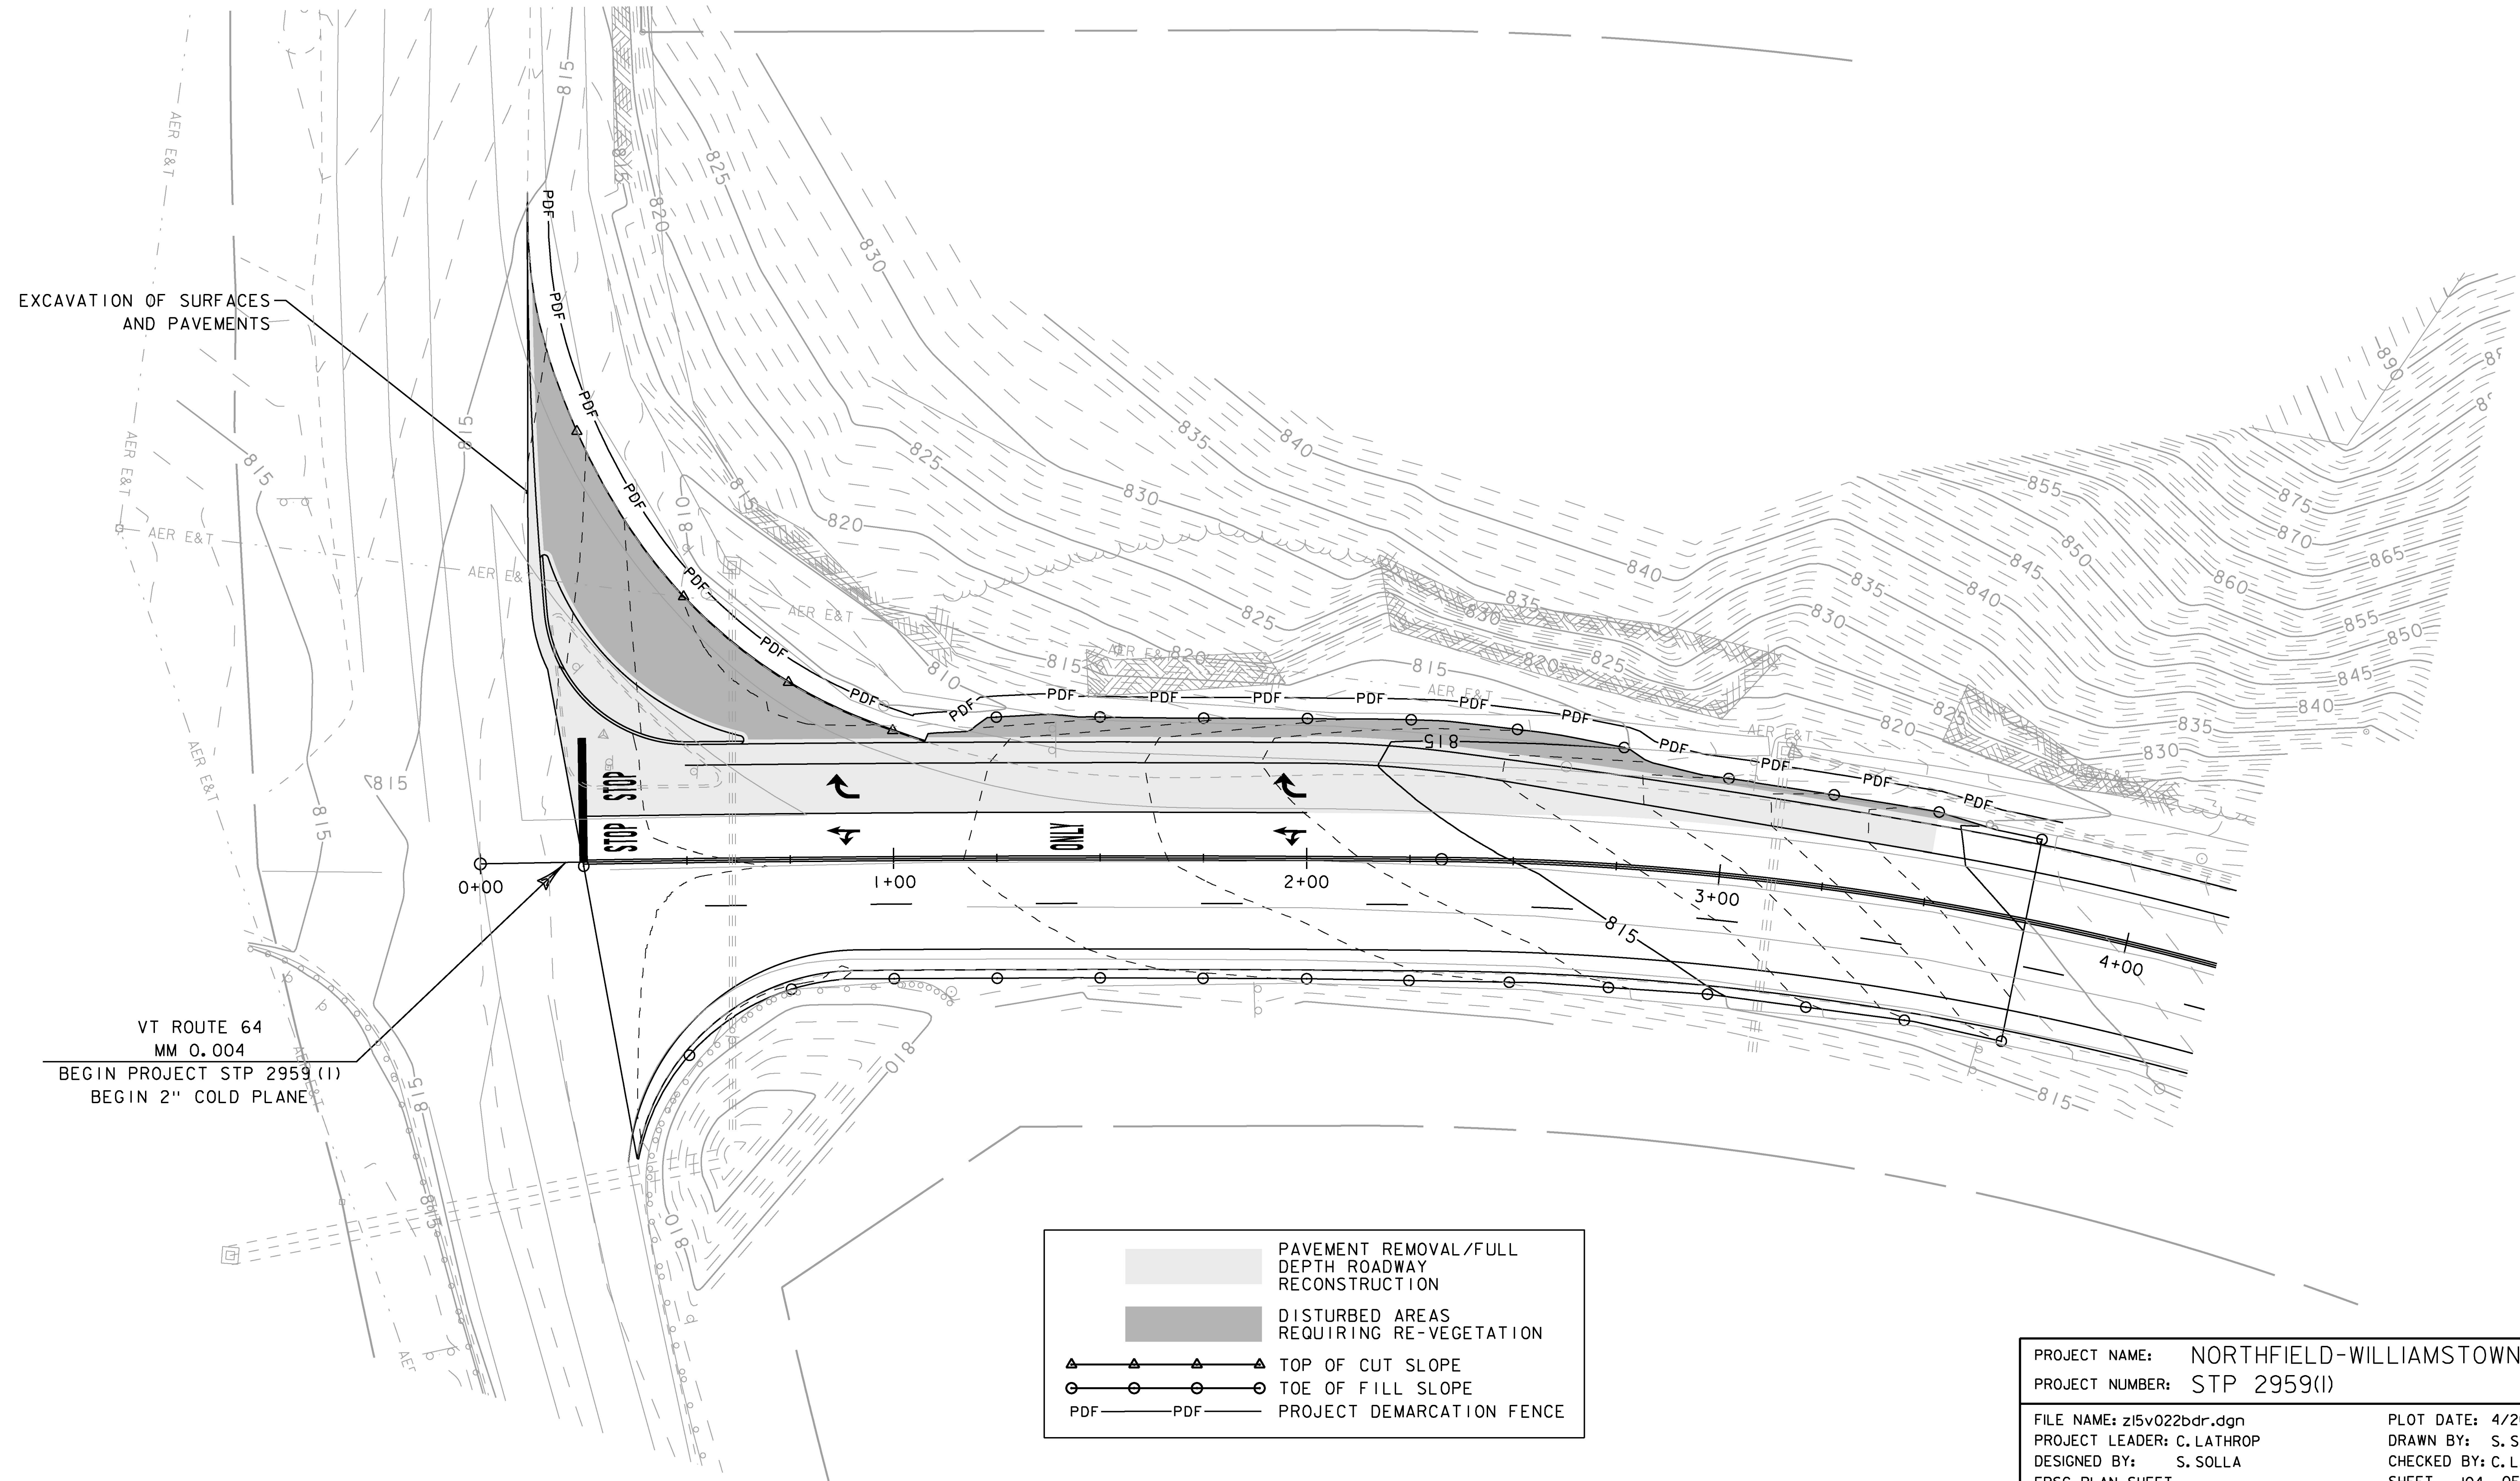

EXCAVATION OF SURFACES AND PAVEMENTS

VT ROUTE 64
MM 0.004
BEGIN PROJECT STP 2959(I)
BEGIN 2" COLD PLANE

	PAVEMENT REMOVAL/FULL DEPTH ROADWAY RECONSTRUCTION
	DISTURBED AREAS REQUIRING RE-VEGETATION
	TOP OF CUT SLOPE
	TOE OF FILL SLOPE
	PROJECT DEMARCATION FENCE

PROJECT NAME:	NORTHFIELD-WILLIAMSTOWN
PROJECT NUMBER:	STP 2959(I)
FILE NAME:	z15v022bdr.dgn
PROJECT LEADER:	C. LATHROP
DESIGNED BY:	S. SOLLA
EPSC PLAN SHEET	
PLOT DATE:	4/26/2016
DRAWN BY:	S. SOLLA
CHECKED BY:	C. LATHROP
SHEET	104 OF 202