




0+50

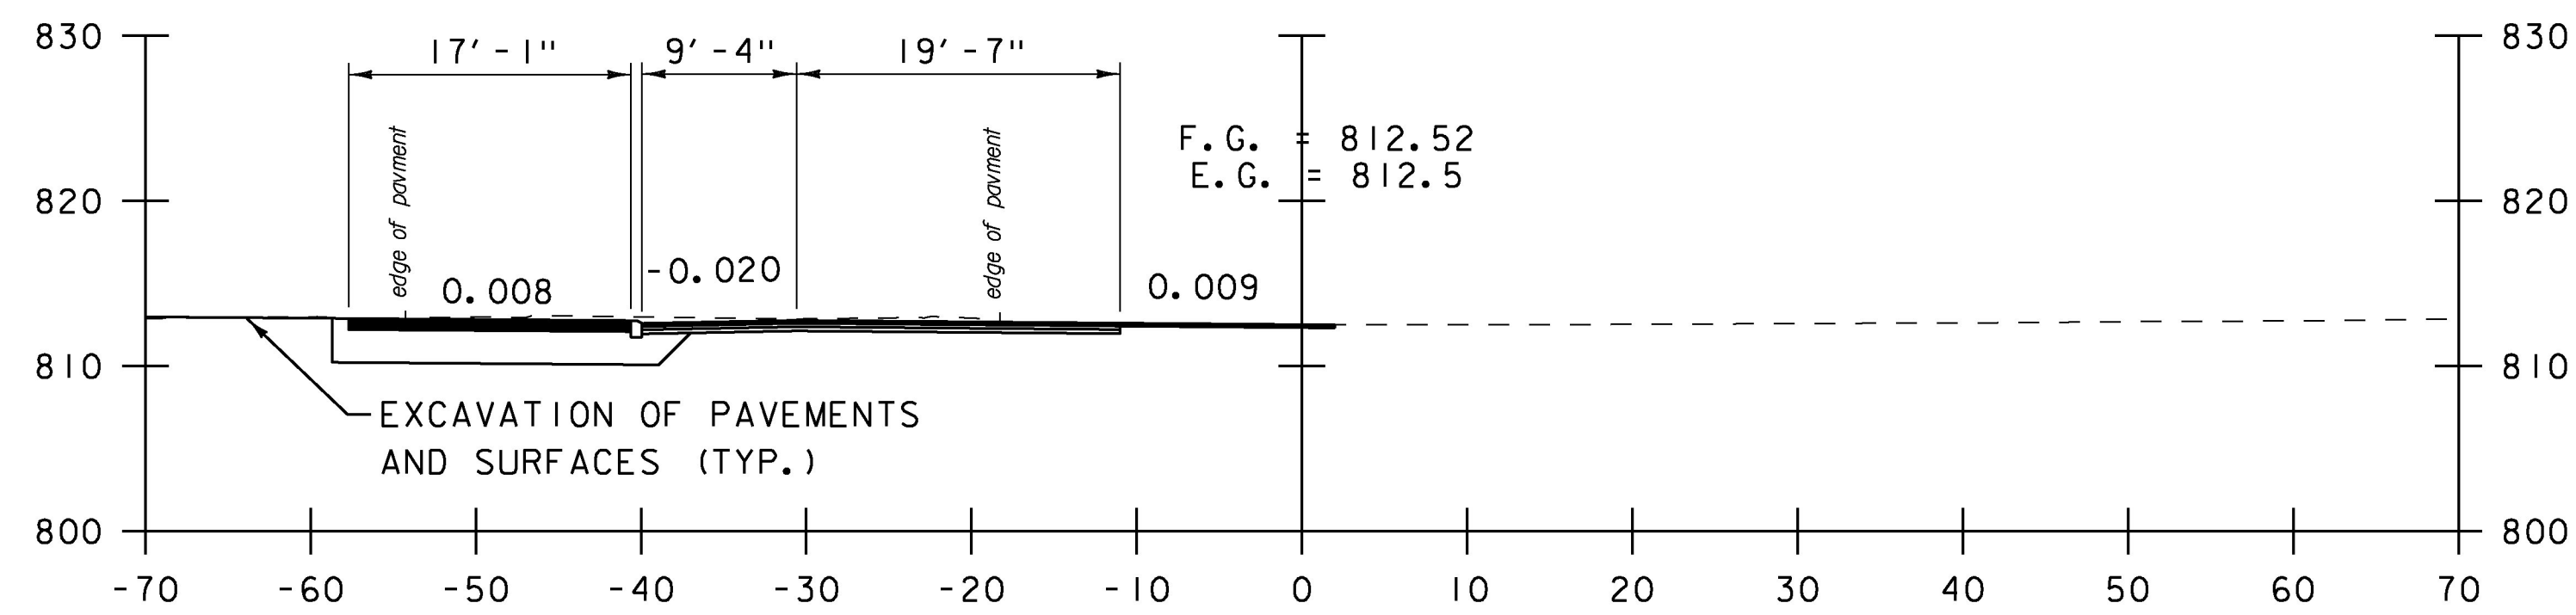


0+25

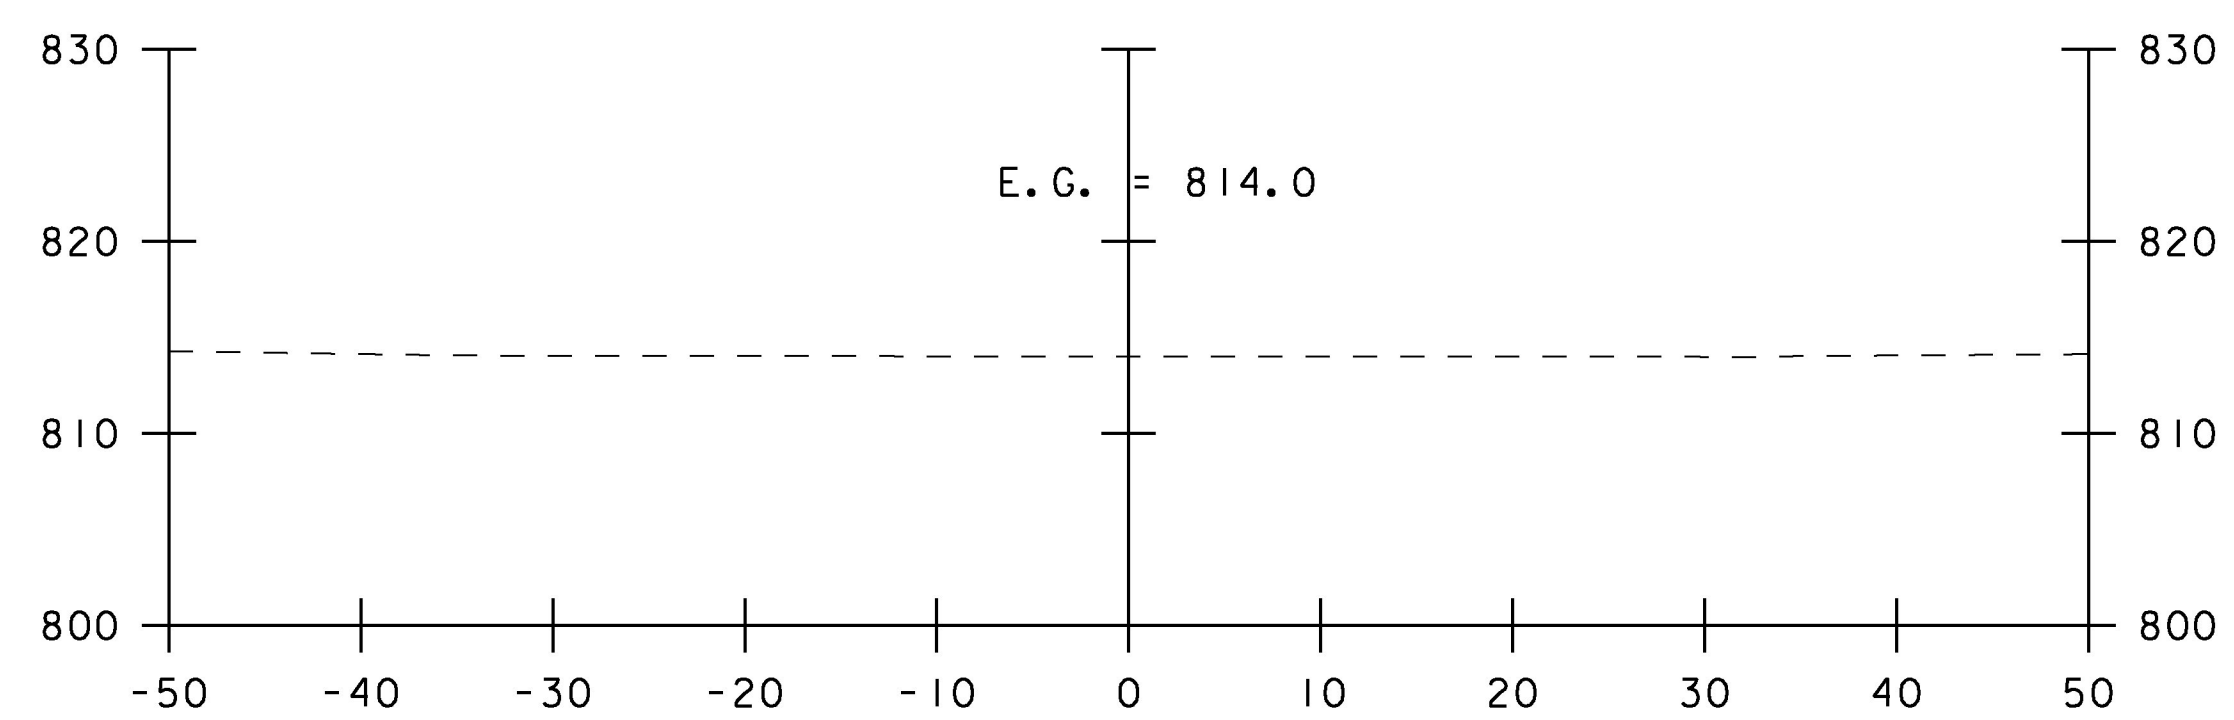


0+00

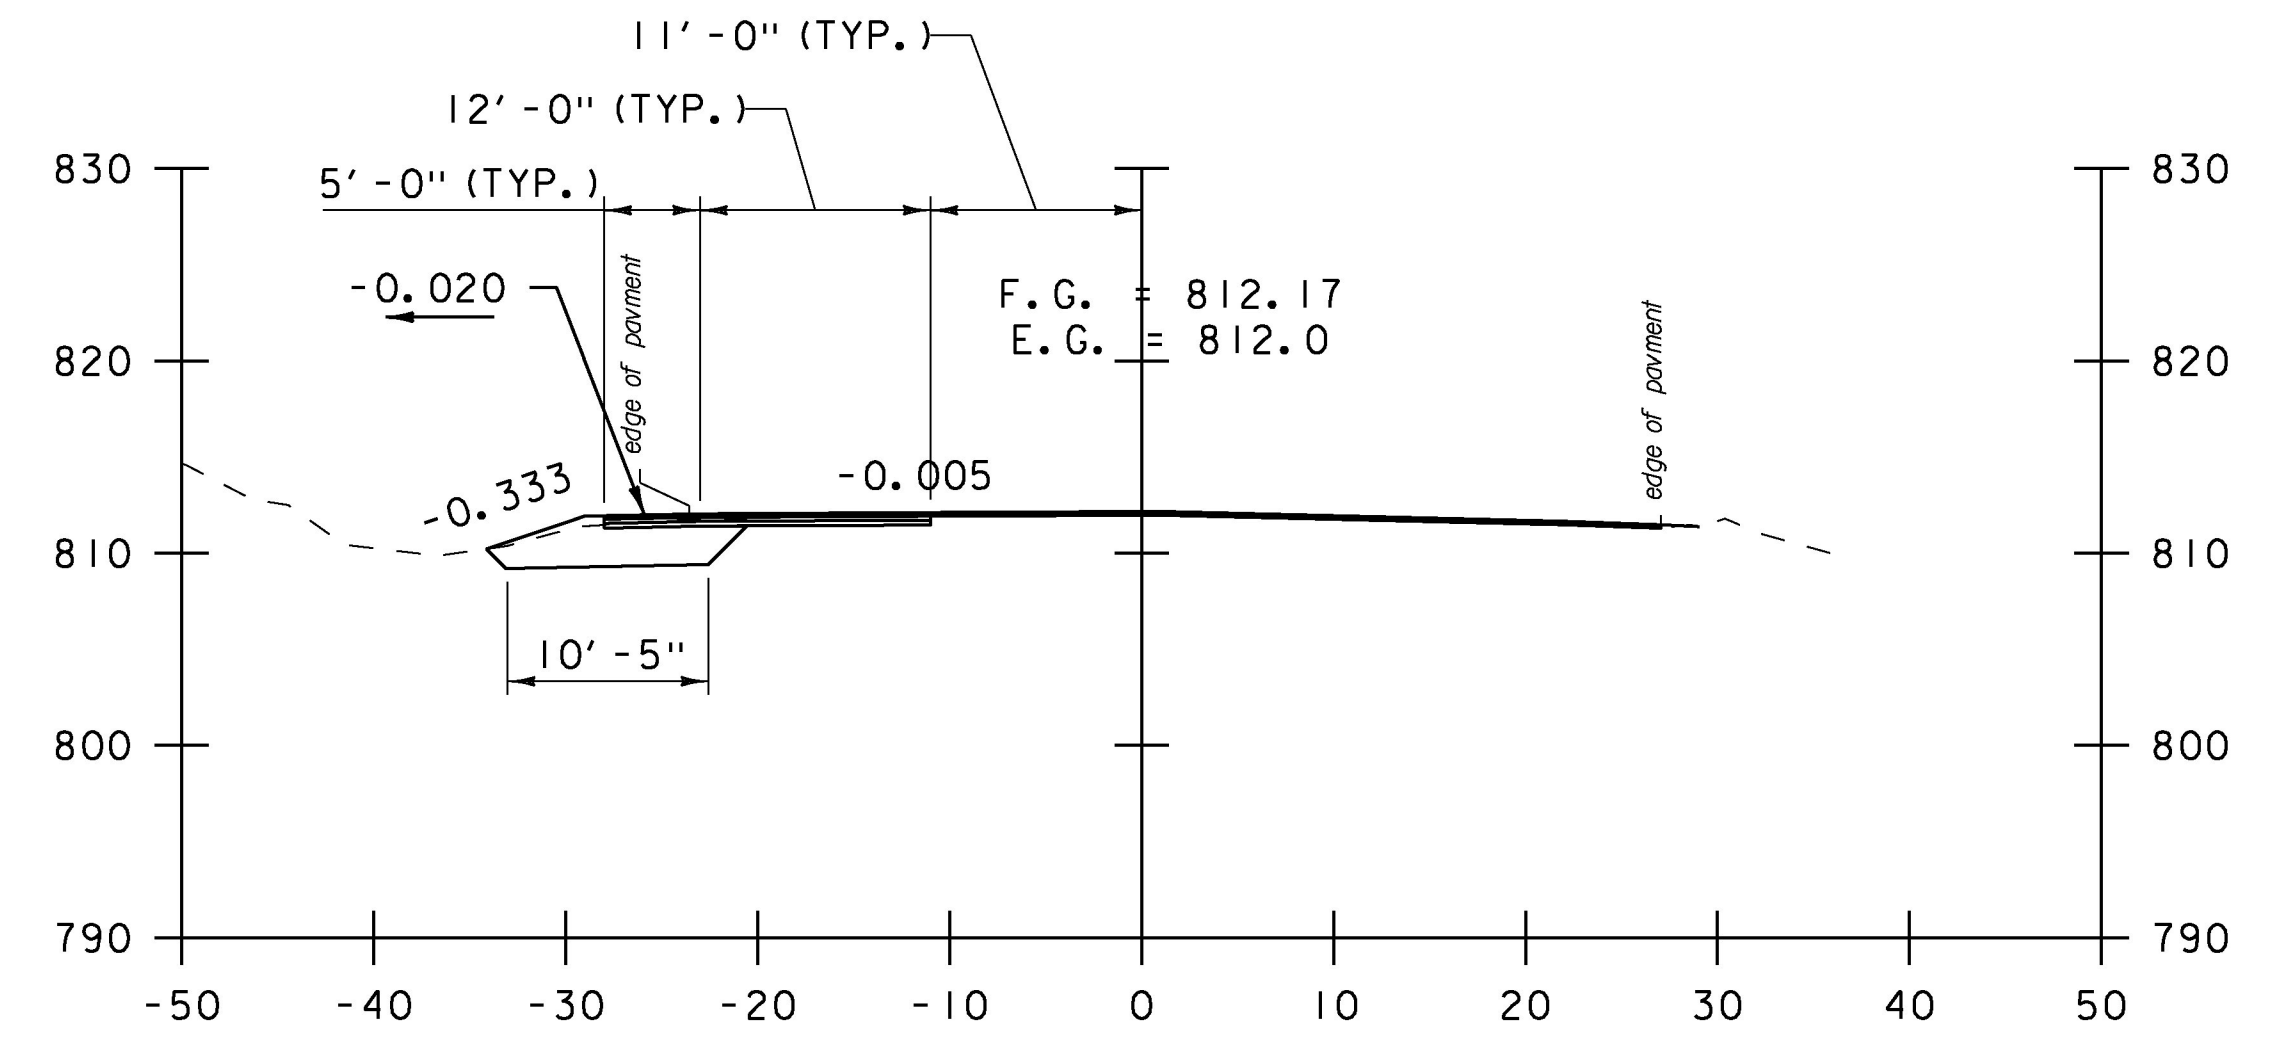


1+25

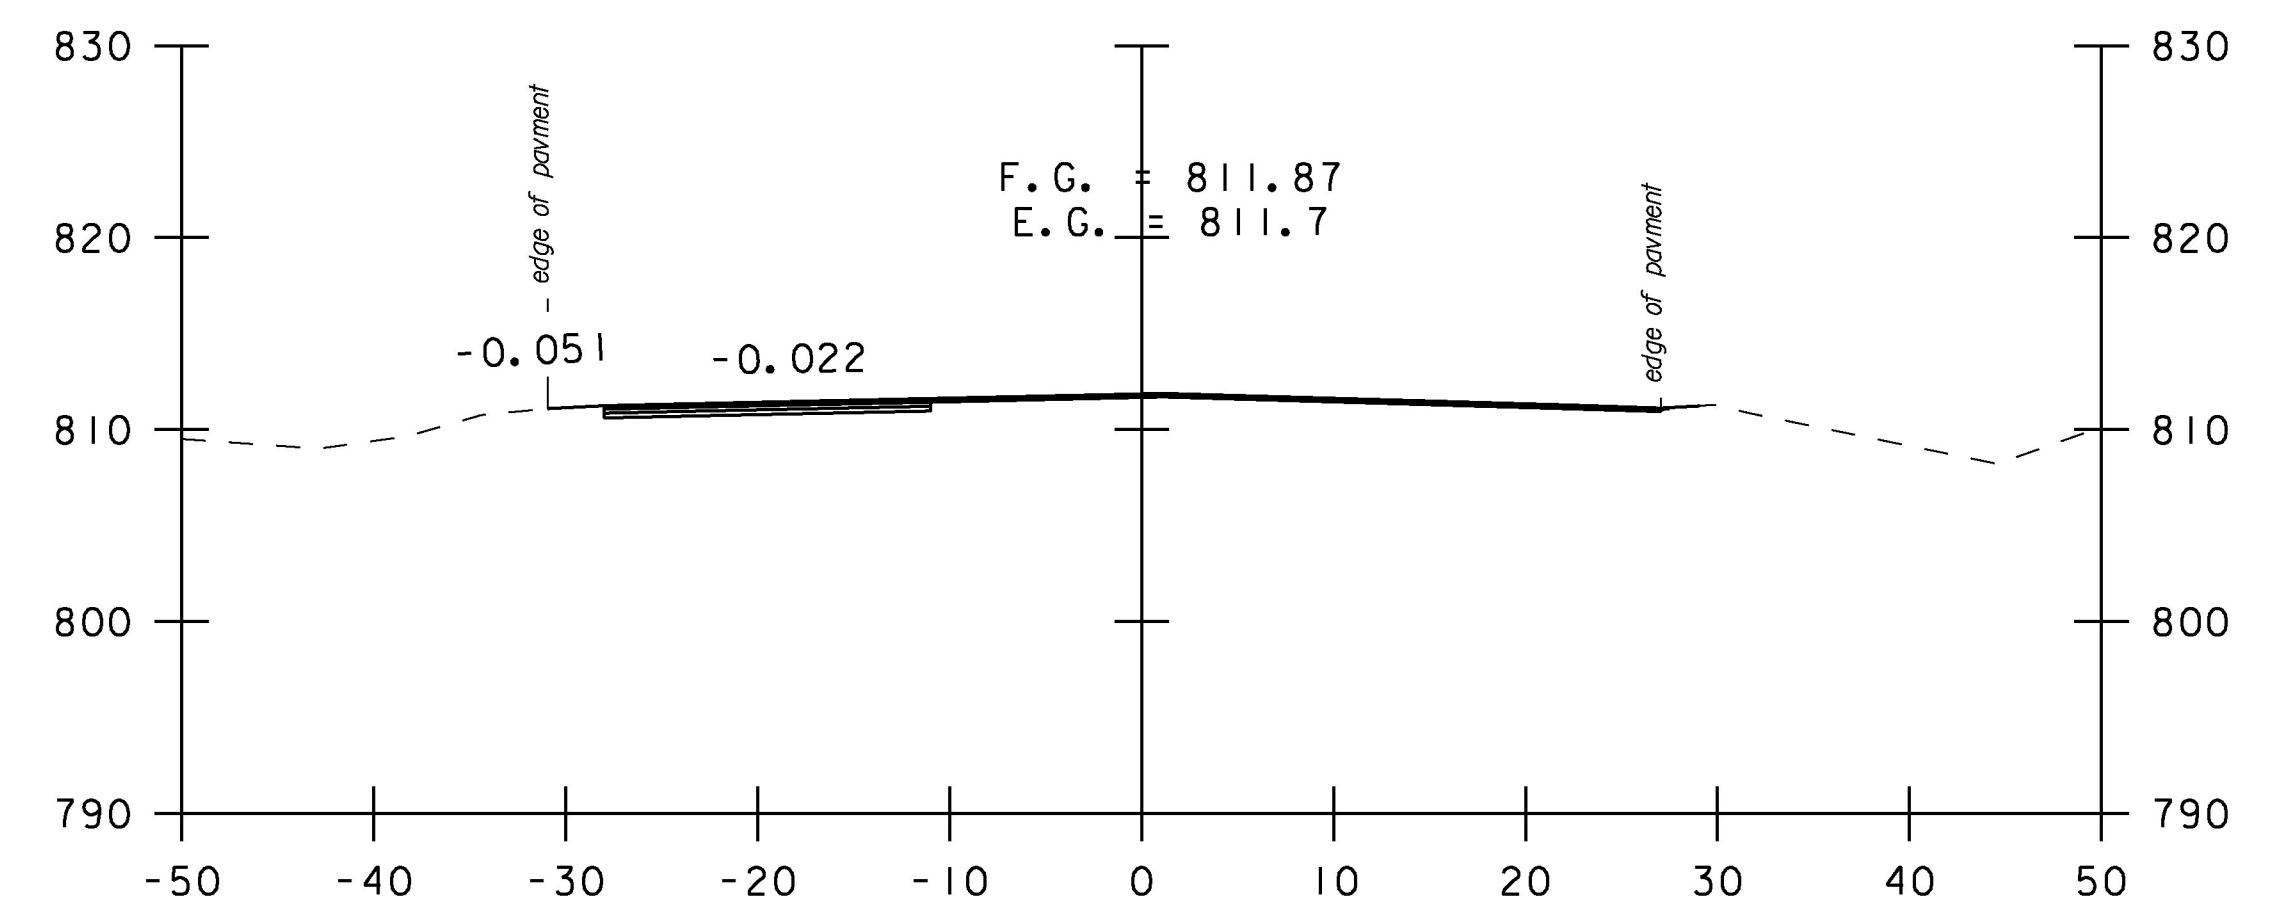

1+00

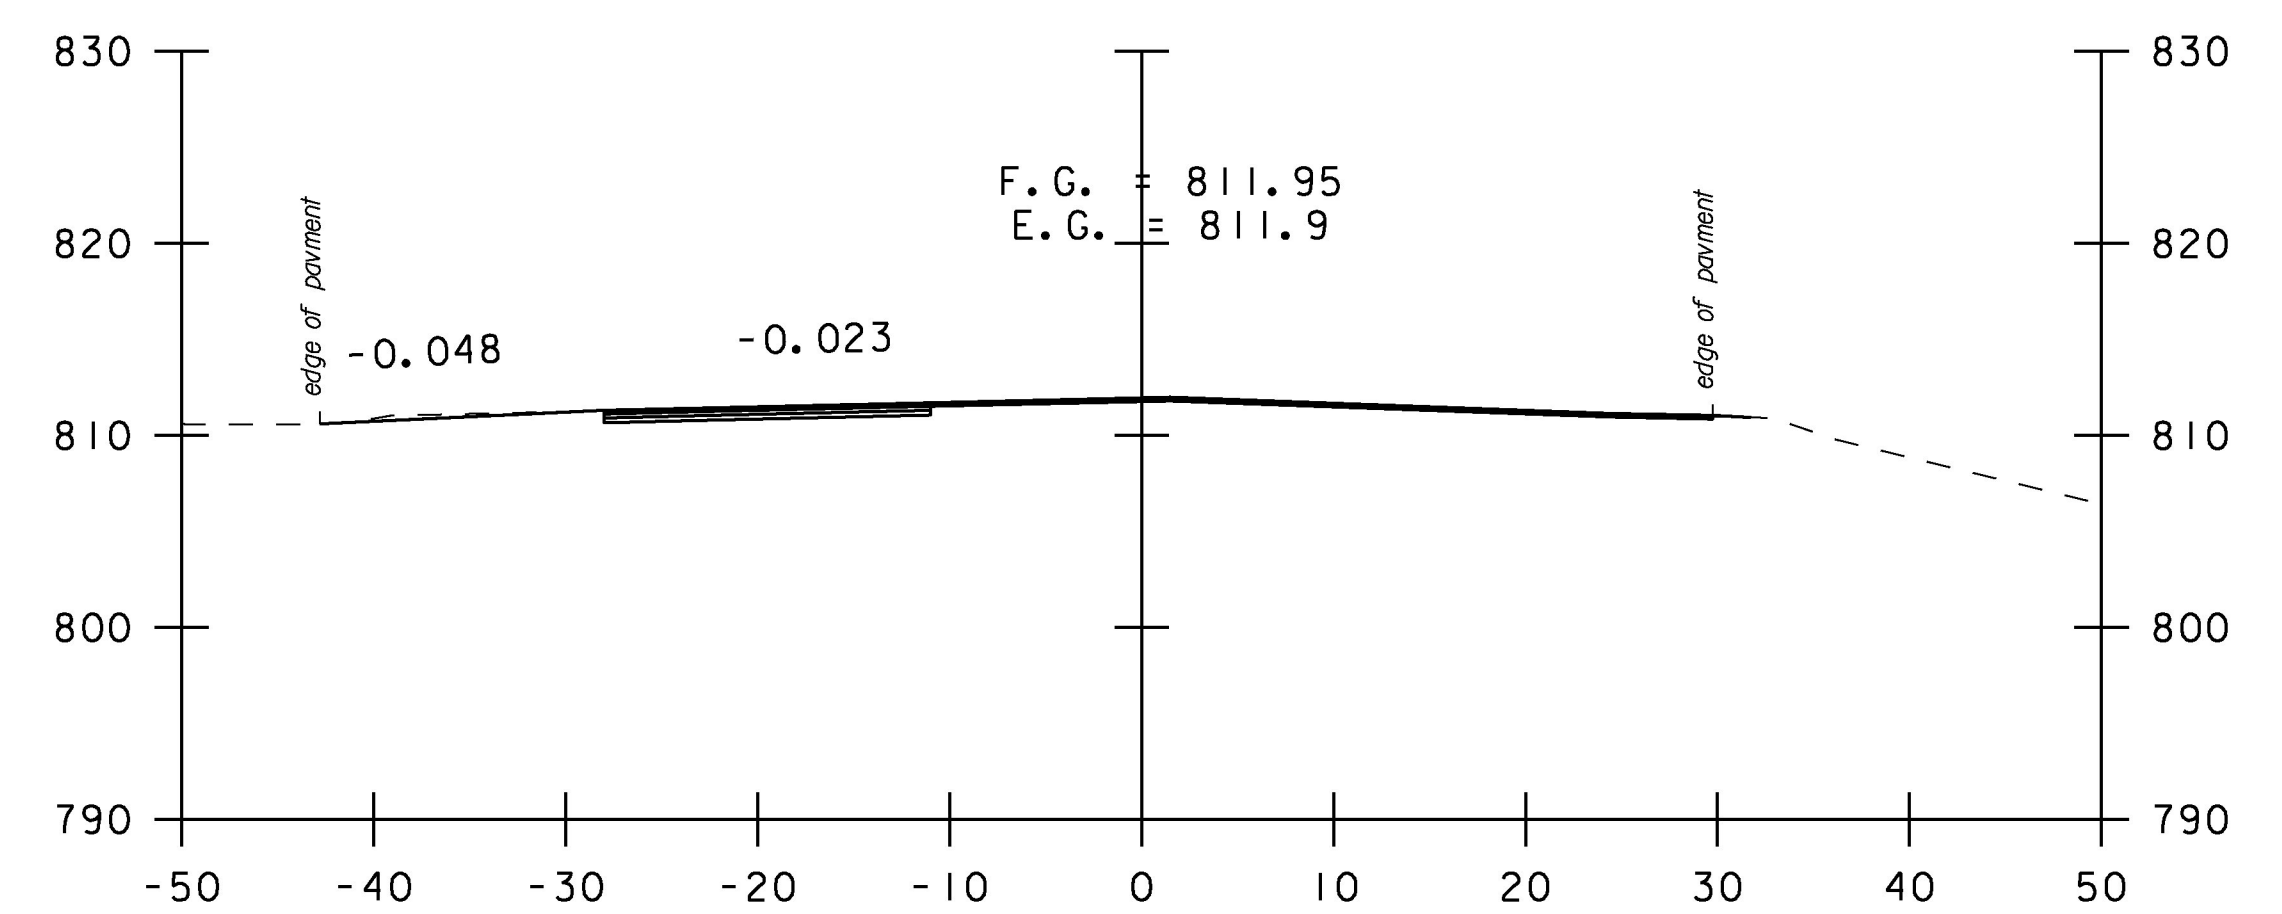

0+75

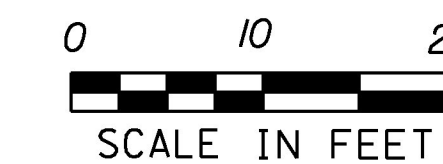

SCALE IN FEET

STA. 0+00 TO STA. 1+25

PROJECT NAME: NORTHFIELD-WILLIAMSTOWN	
PROJECT NUMBER: STP 2959(1)	
FILE NAME: z15v022xsl.dgn	PLOT DATE: 4/26/2016
PROJECT LEADER: C. LATHROP	DRAWN BY: S. SOLLA
DESIGNED BY: S. SOLLA	CHECKED BY: C. LATHROP
CROSS SECTION SHEET 1	SHEET 137 OF 202