




2+00

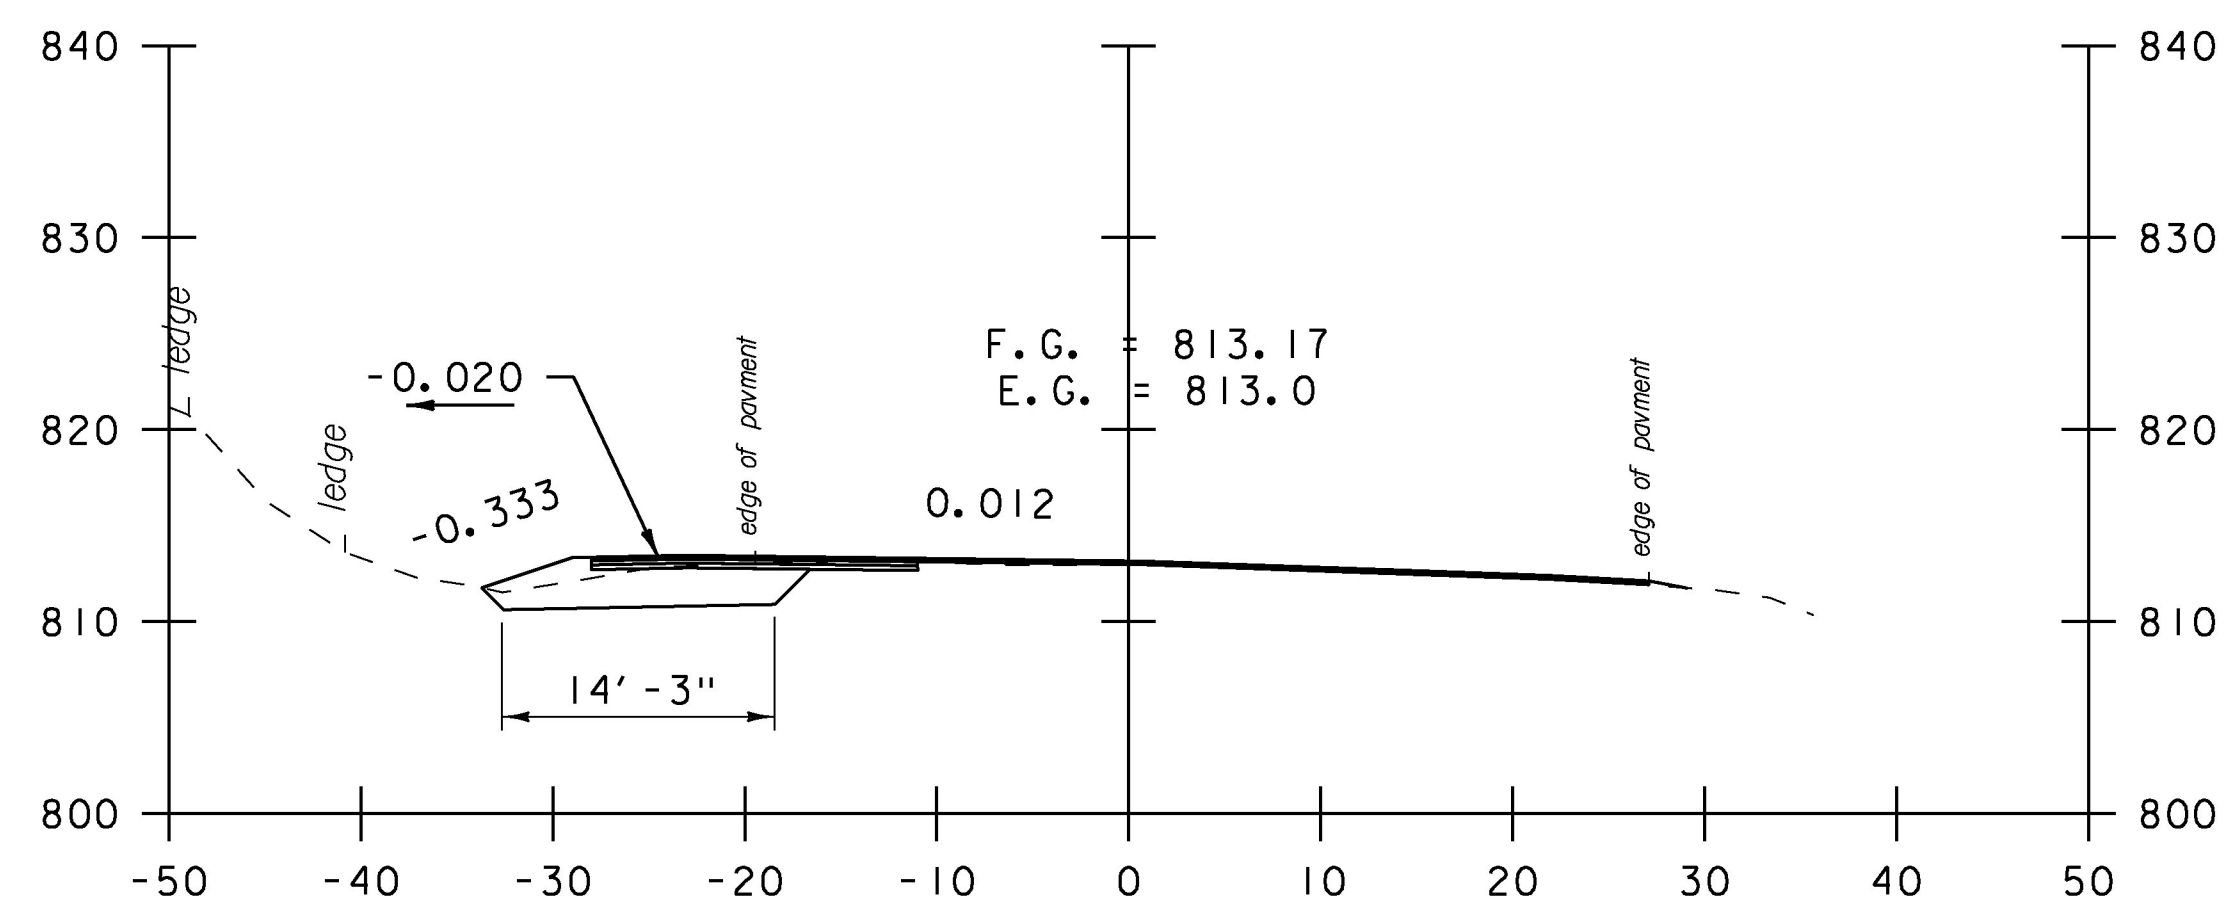


1+75

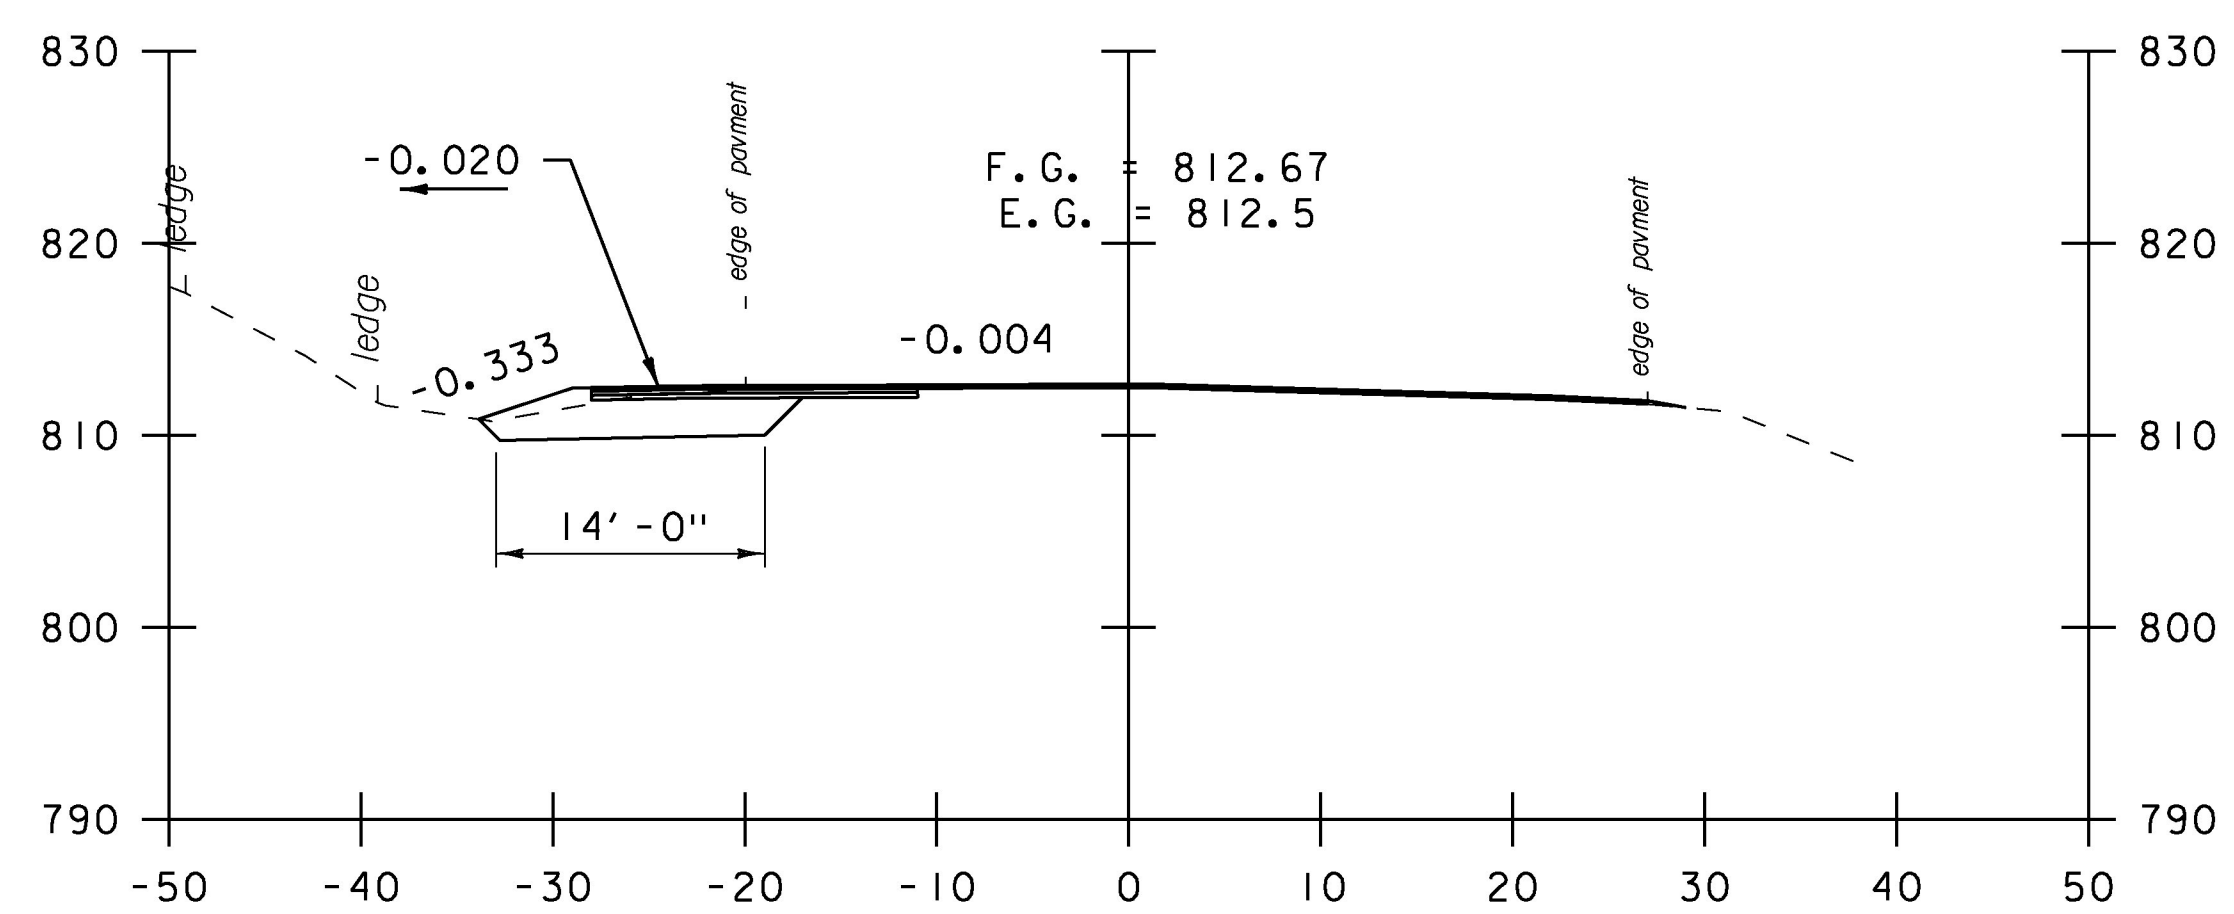


1+50

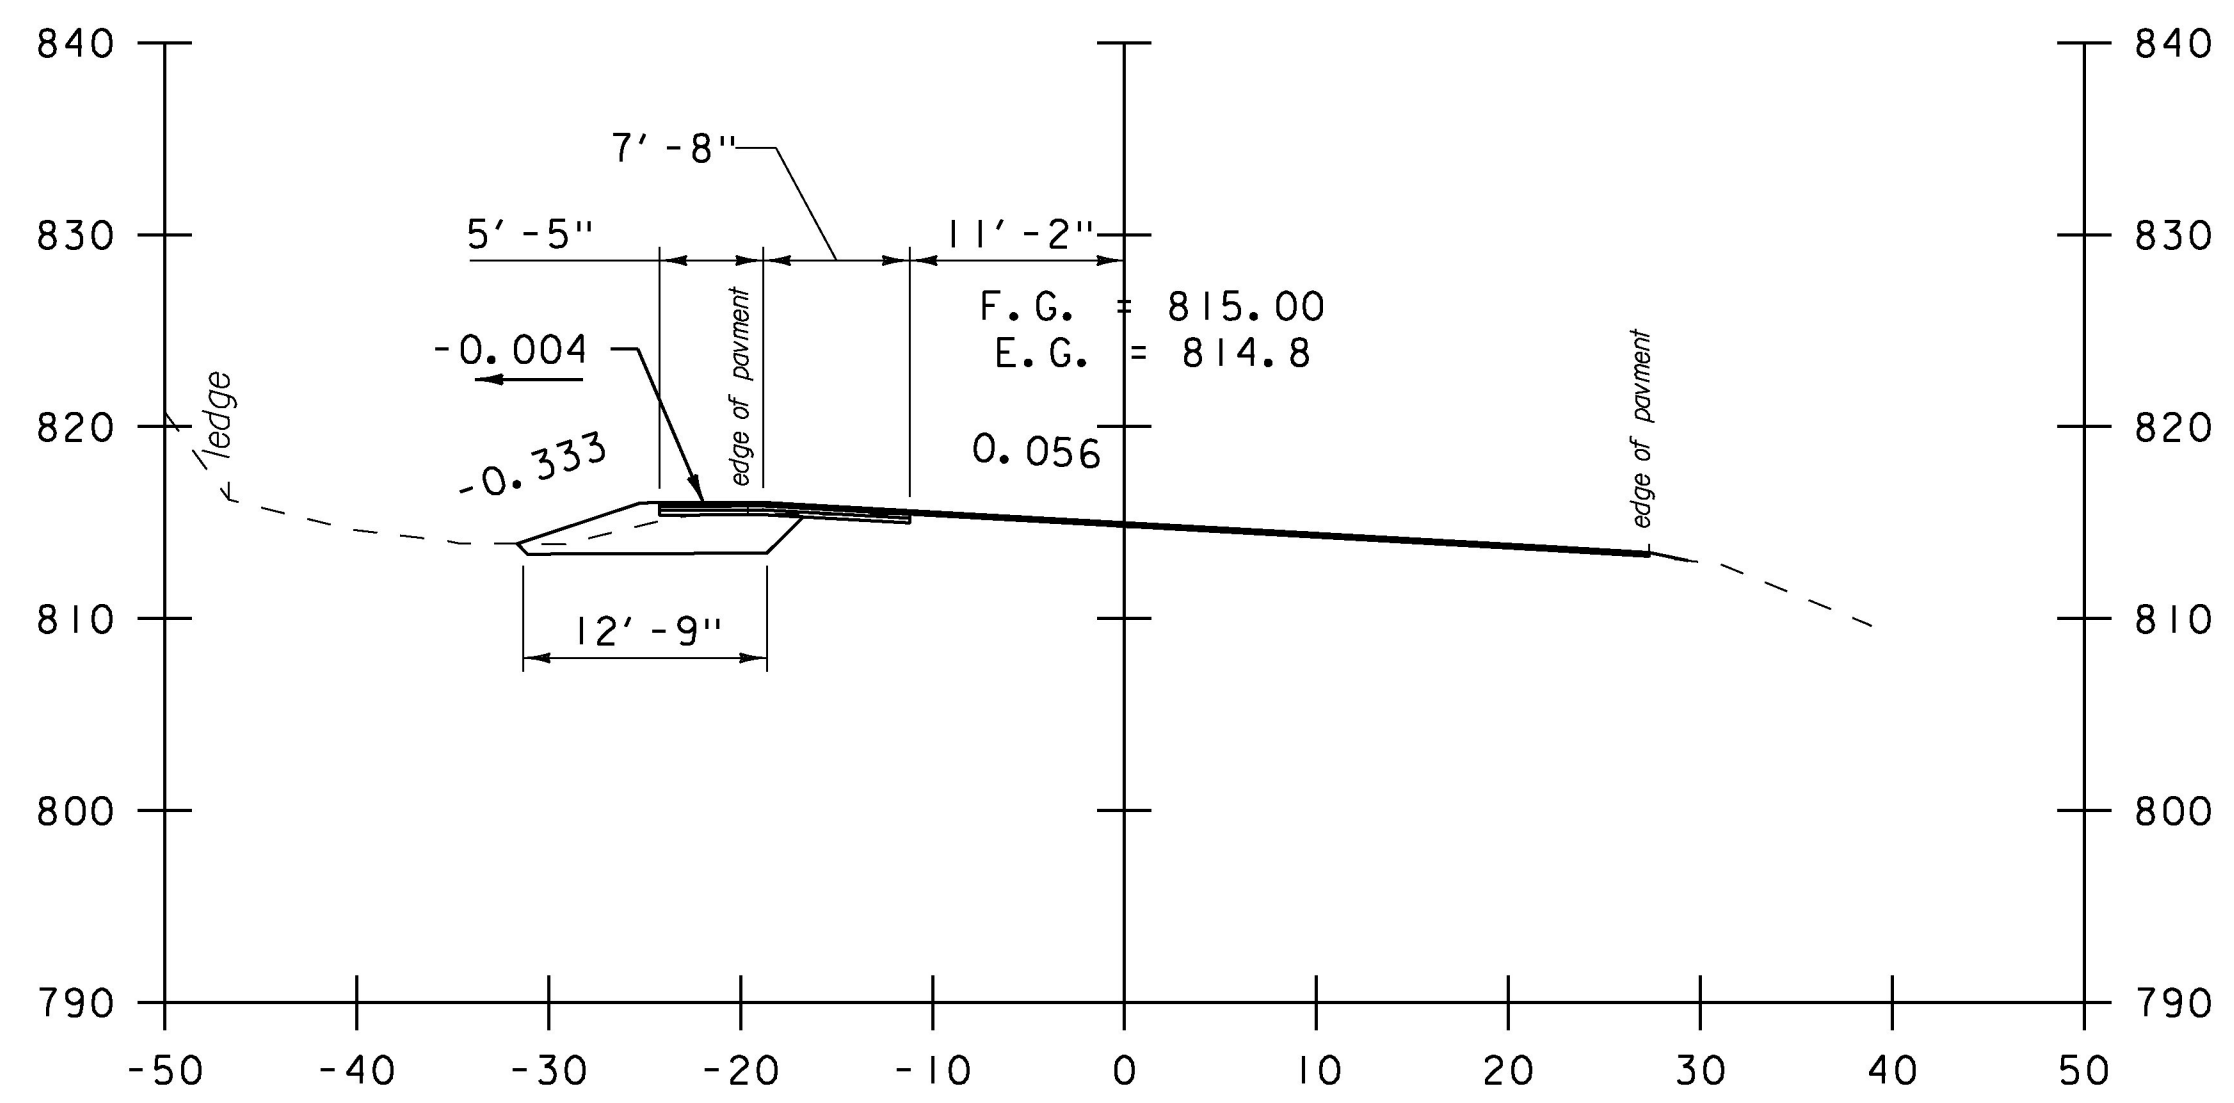

2+50

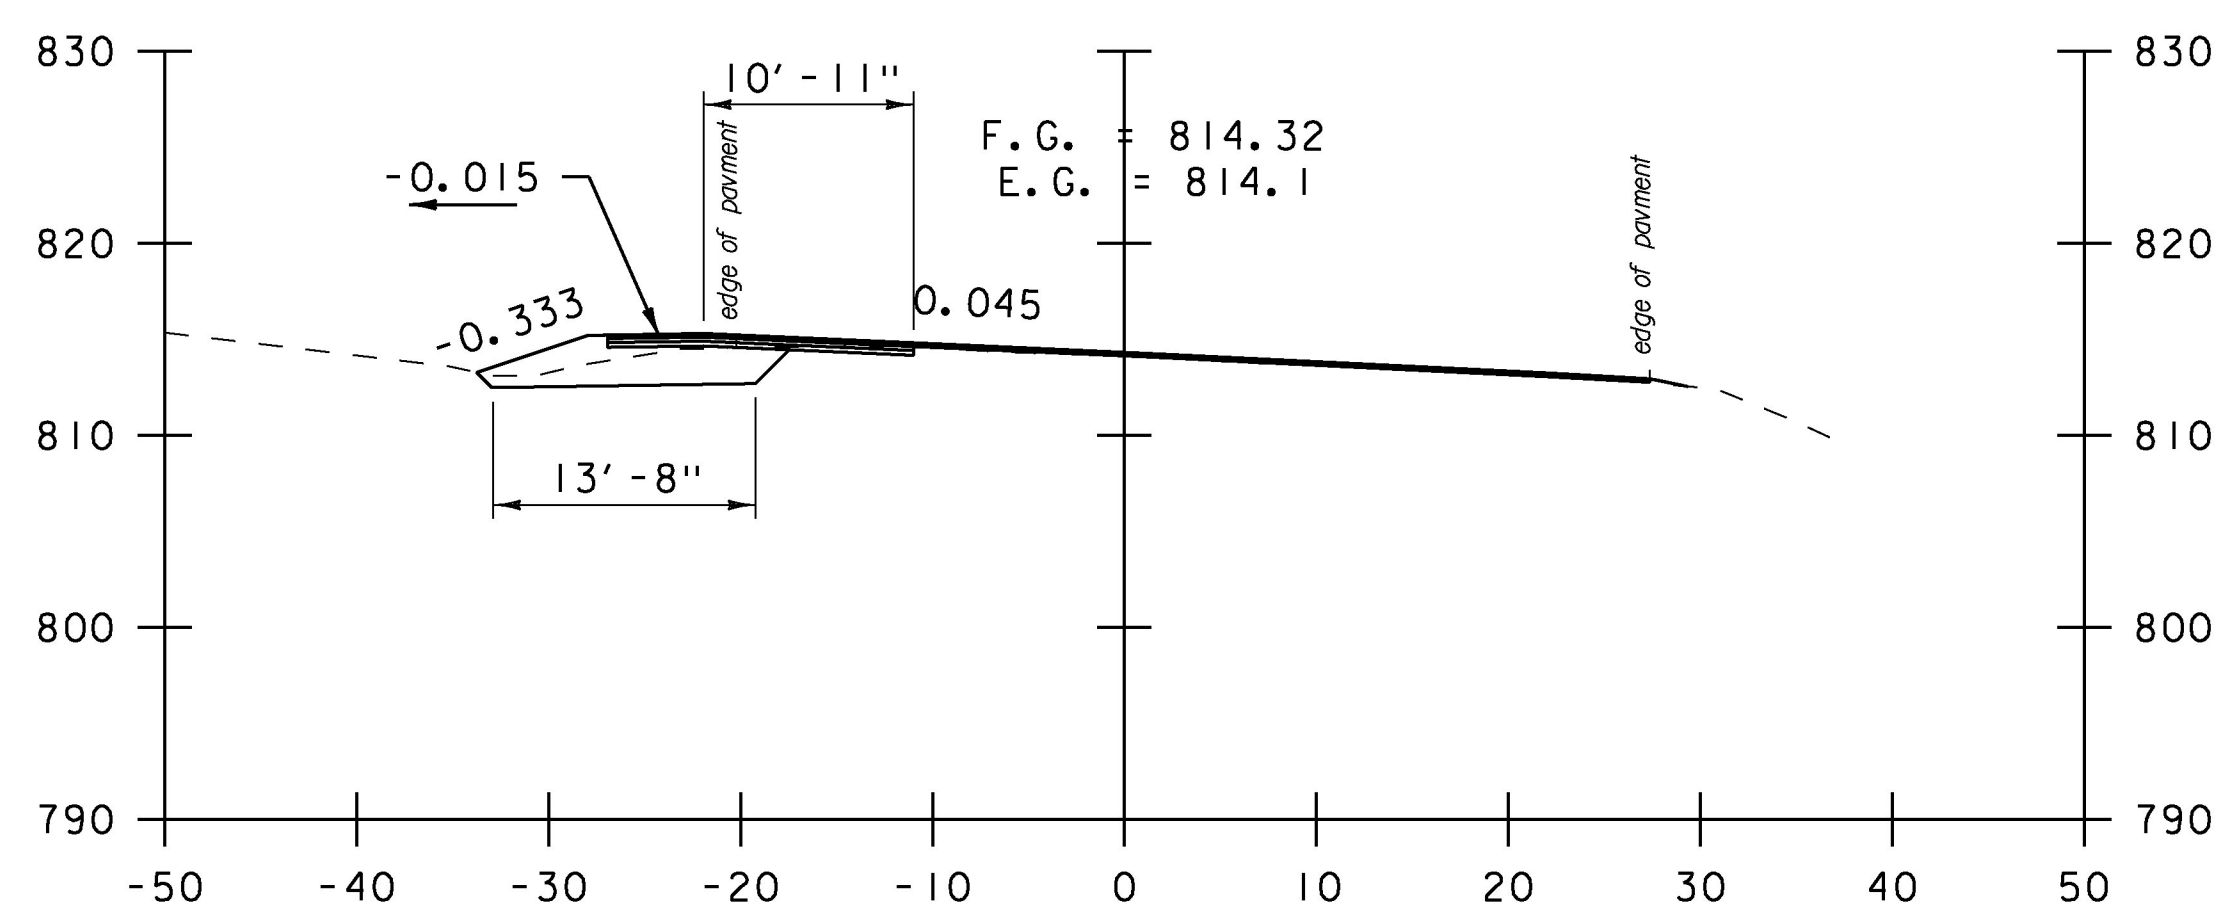

2+25

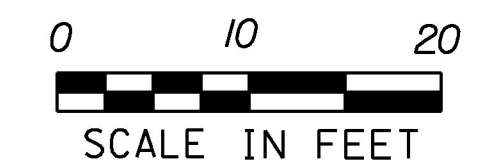

SCALE IN FEET

STA. 1+50 TO STA. 2+50

PROJECT NAME:	NORTHFIELD-WILLIAMSTOWN
PROJECT NUMBER:	STP 2959(1)
FILE NAME:	z15v022xsl.dgn
PROJECT LEADER:	C. LATHROP
DESIGNED BY:	S. SOLLA
CROSS SECTION SHEET 2	
PLOT DATE:	4/26/2016
DRAWN BY:	S. SOLLA
CHECKED BY:	C. LATHROP
SHEET	138 OF 202