




3+25

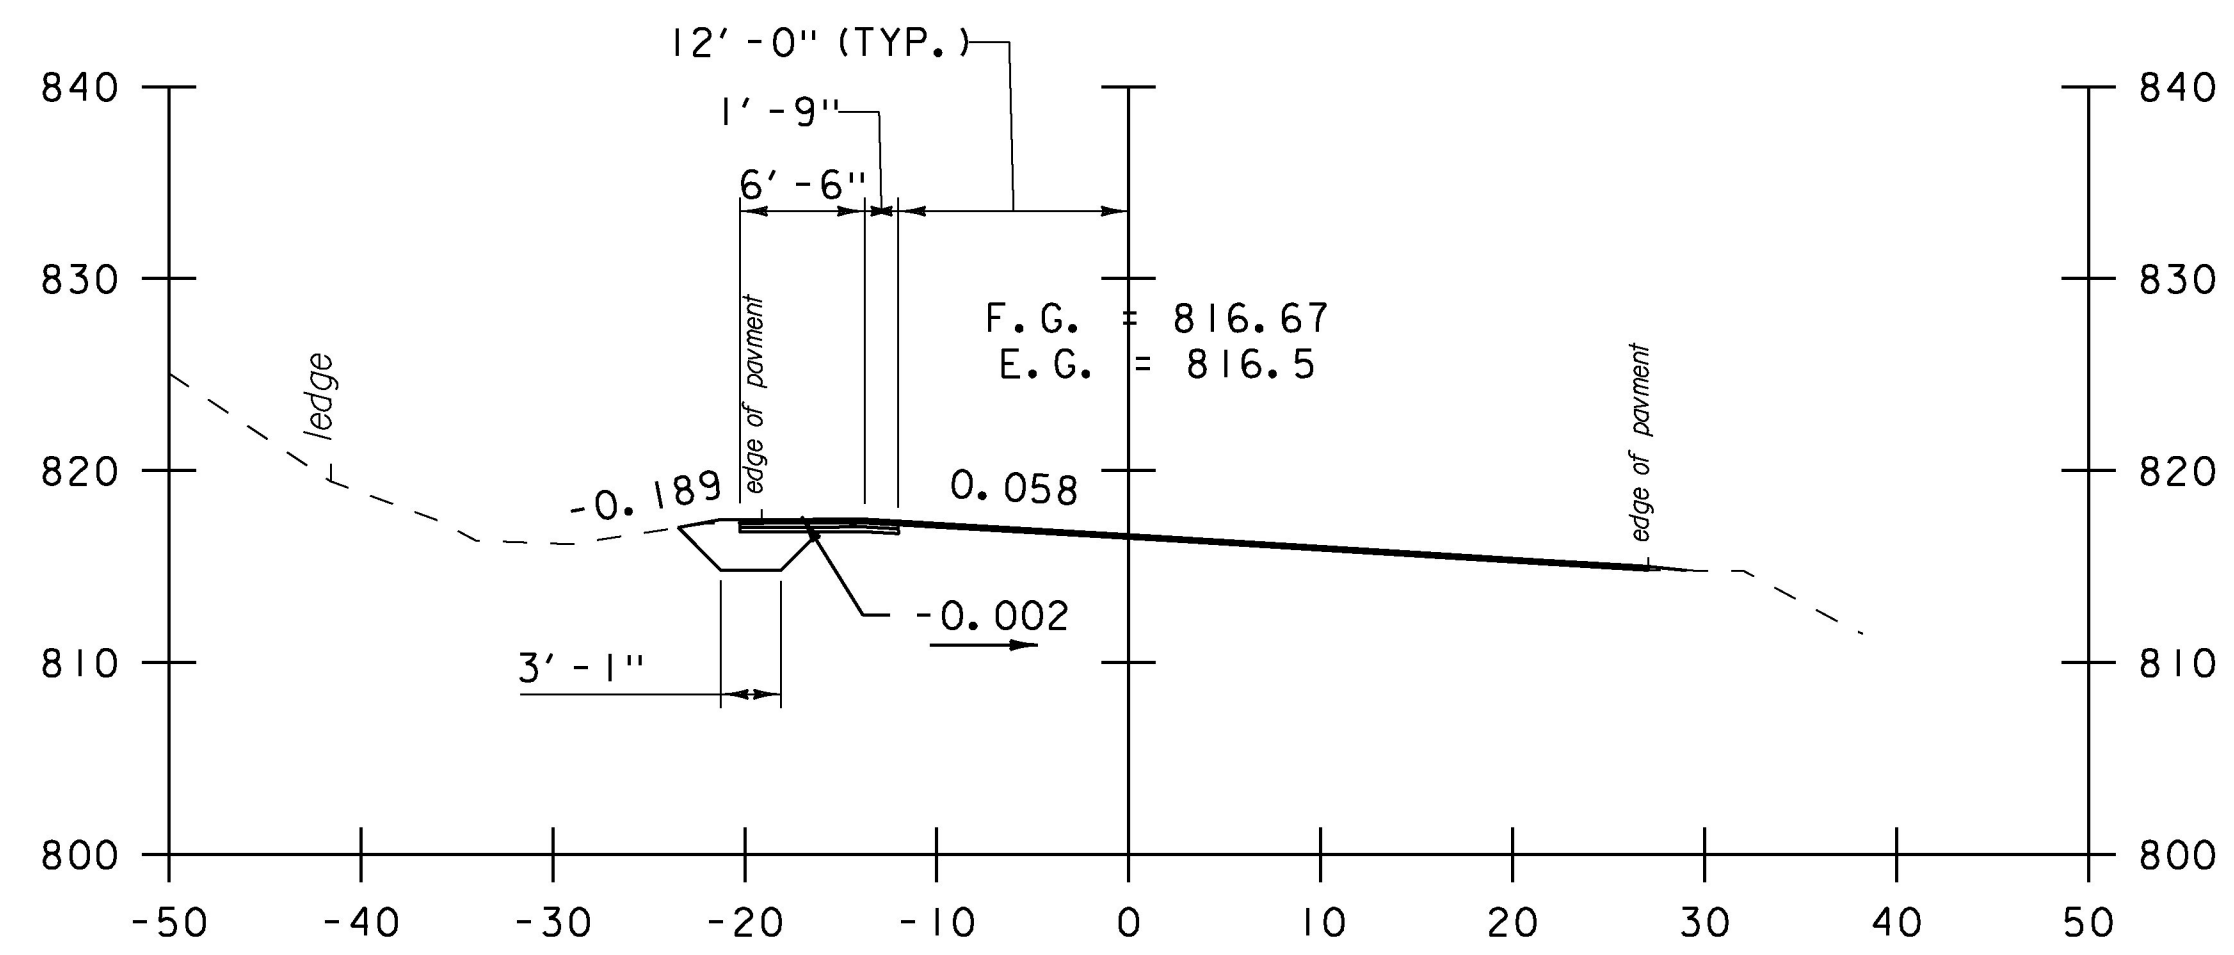


3+00

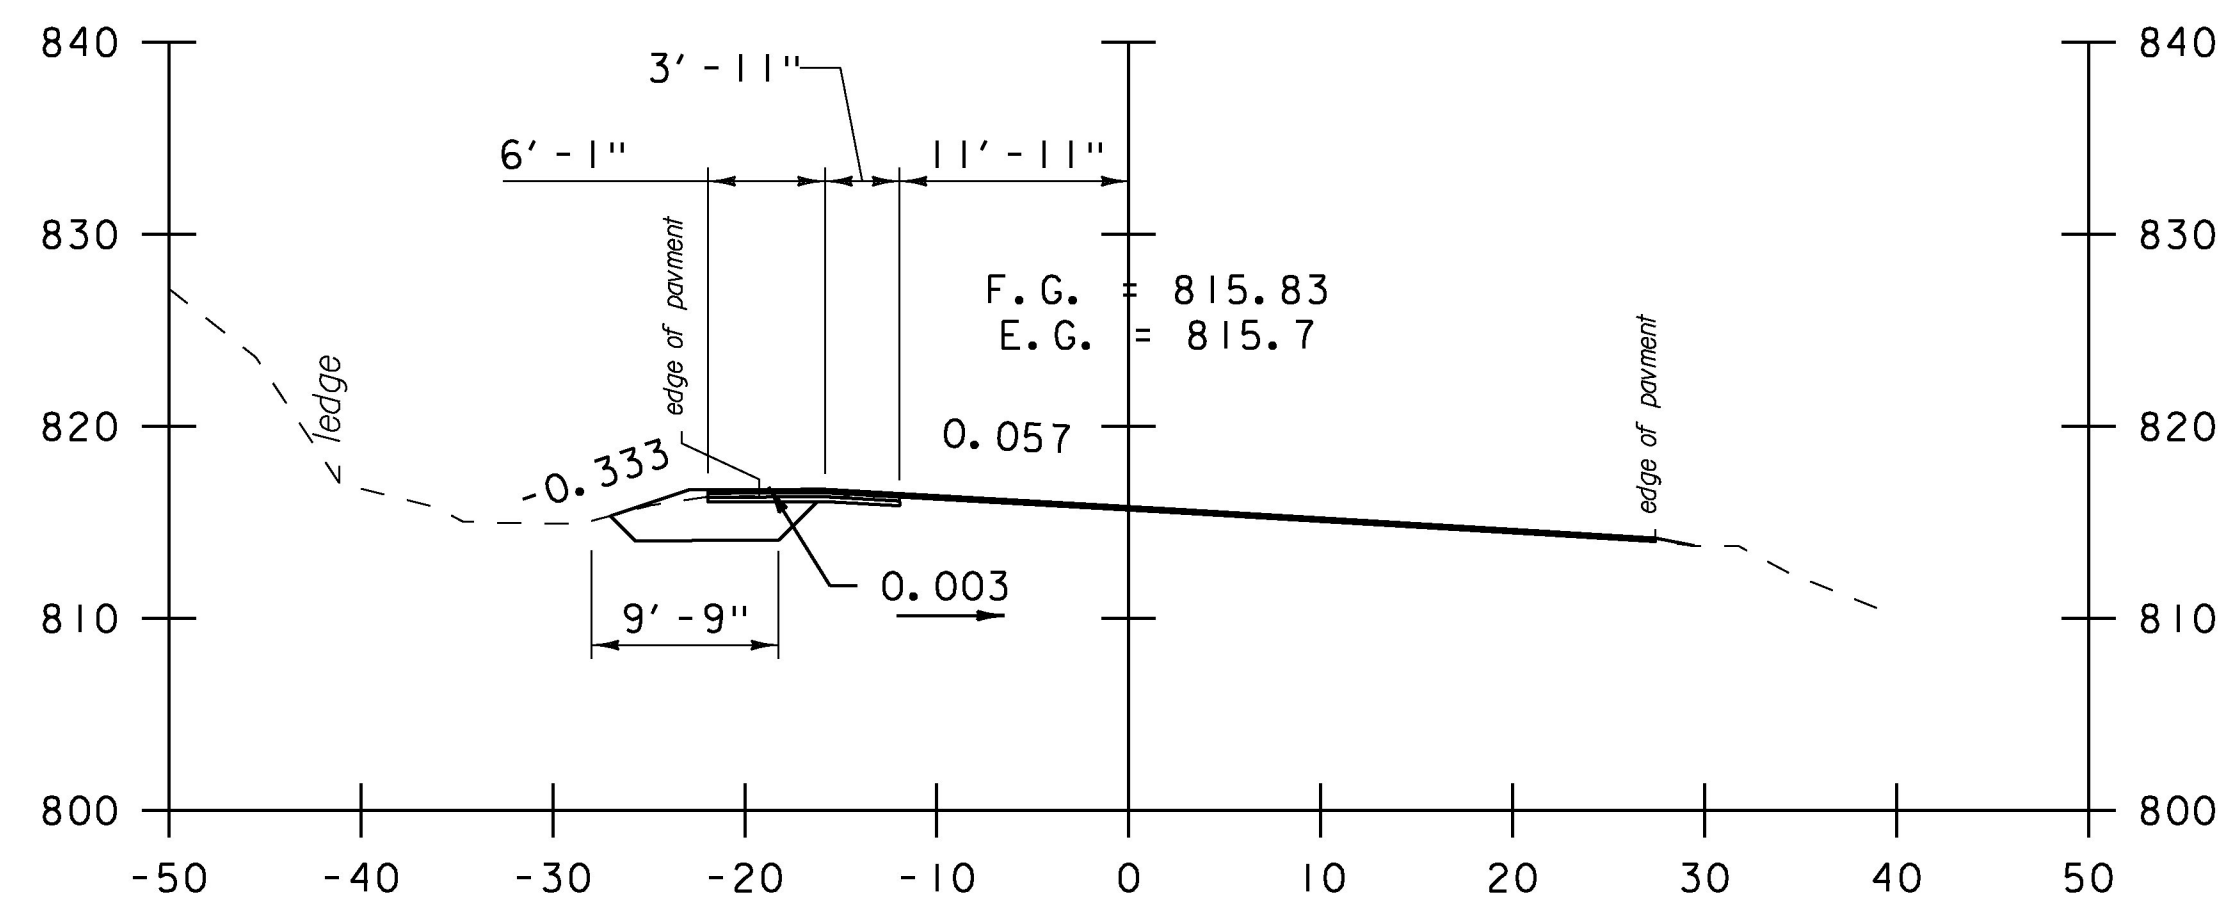


2+75

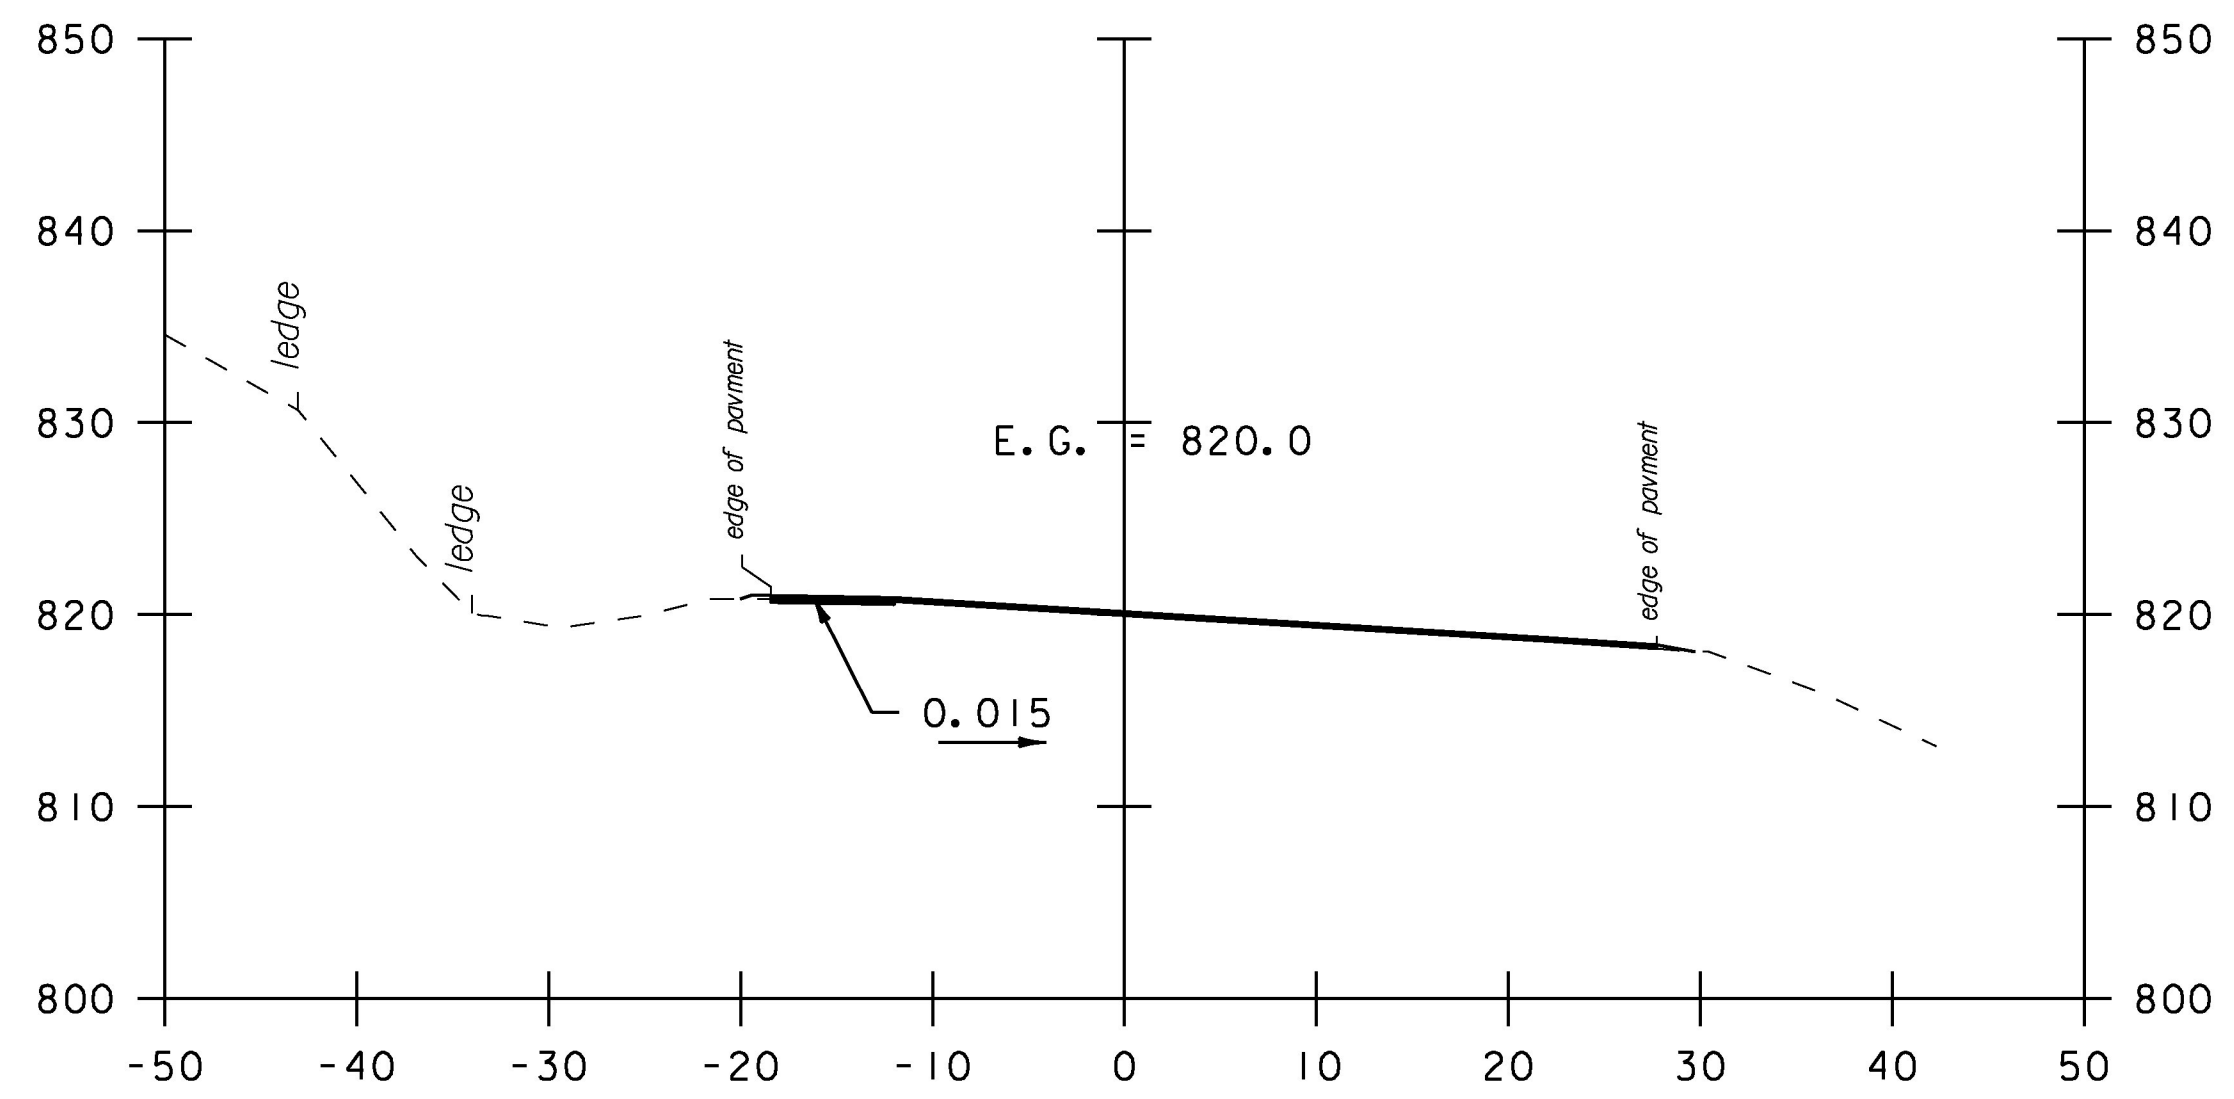

3+75

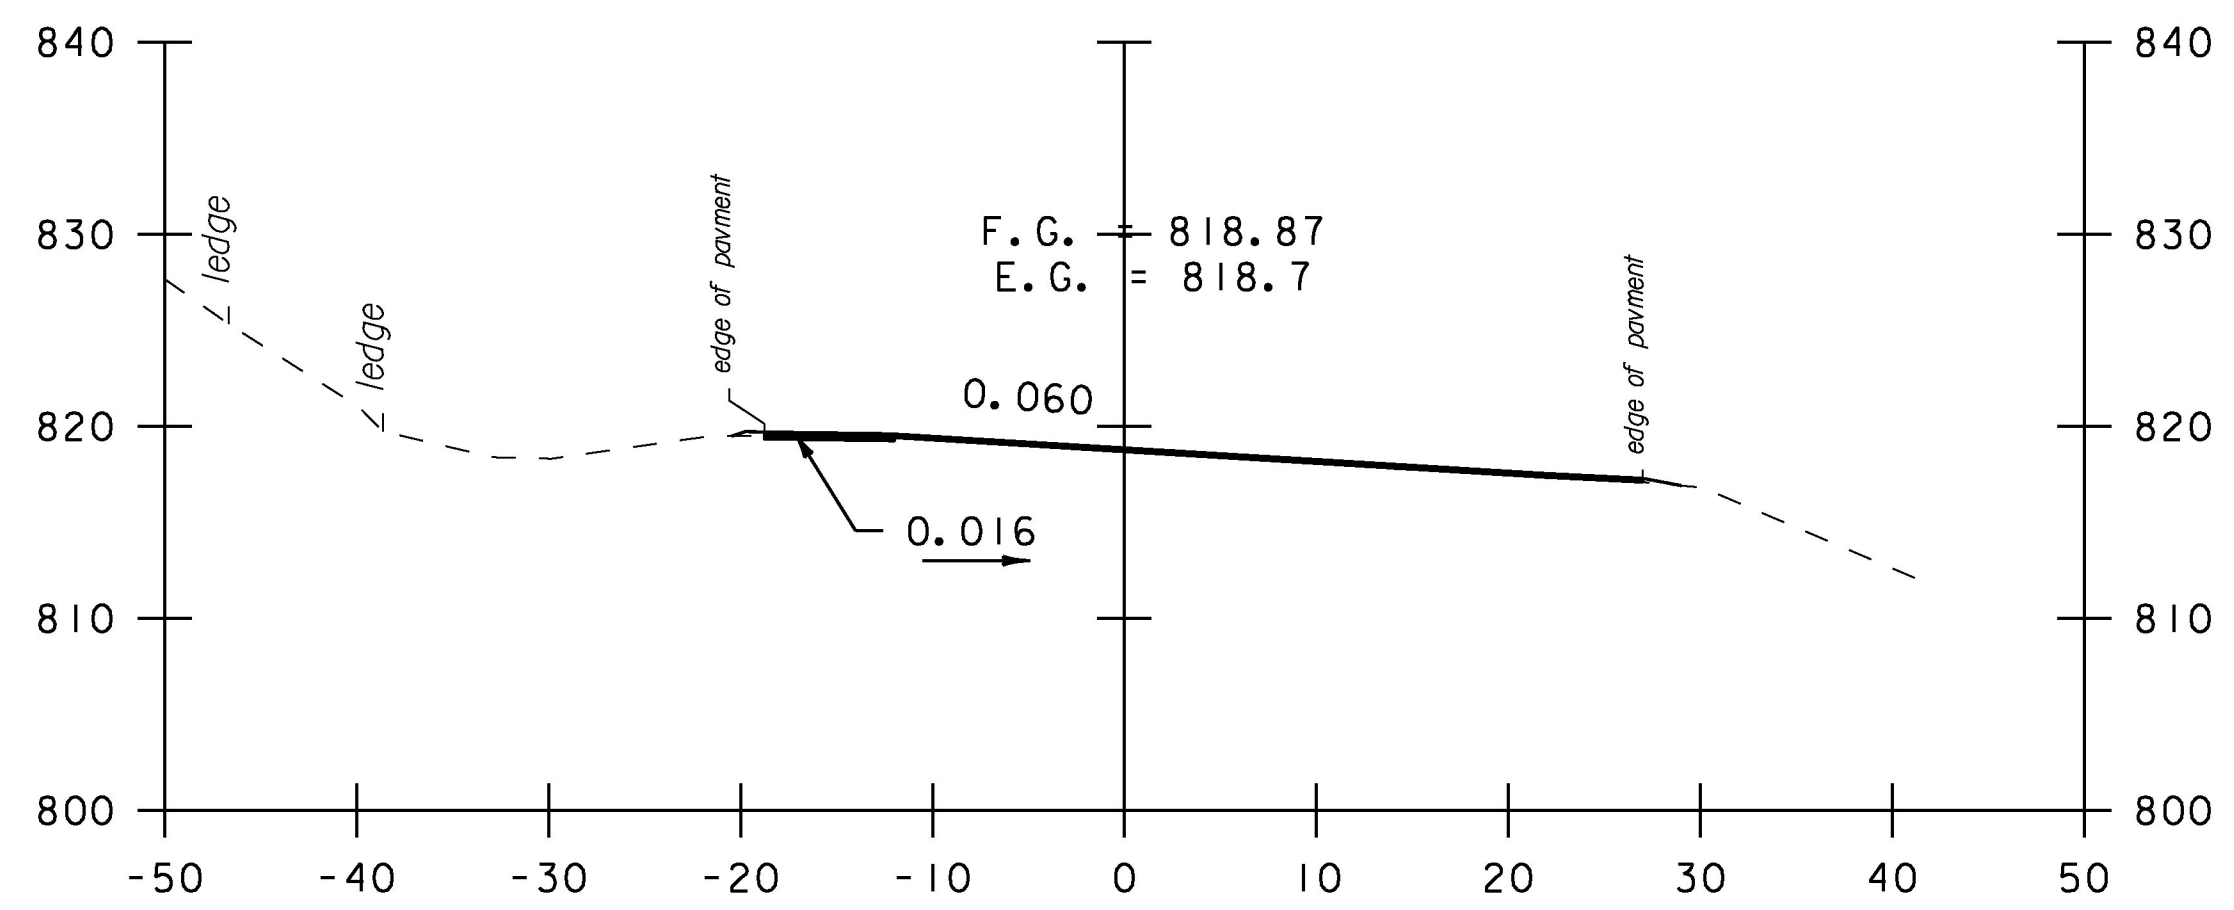

3+50

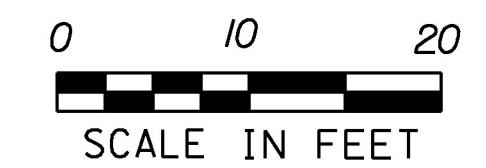

STA. 2+75 TO STA. 3+75

PROJECT NAME: NORTHFIELD-WILLIAMSTOWN	PLOT DATE: 4/26/2016
PROJECT NUMBER: STP 2959(I)	DRAWN BY: S. SOLLA
FILE NAME: z15v022xsl.dgn	CHECKED BY: C. LATHROP
DESIGNED BY: S. SOLLA	SHEET 139 OF 202
CROSS SECTION SHEET 3	