


ROUTE 65

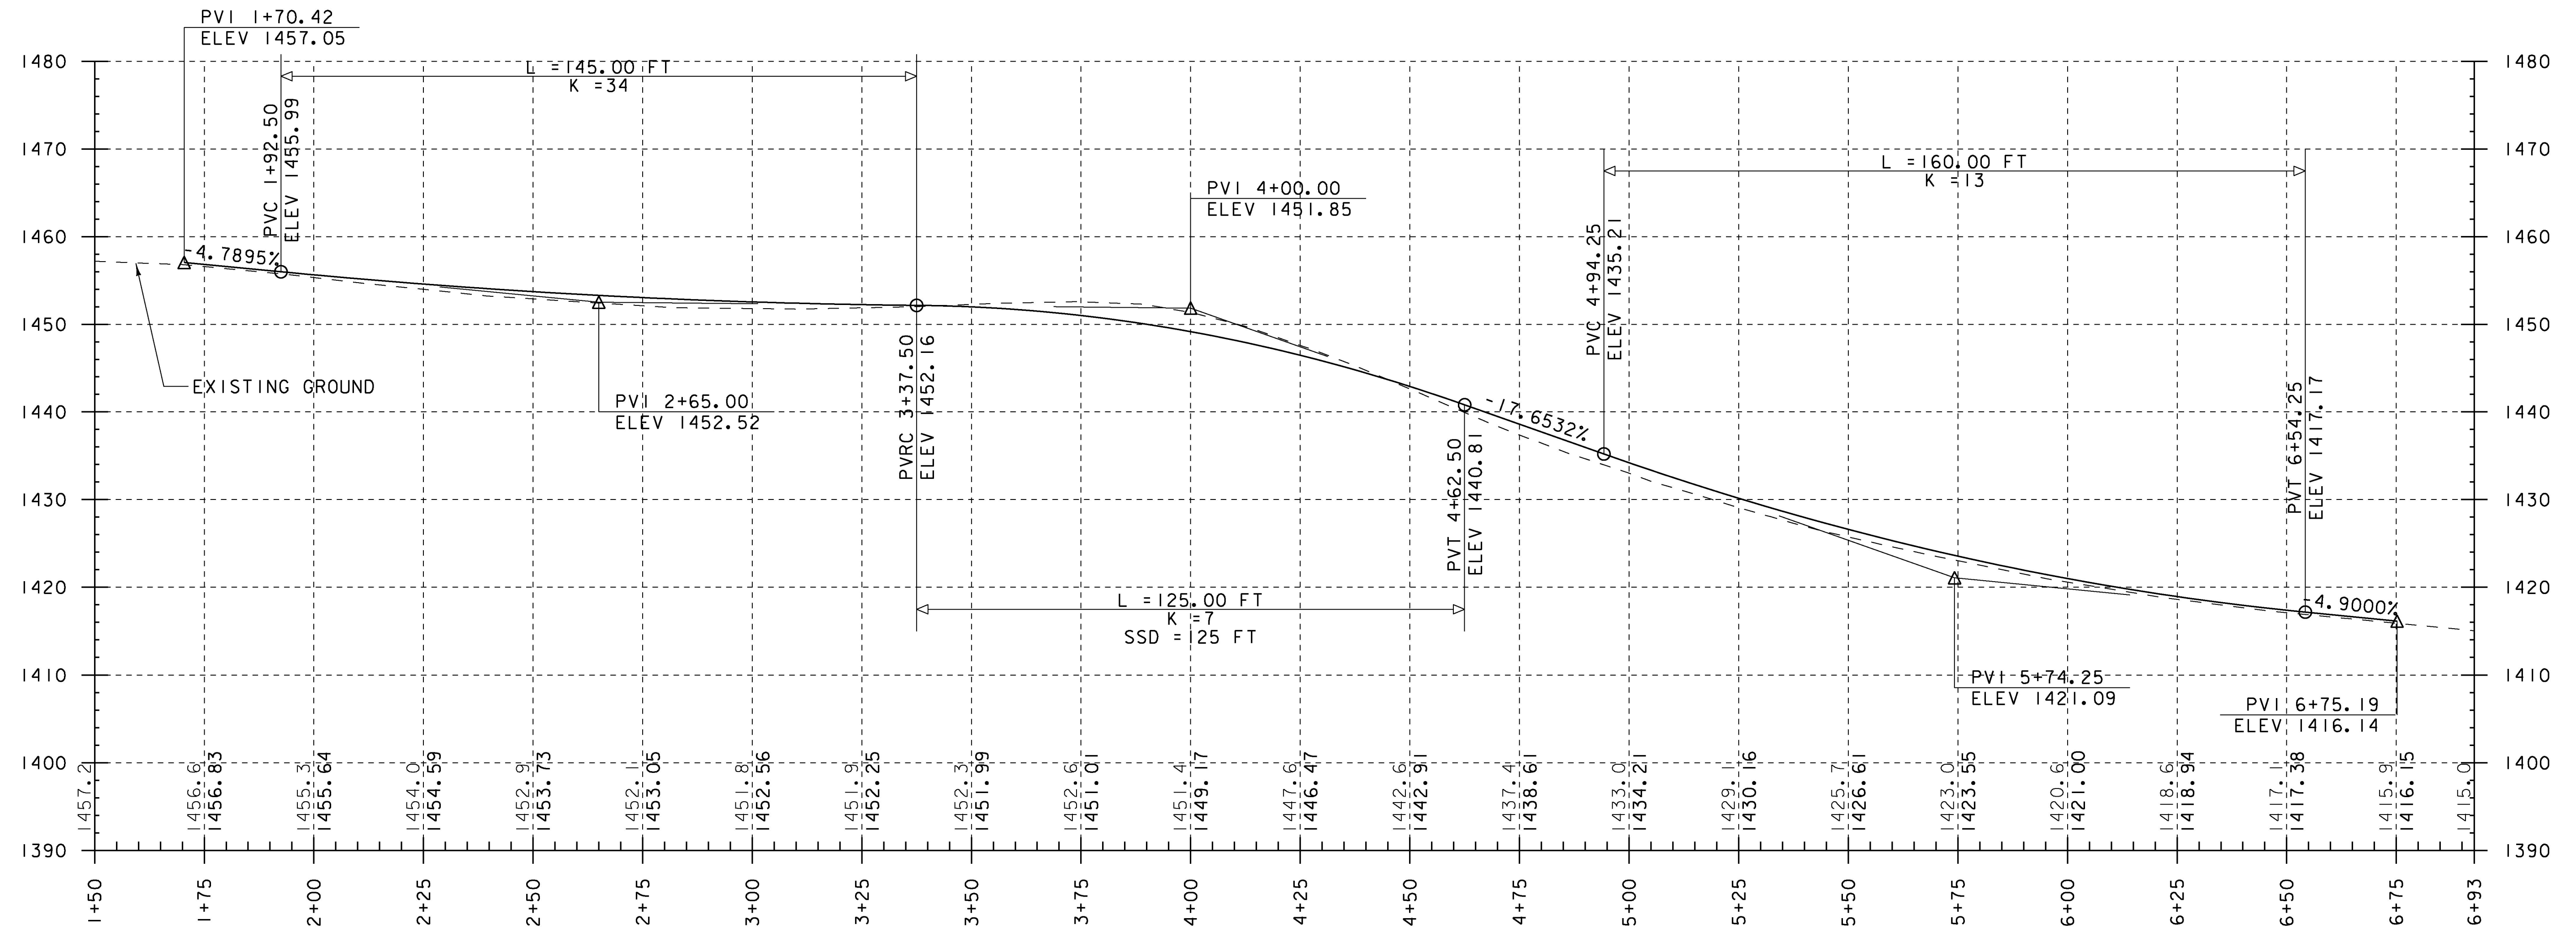

PROJECT NAME:	BROOKFIELD
PROJECT NUMBER:	STP 2960(I)
FILE NAME:	z15v023pro.dgn
PROJECT LEADER:	C. LATHROP
DESIGNED BY:	S. SOLLA
PROFILE SHEET I	
PLOT DATE:	4/26/2016
DRAWN BY:	S. SOLLA
CHECKED BY:	C. LATHROP
SHEET	174 OF 202