




6+00

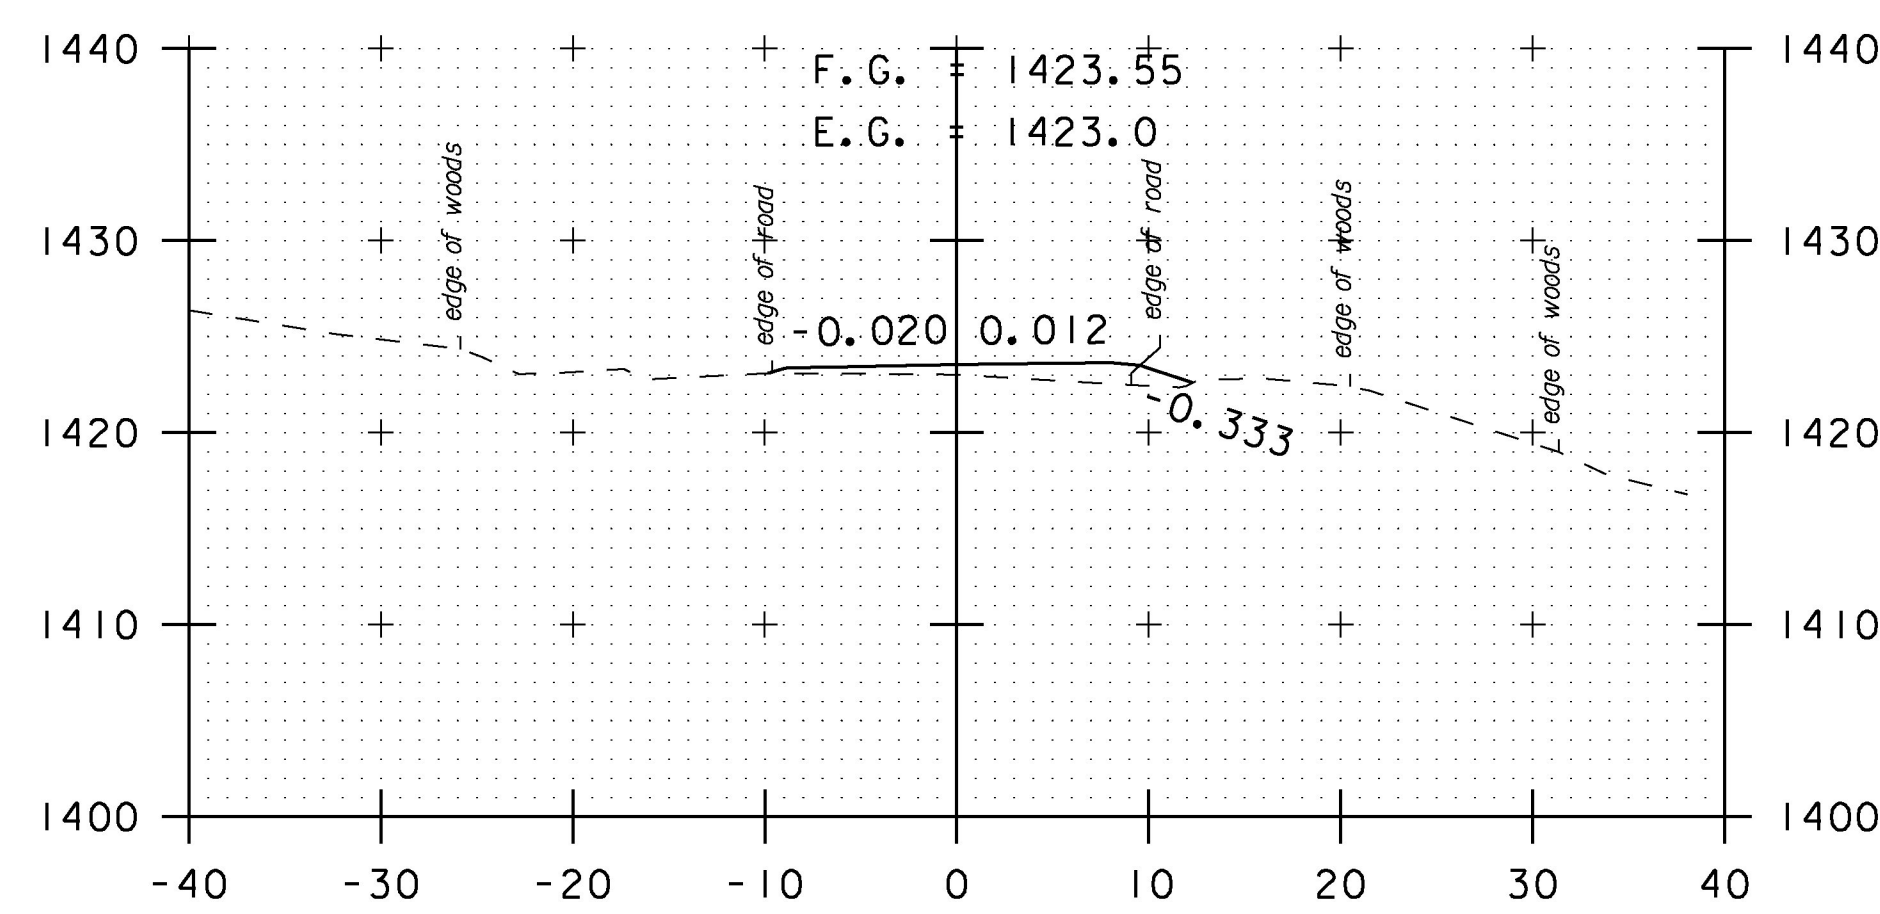


6+50

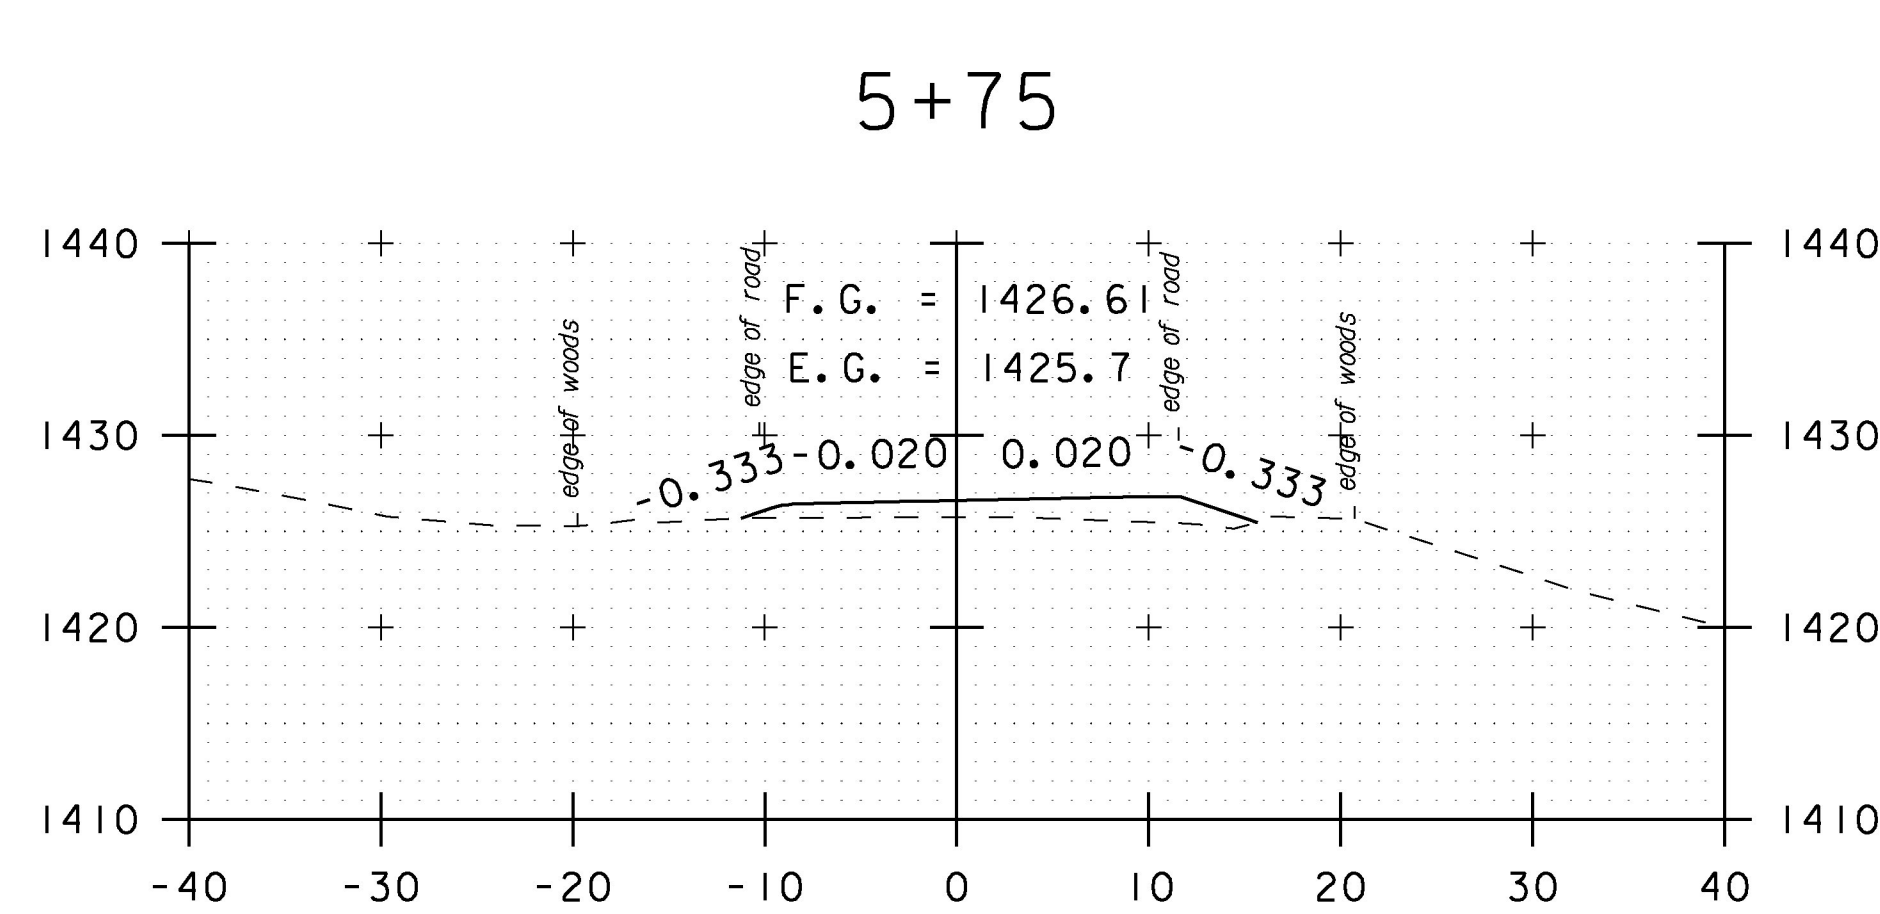



5+50

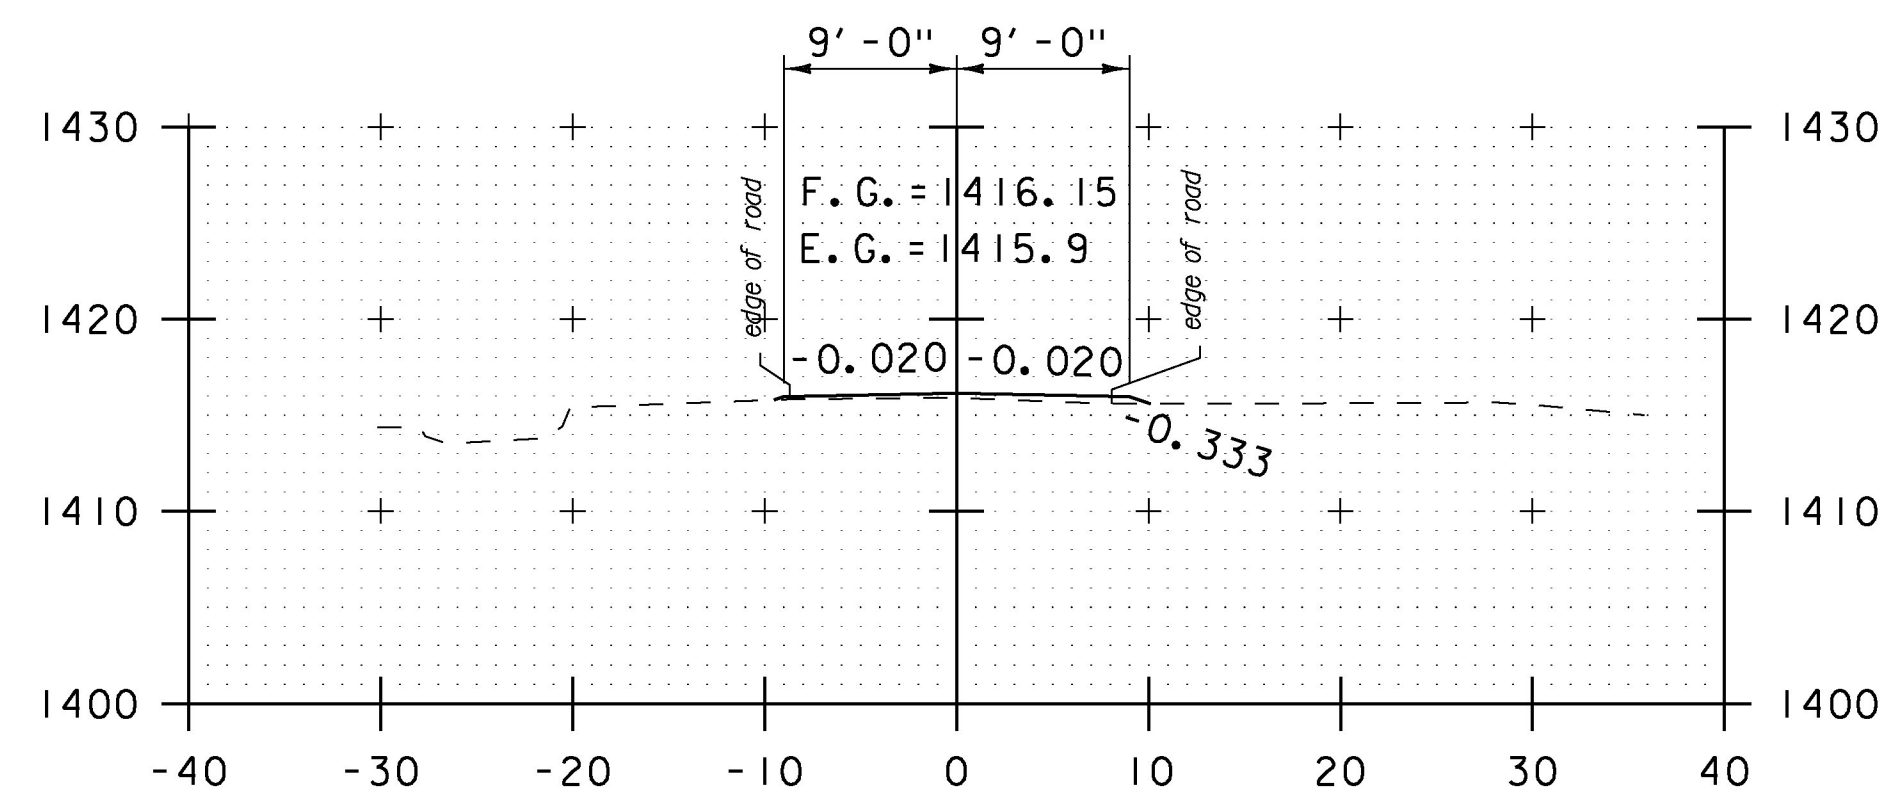

6+75

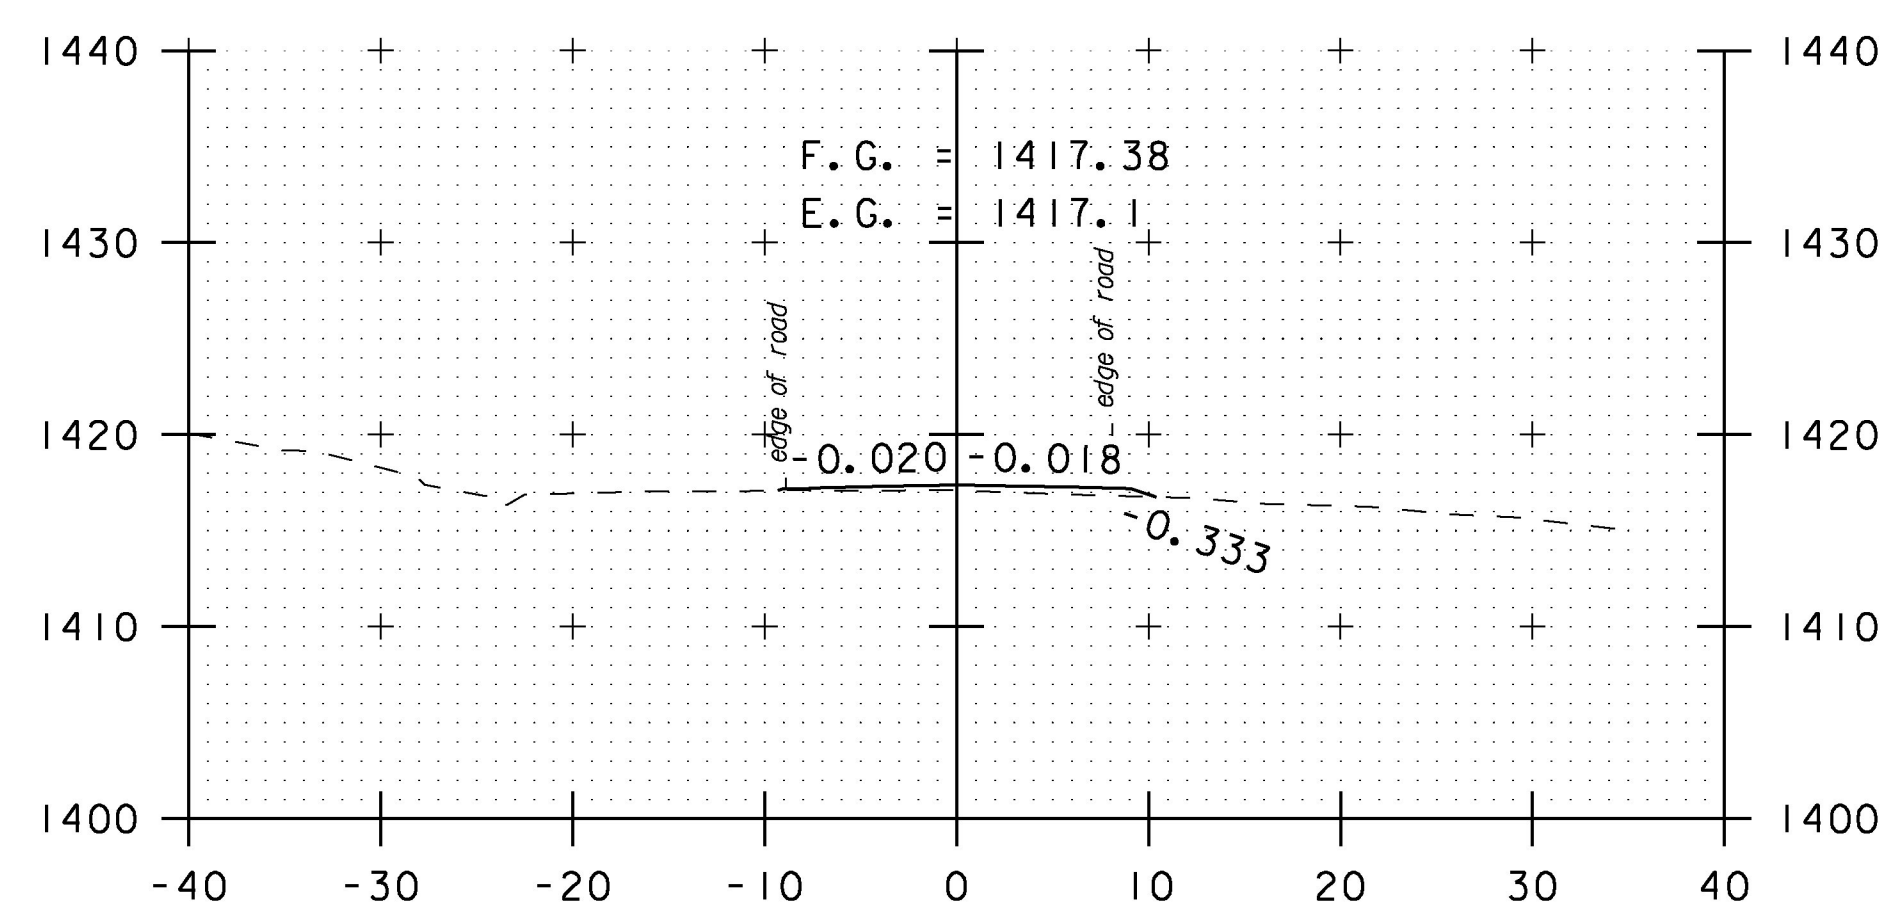


6+25

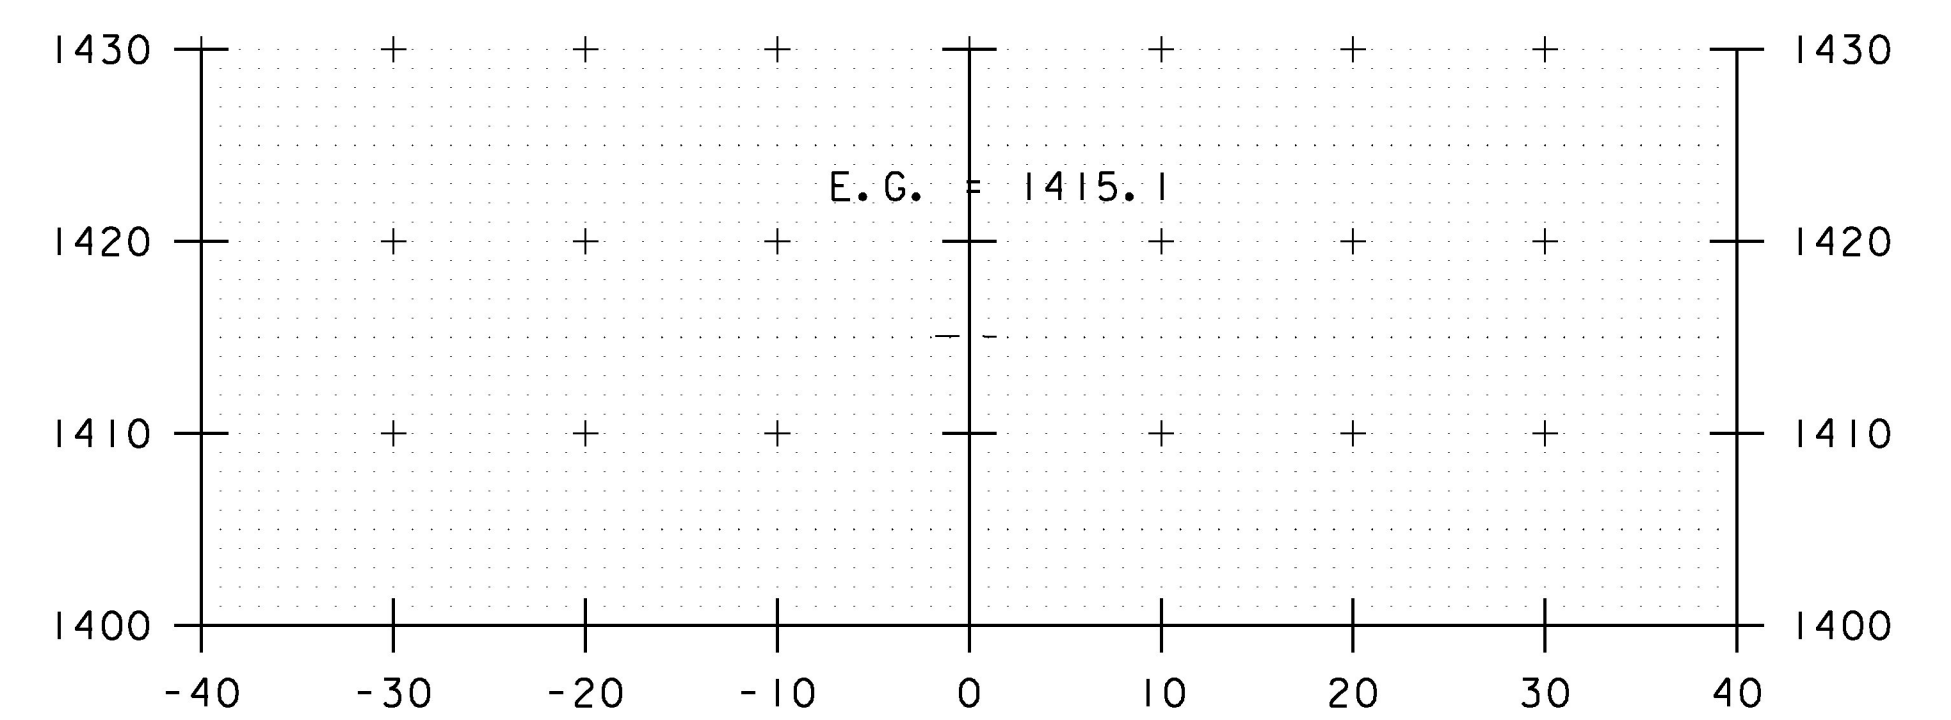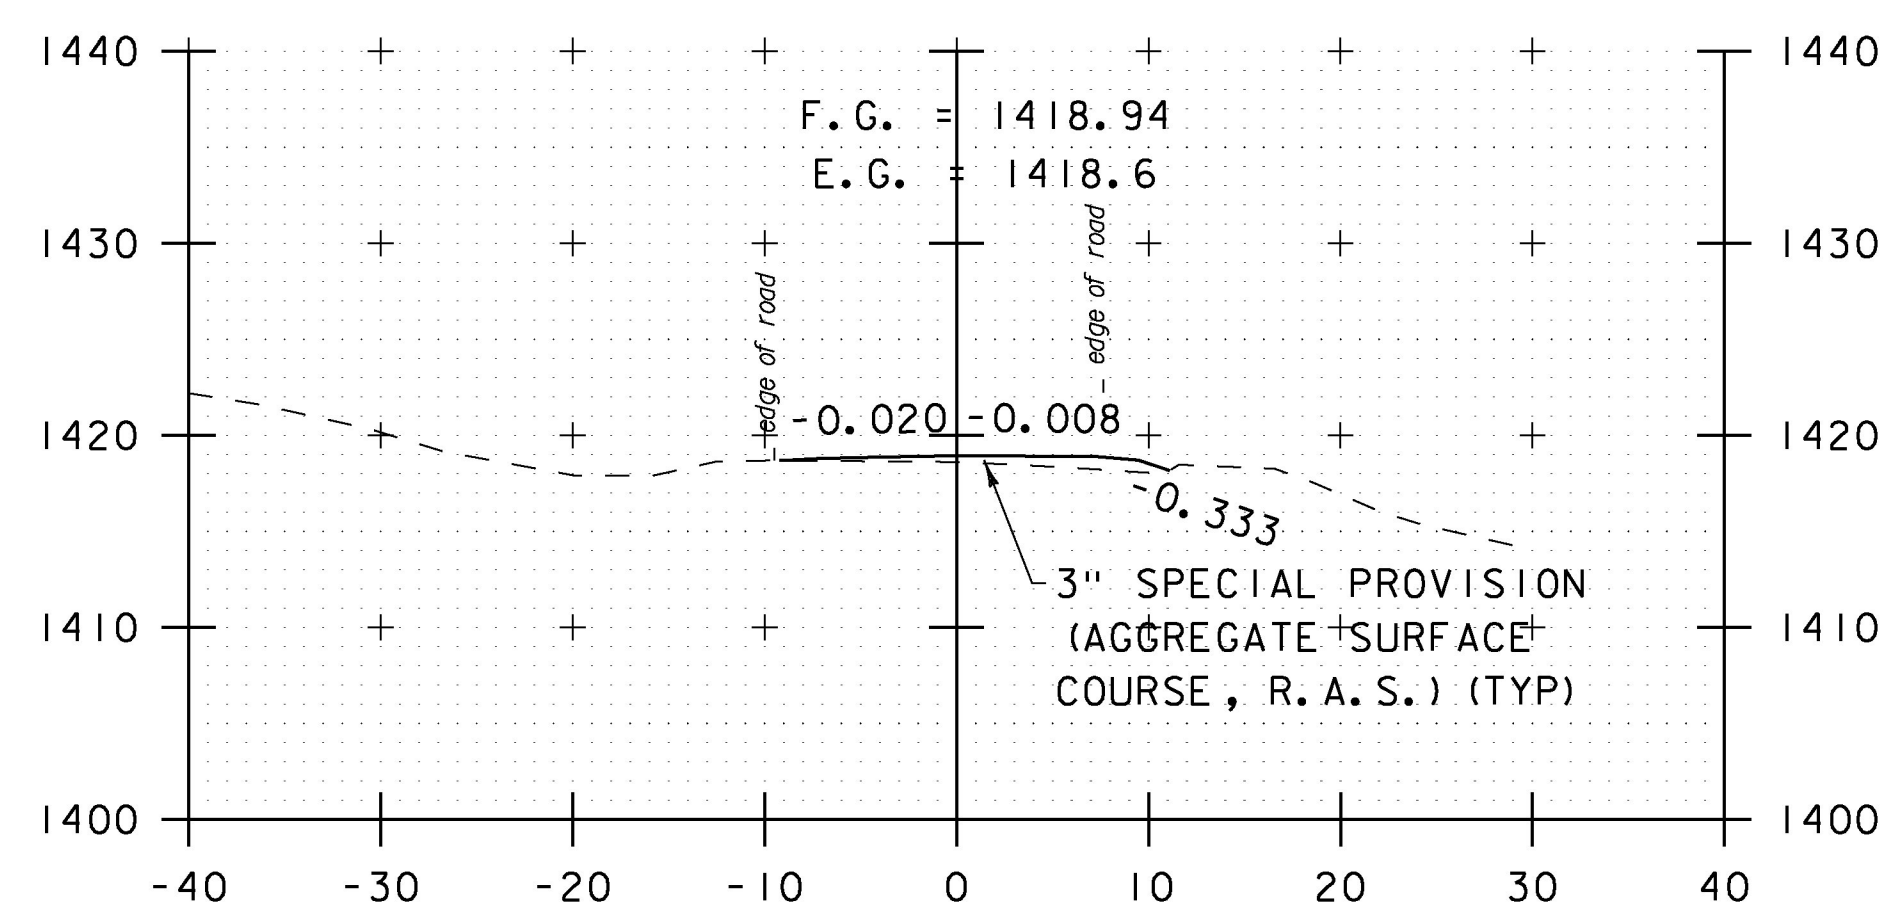

6+92

NOTE:
STA. 1+50 IS EQUAL TO MM 2.374

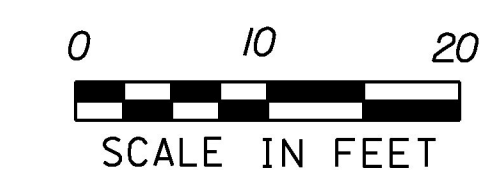

SCALE IN FEET
STA. 5+50 TO STA. 6+93

PROJECT NAME: BROOKFIELD	PLOT DATE: 4/26/2016
PROJECT NUMBER: STP 2960(I)	DRAWN BY: S. SOLLA
FILE NAME: z15v023xsl.dgn	CHECKED BY: C. LATHROP
DESIGNED BY: S. SOLLA	SHEET 178 OF 202
VT 65 CROSS SECTIONS SHEET 3	