




10+50

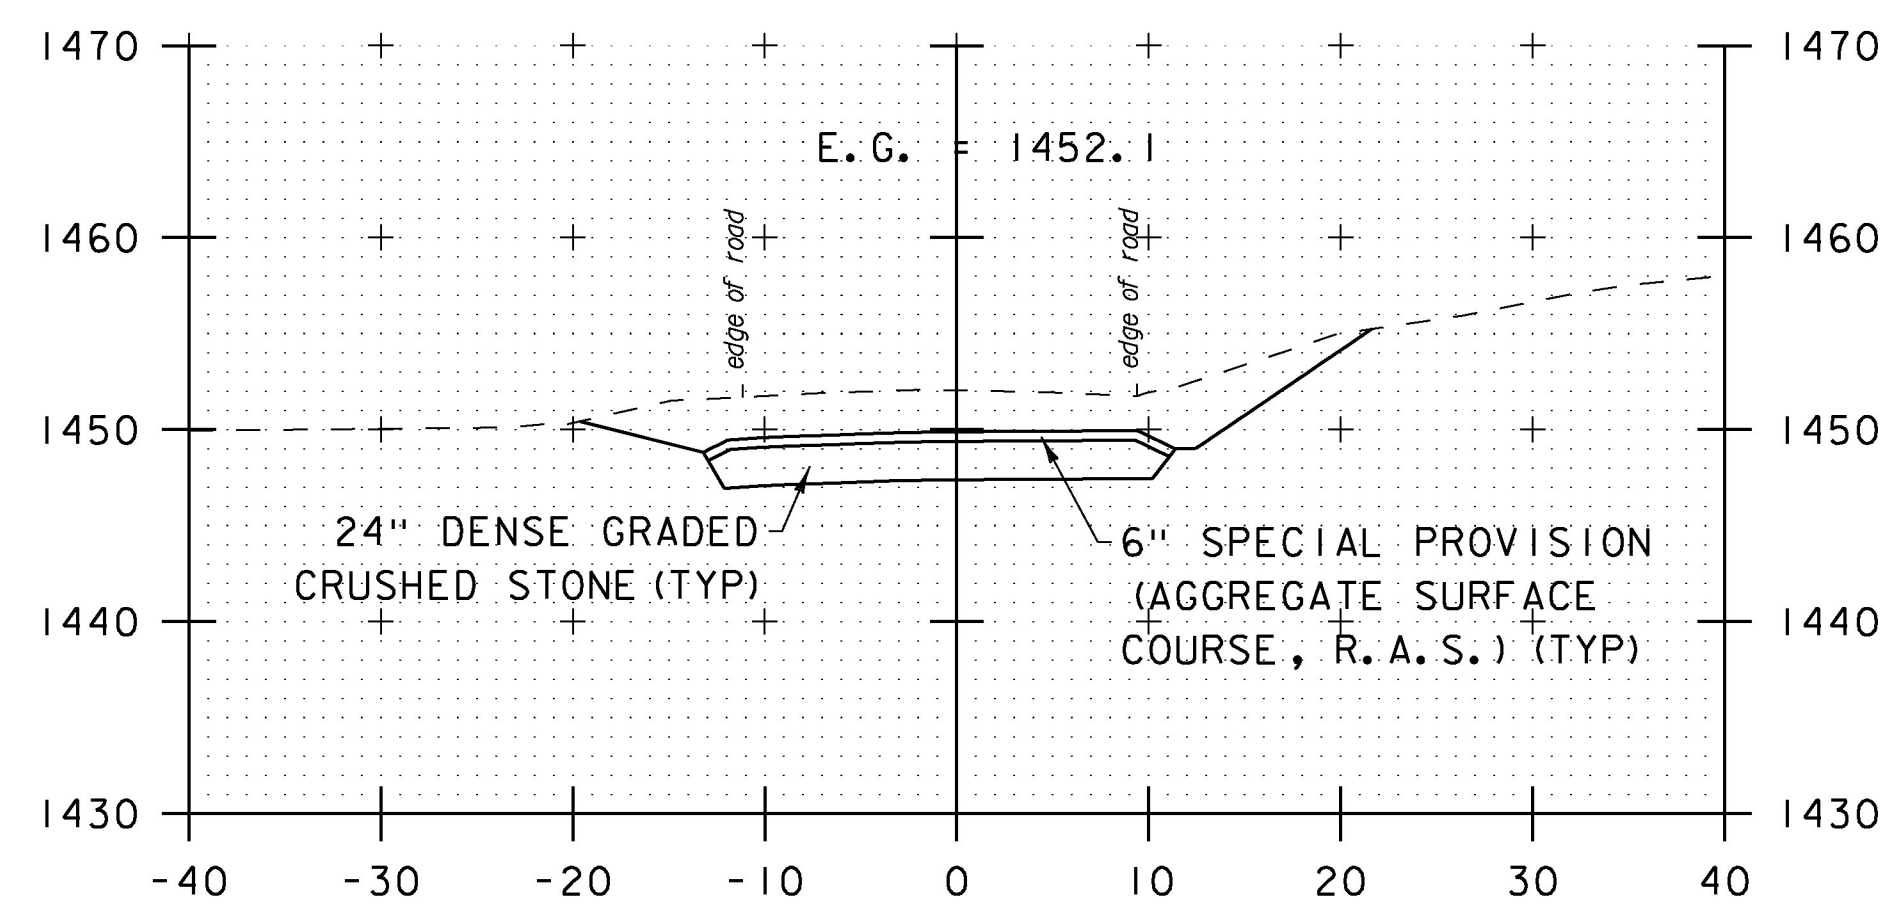


10+25

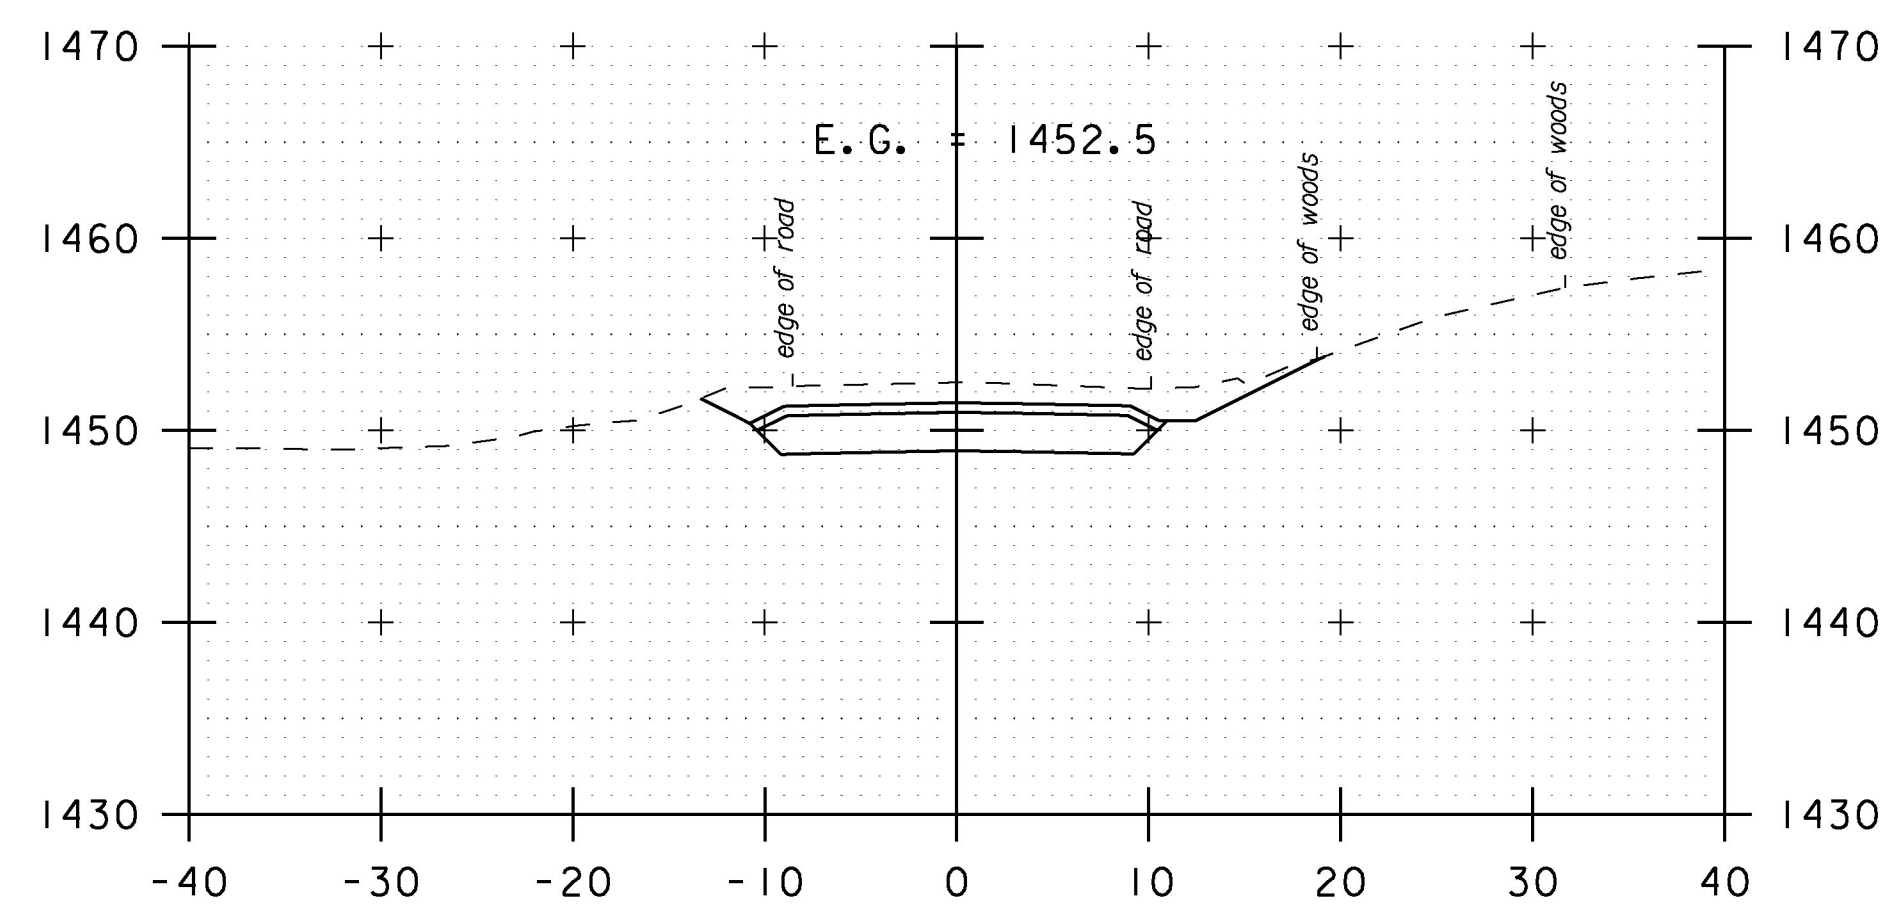


10+00

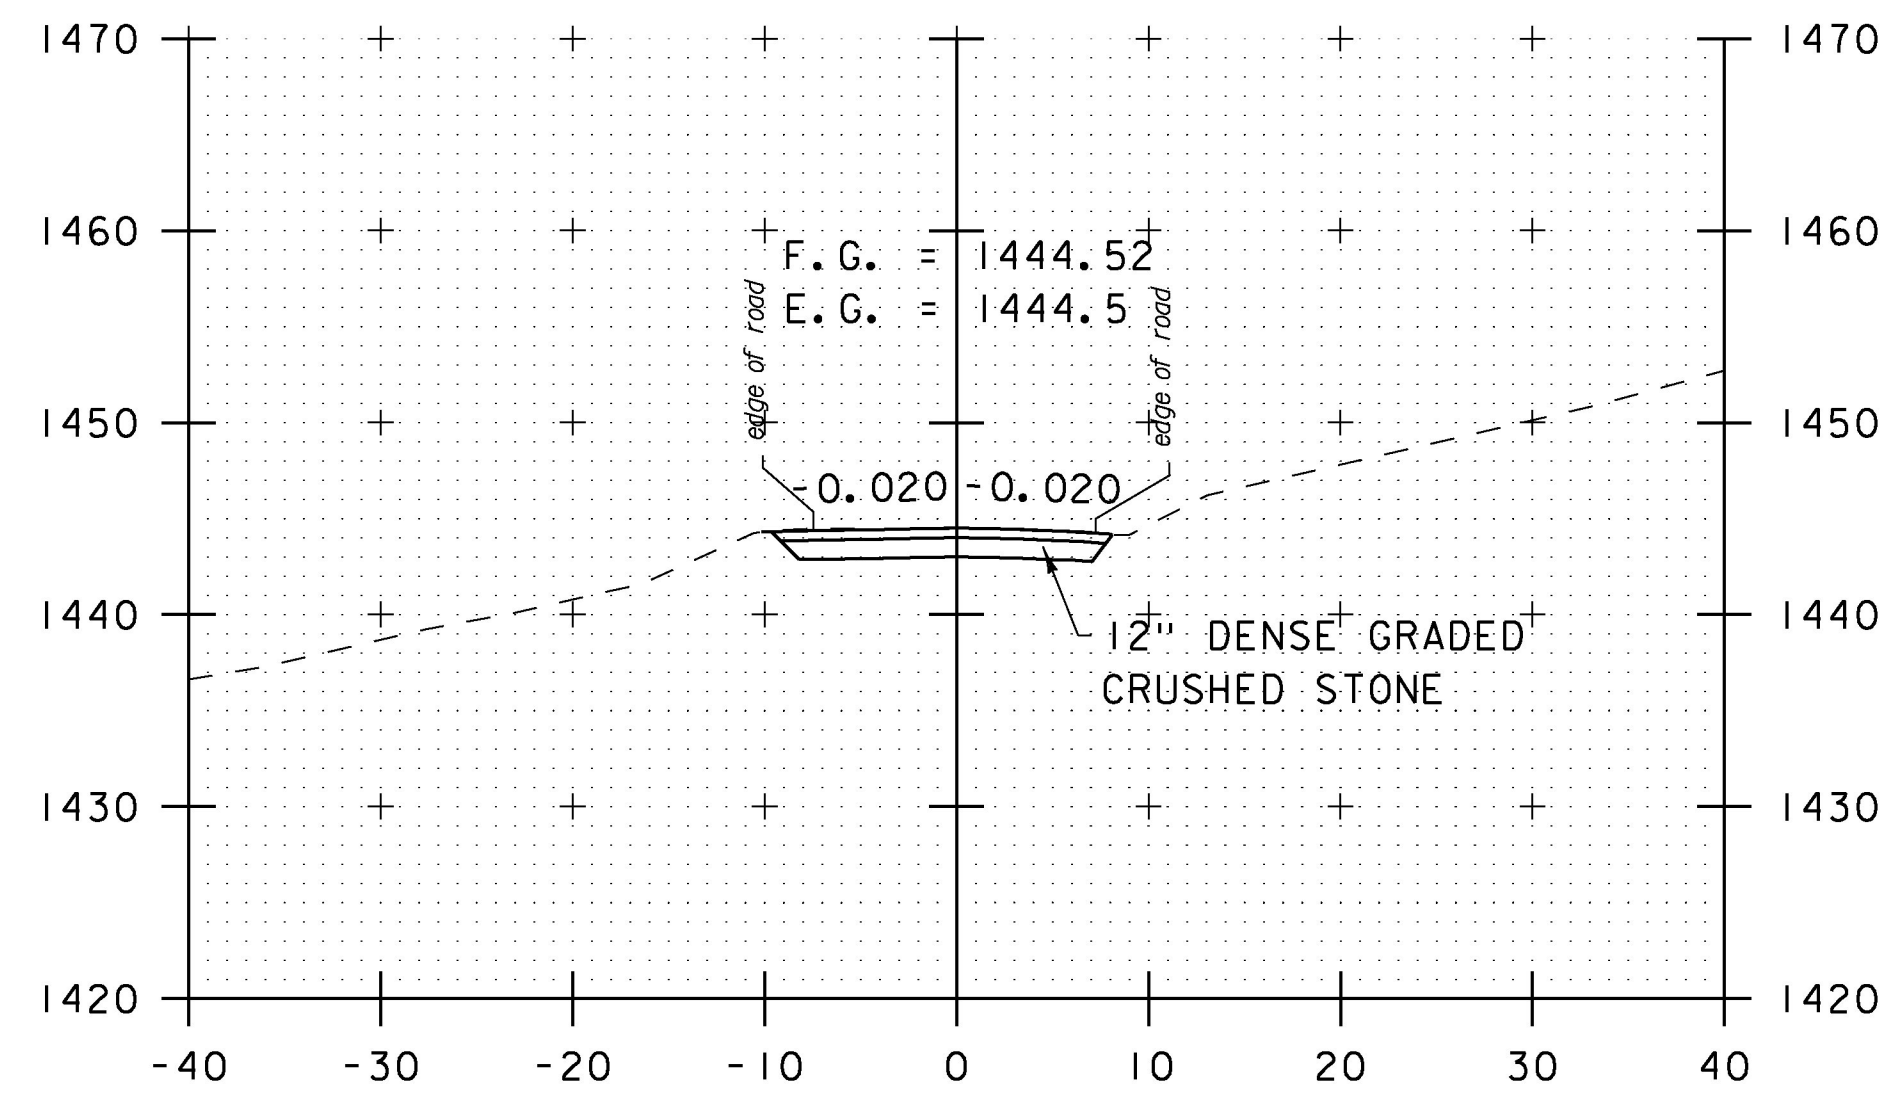


11+00

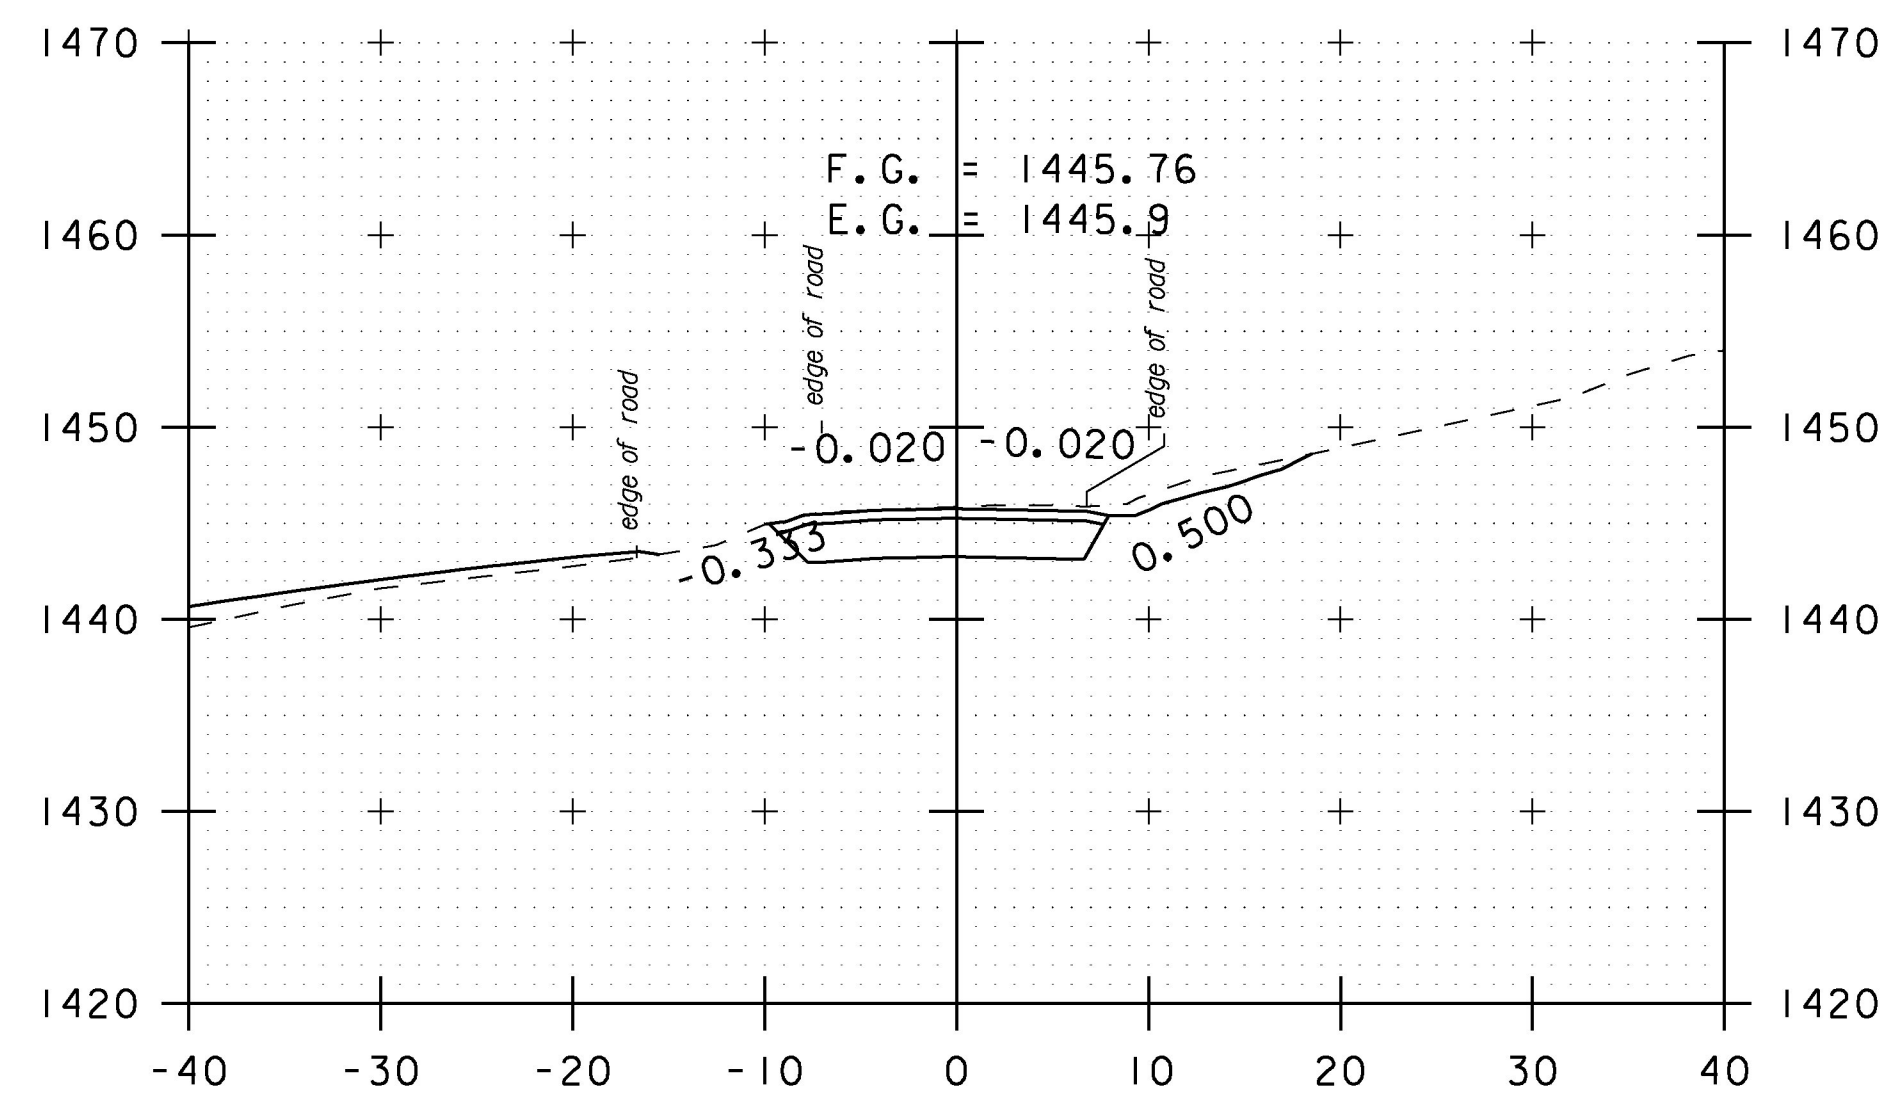


10+75

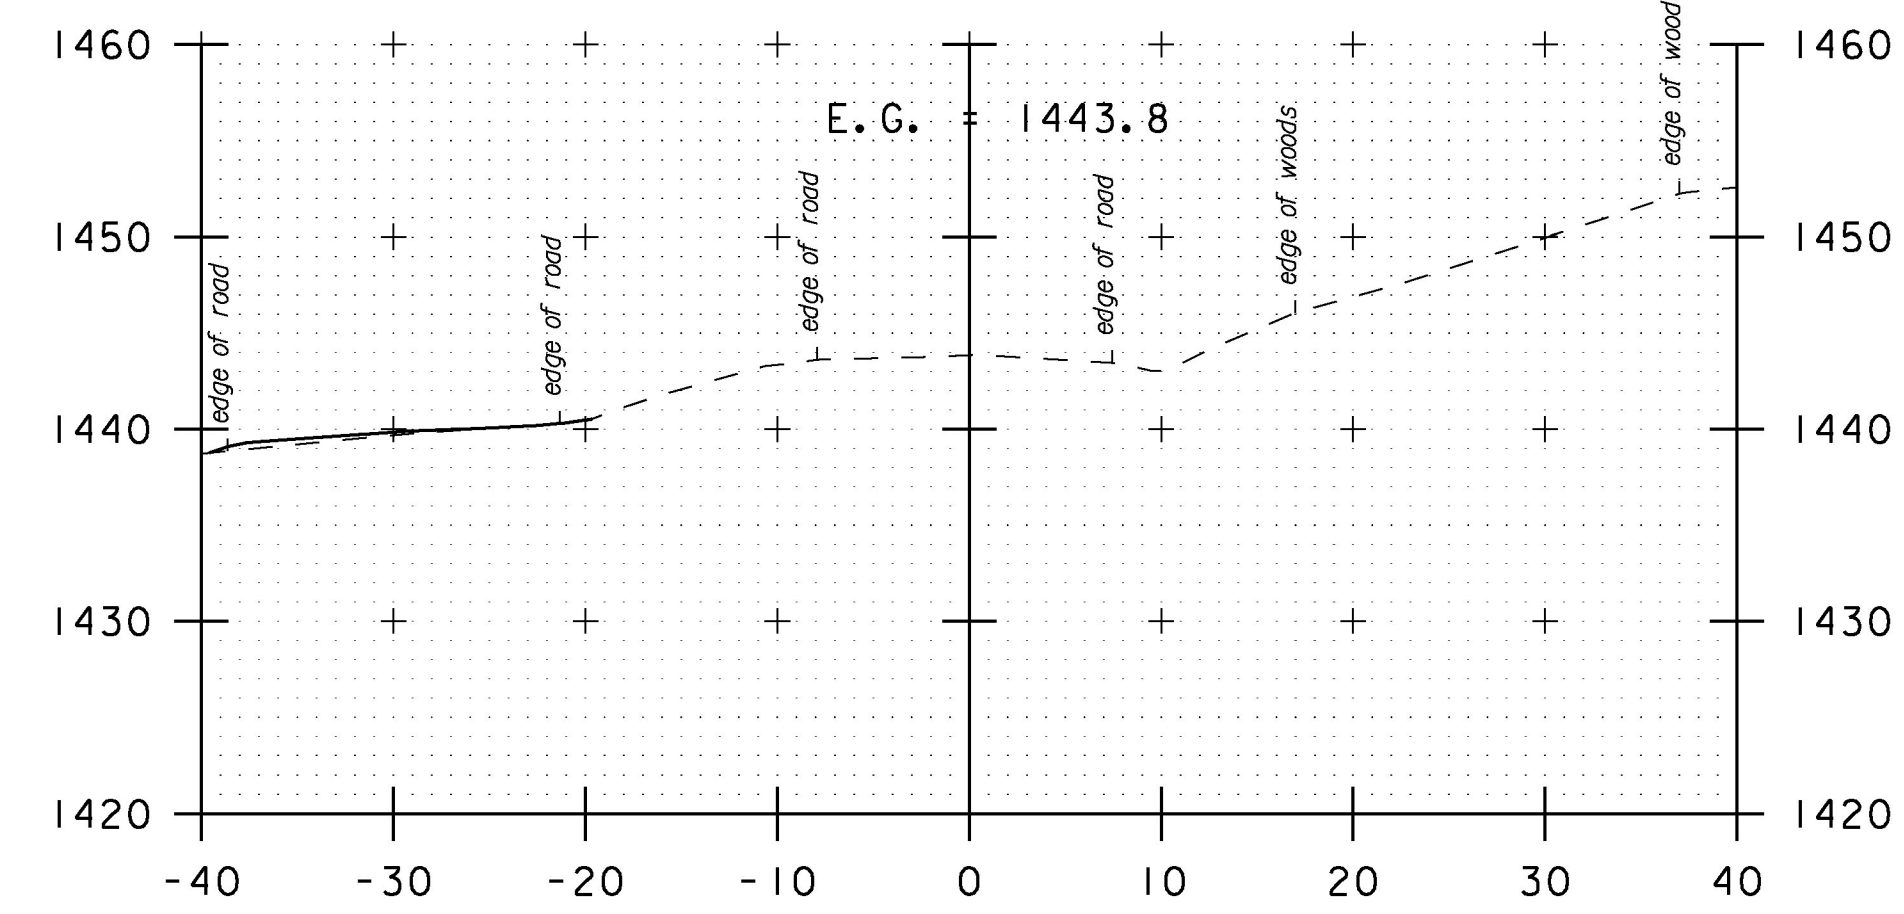


11+50

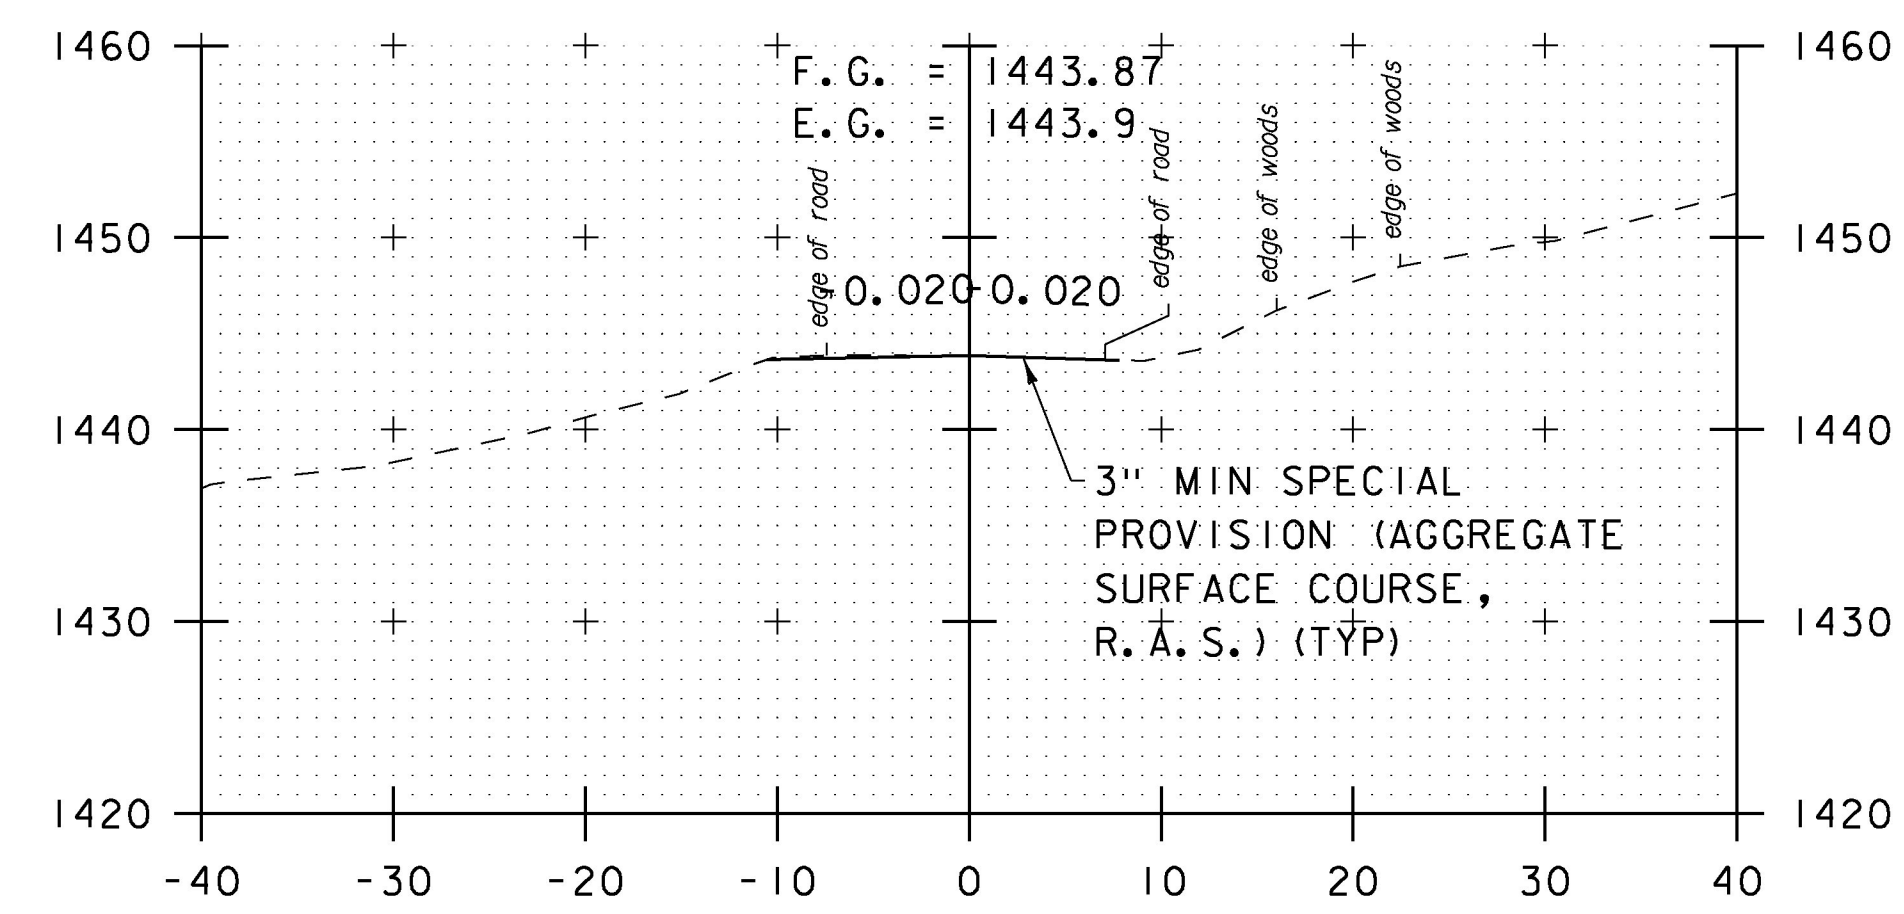

11+25

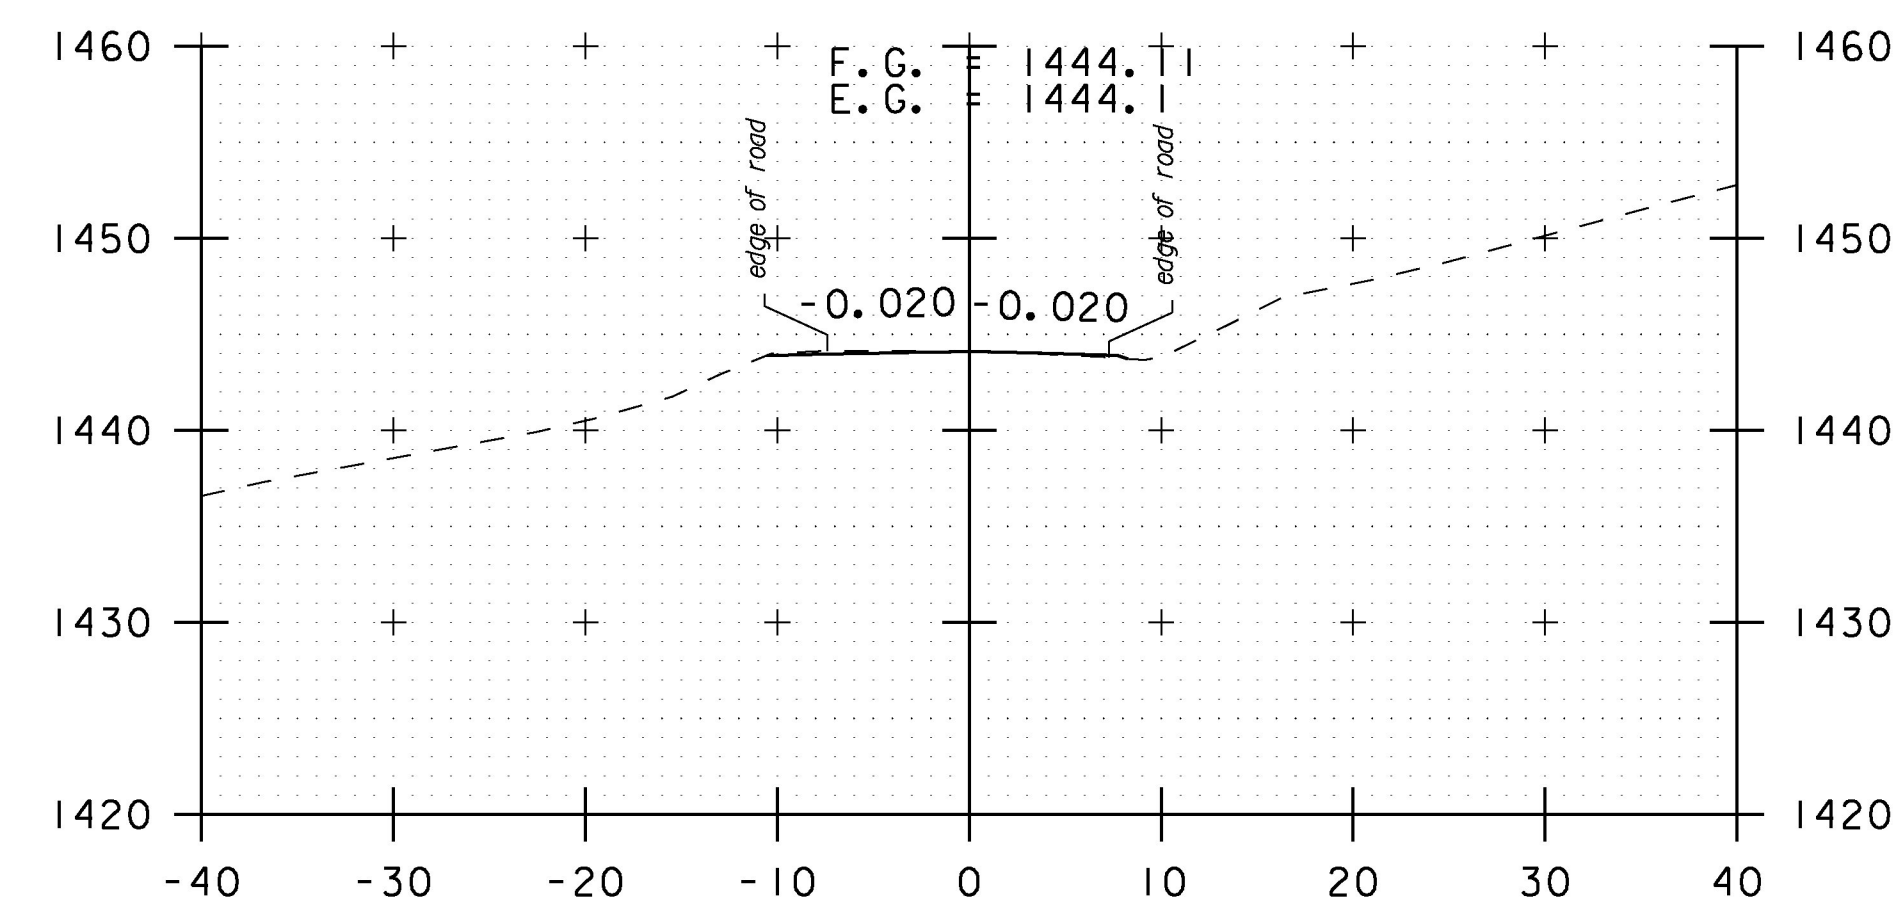

11+12.5  
END EXCAVATION

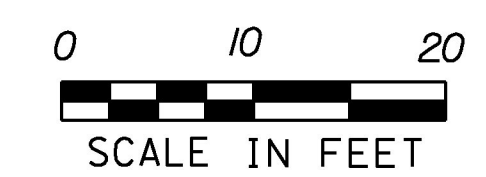

STA. 10+00 TO STA. 11+50

PROJECT NAME: BROOKFIELD  
PROJECT NUMBER: STP 2960(I)

FILE NAME: z15v023xsl.dgn  
PROJECT LEADER: C. LATHROP  
DESIGNED BY: S. SOLLA  
WEST STREET LT CROSS SECTIONS SHEET 1

PLOT DATE: 4/26/2016  
DRAWN BY: S. SOLLA  
CHECKED BY: C. LATHROP  
SHEET 179 OF 202