


**EXPANSION JOINT TYPICAL SECTION
PLAN VIEW
(VERMONT JOINT)**

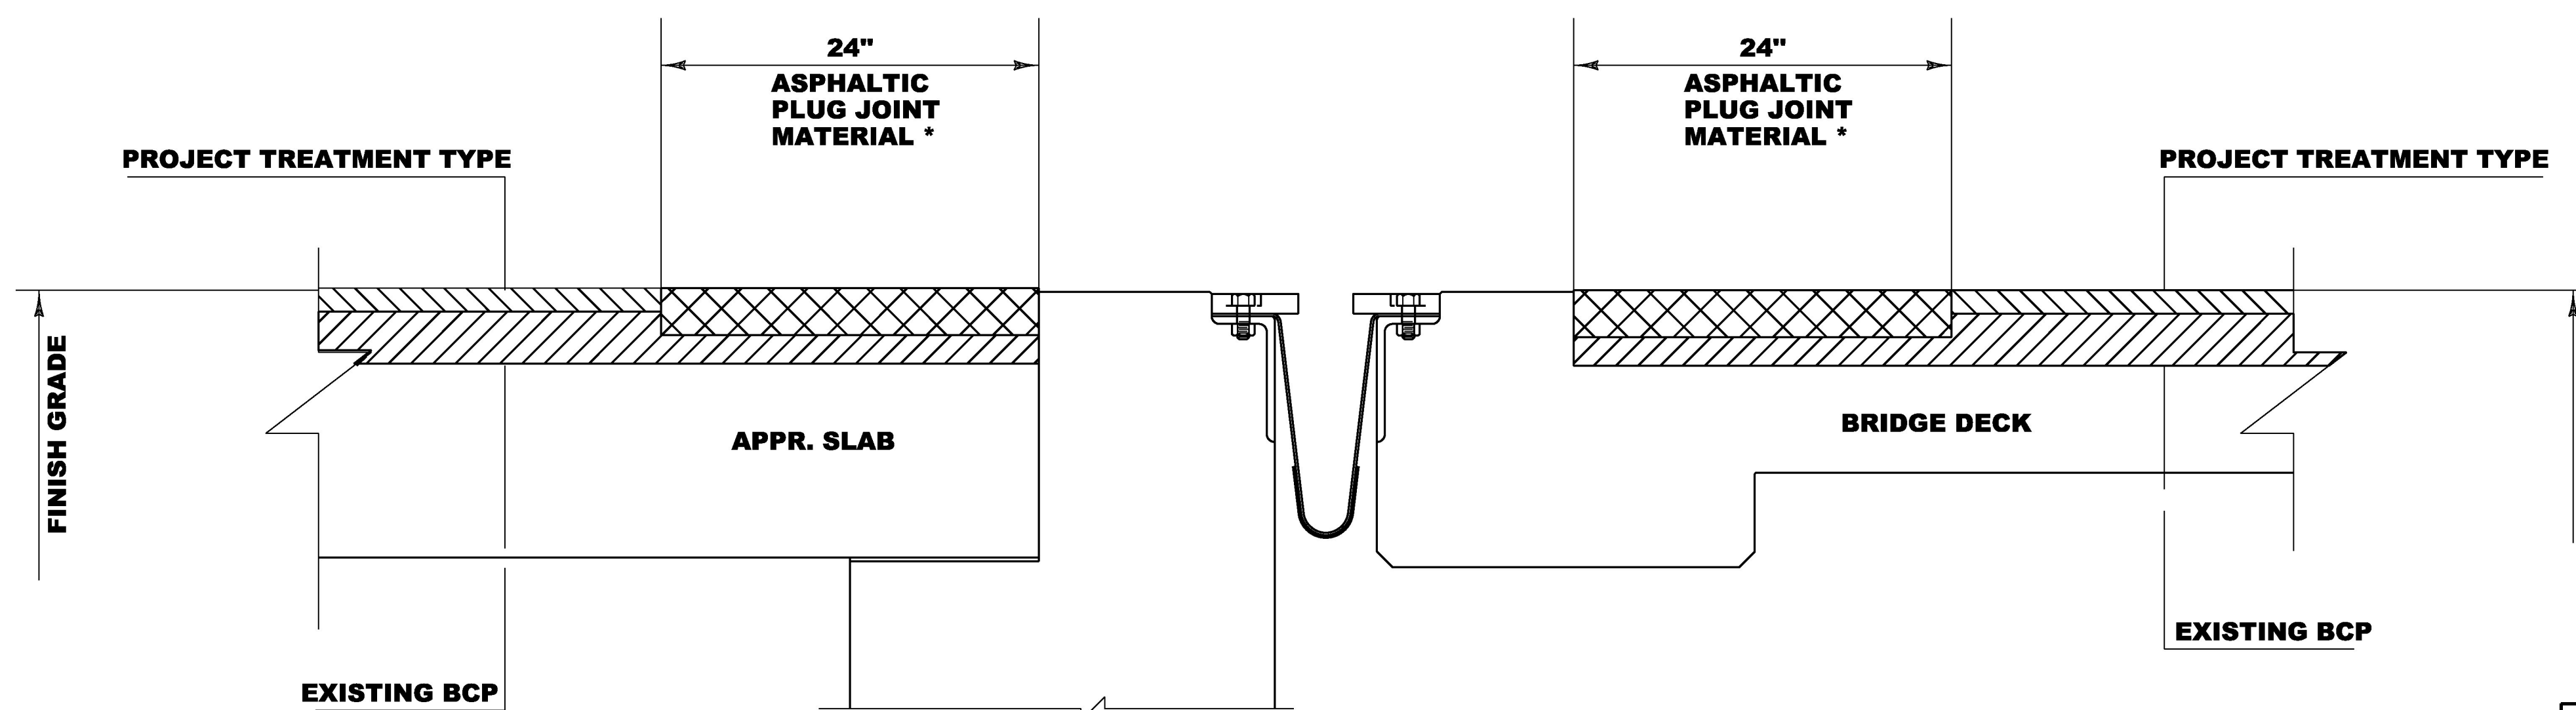

**EXPANSION JOINT TYPICAL SECTION
CROSS SECTION
(VERMONT JOINT)**

*2" MINIMUM UNLESS OTHERWISE DIRECTED BY THE ENGINEER

NOT TO SCALE

PROJECT NAME:	BROOKFIELD	PLOT DATE:	4/26/2016
PROJECT NUMBER:	STP 2960(I)	DRAWN BY:	J.GOODALL
FILE NAME:	z15v023de+.dgn	CHECKED BY:	C.LATHROP
DESIGNED BY:	S.SOLLA	EXPANSION JOINT DETAIL SHEET 1	SHEET 202 OF 202