



**AIRPORT ROAD**


	STATION	NORTHING	EASTING
Element: Linear			
POB	24+99.43	625938.9603	1625034.5912
PC	30+00.00	626340.9110	1624736.2578
Tangent Direction: N 36°34'59.97" W			
Tangent Length: 500.57			

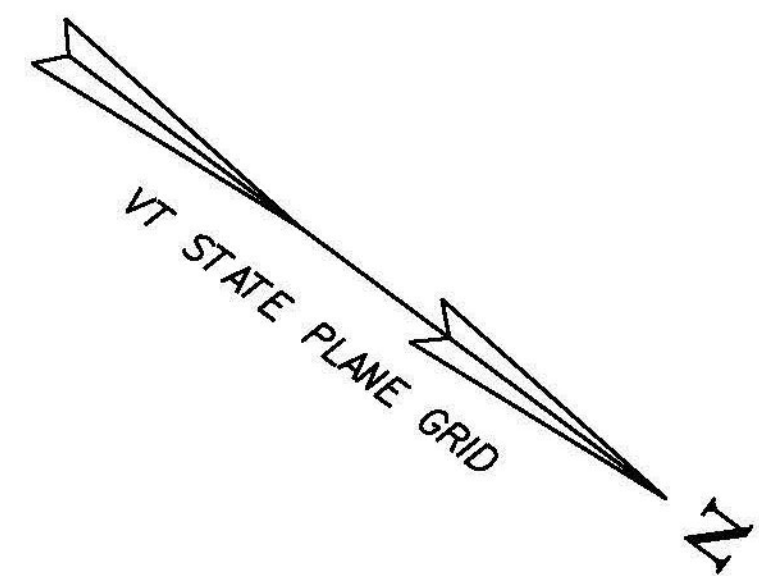

**LIMITS OF CONSTRUCTION  
STA. 24+99.43**

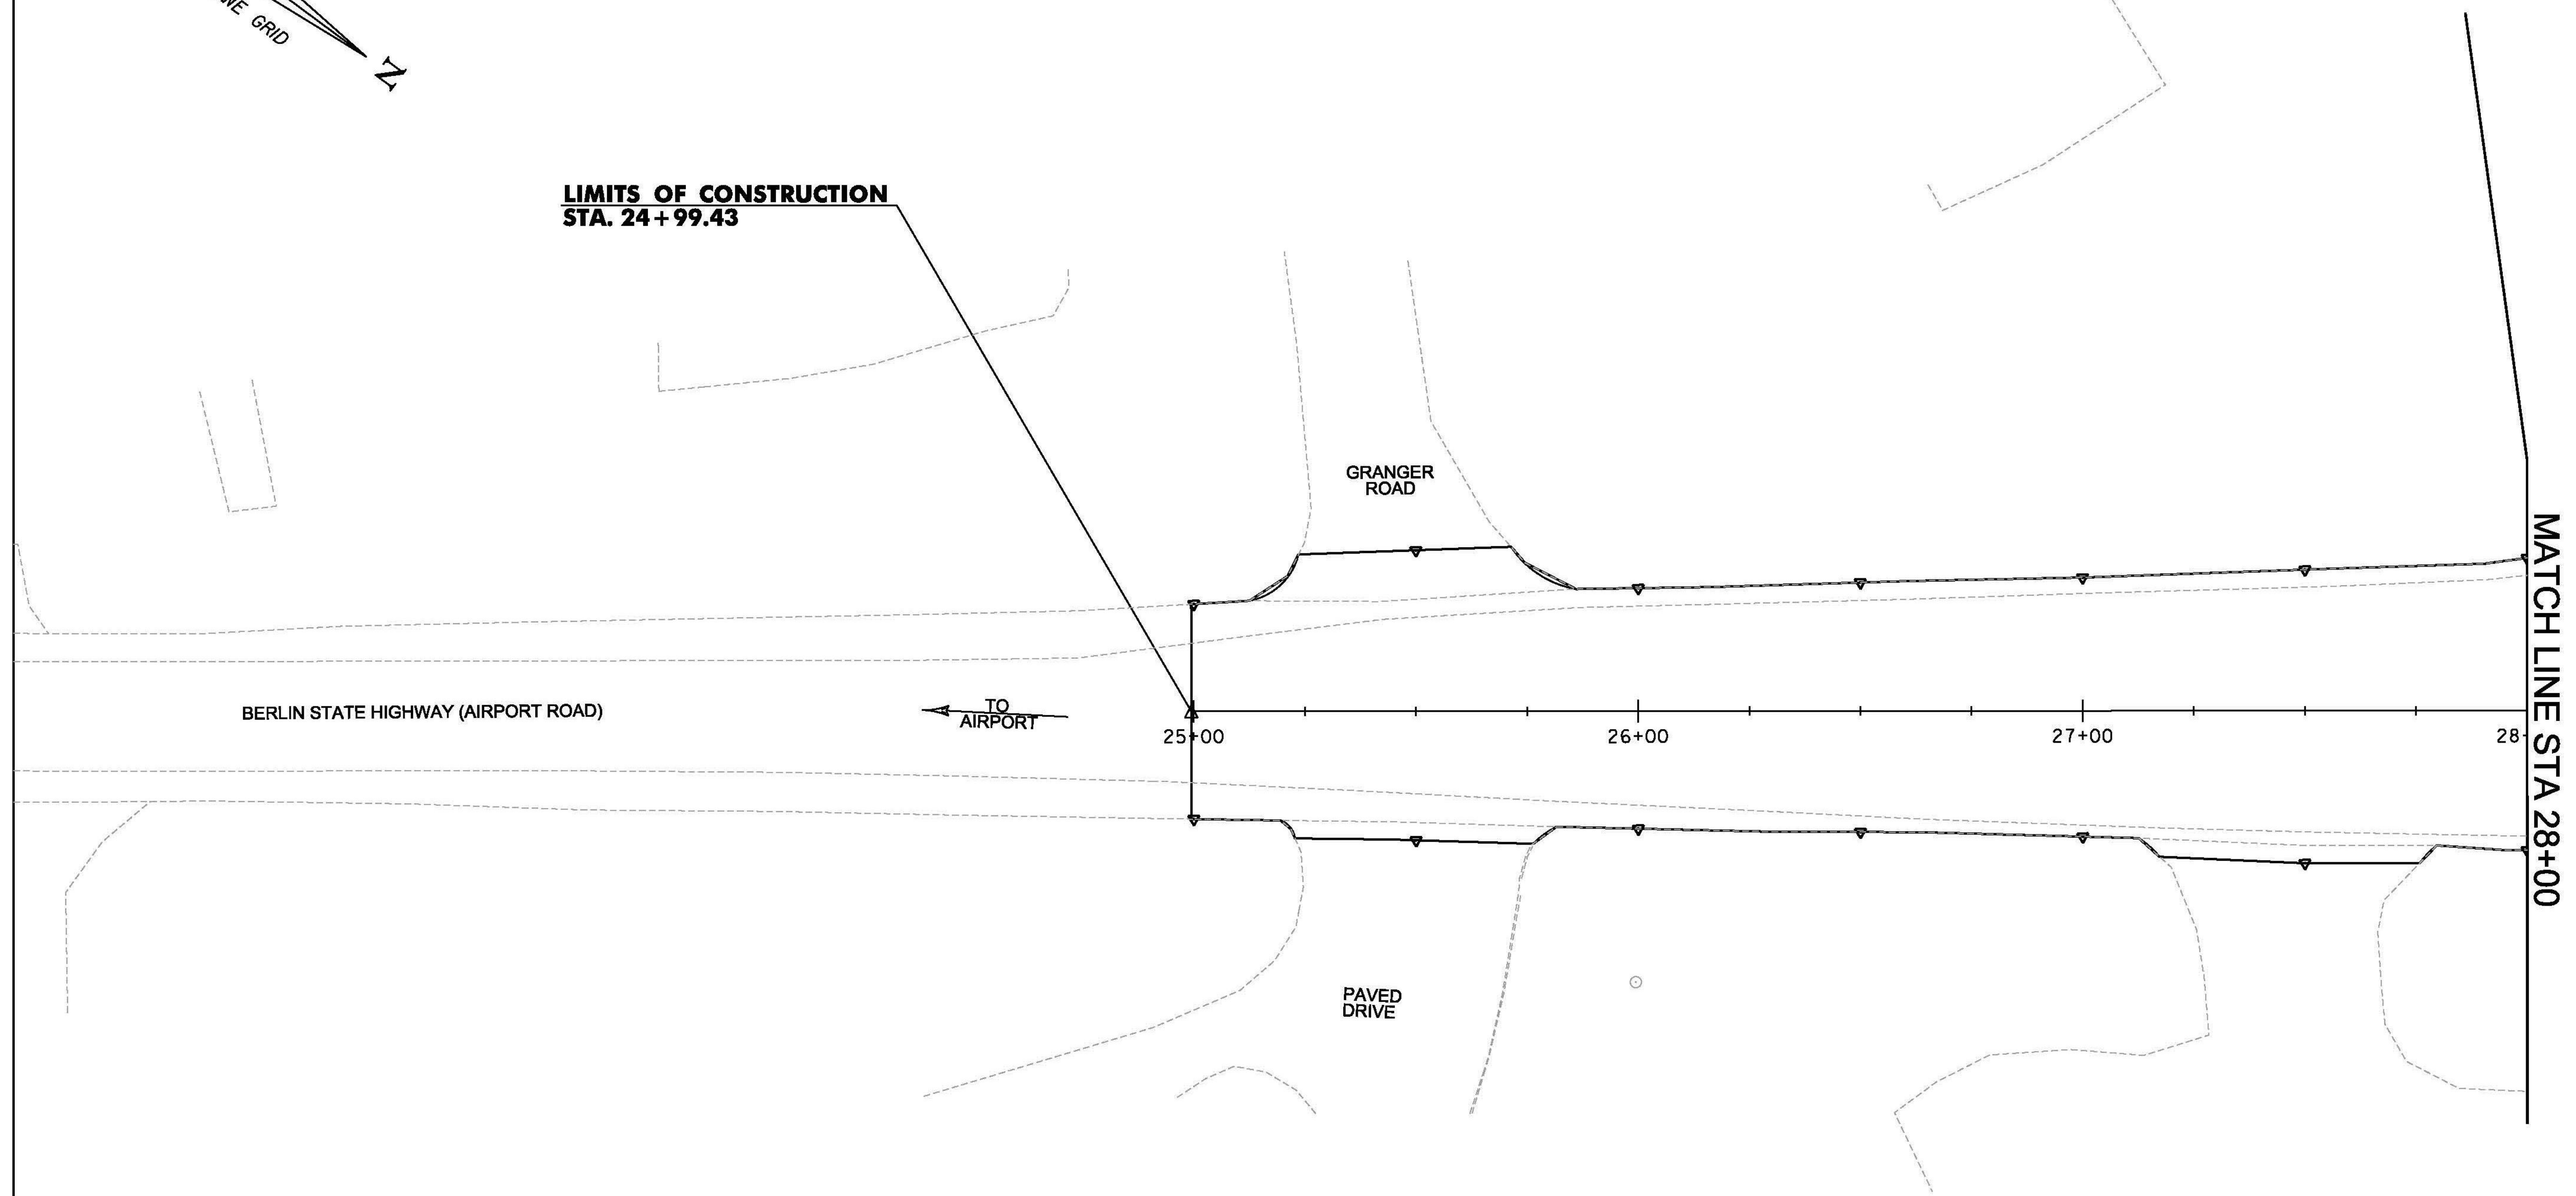

**DATUM**  
 VERTICAL: NAVD88  
 HORIZONTAL: NAD83(2007)

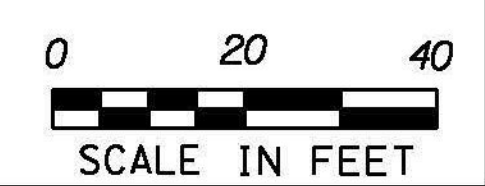

PROJECT NAME: BERLIN	PLOT DATE: 10/20/2014
PROJECT NUMBER: STPG SGNL(40)	DRAWN BY: T. SISSON
FILE NAME: +11b358bdr.dgn	CHECKED BY: M. LACROIX
PROJECT LEADER: P. COBURN	SHEET 6 OF 123
DESIGNED BY: T. SISSON	
ALIGNMENT SHEET 3	