


FISHER ROAD

Element: Linear				
POB	30+00.00	626340.9110	1624736.2578	
PC	34+99.40	626708.1836	1624397.8618	
Tangent Direction:	N 42° 39' 24.15" W			
Tangent Length:	499.40			



DATUM
 VERTICAL NAVD88
 HORIZONTAL NAD83(2007)

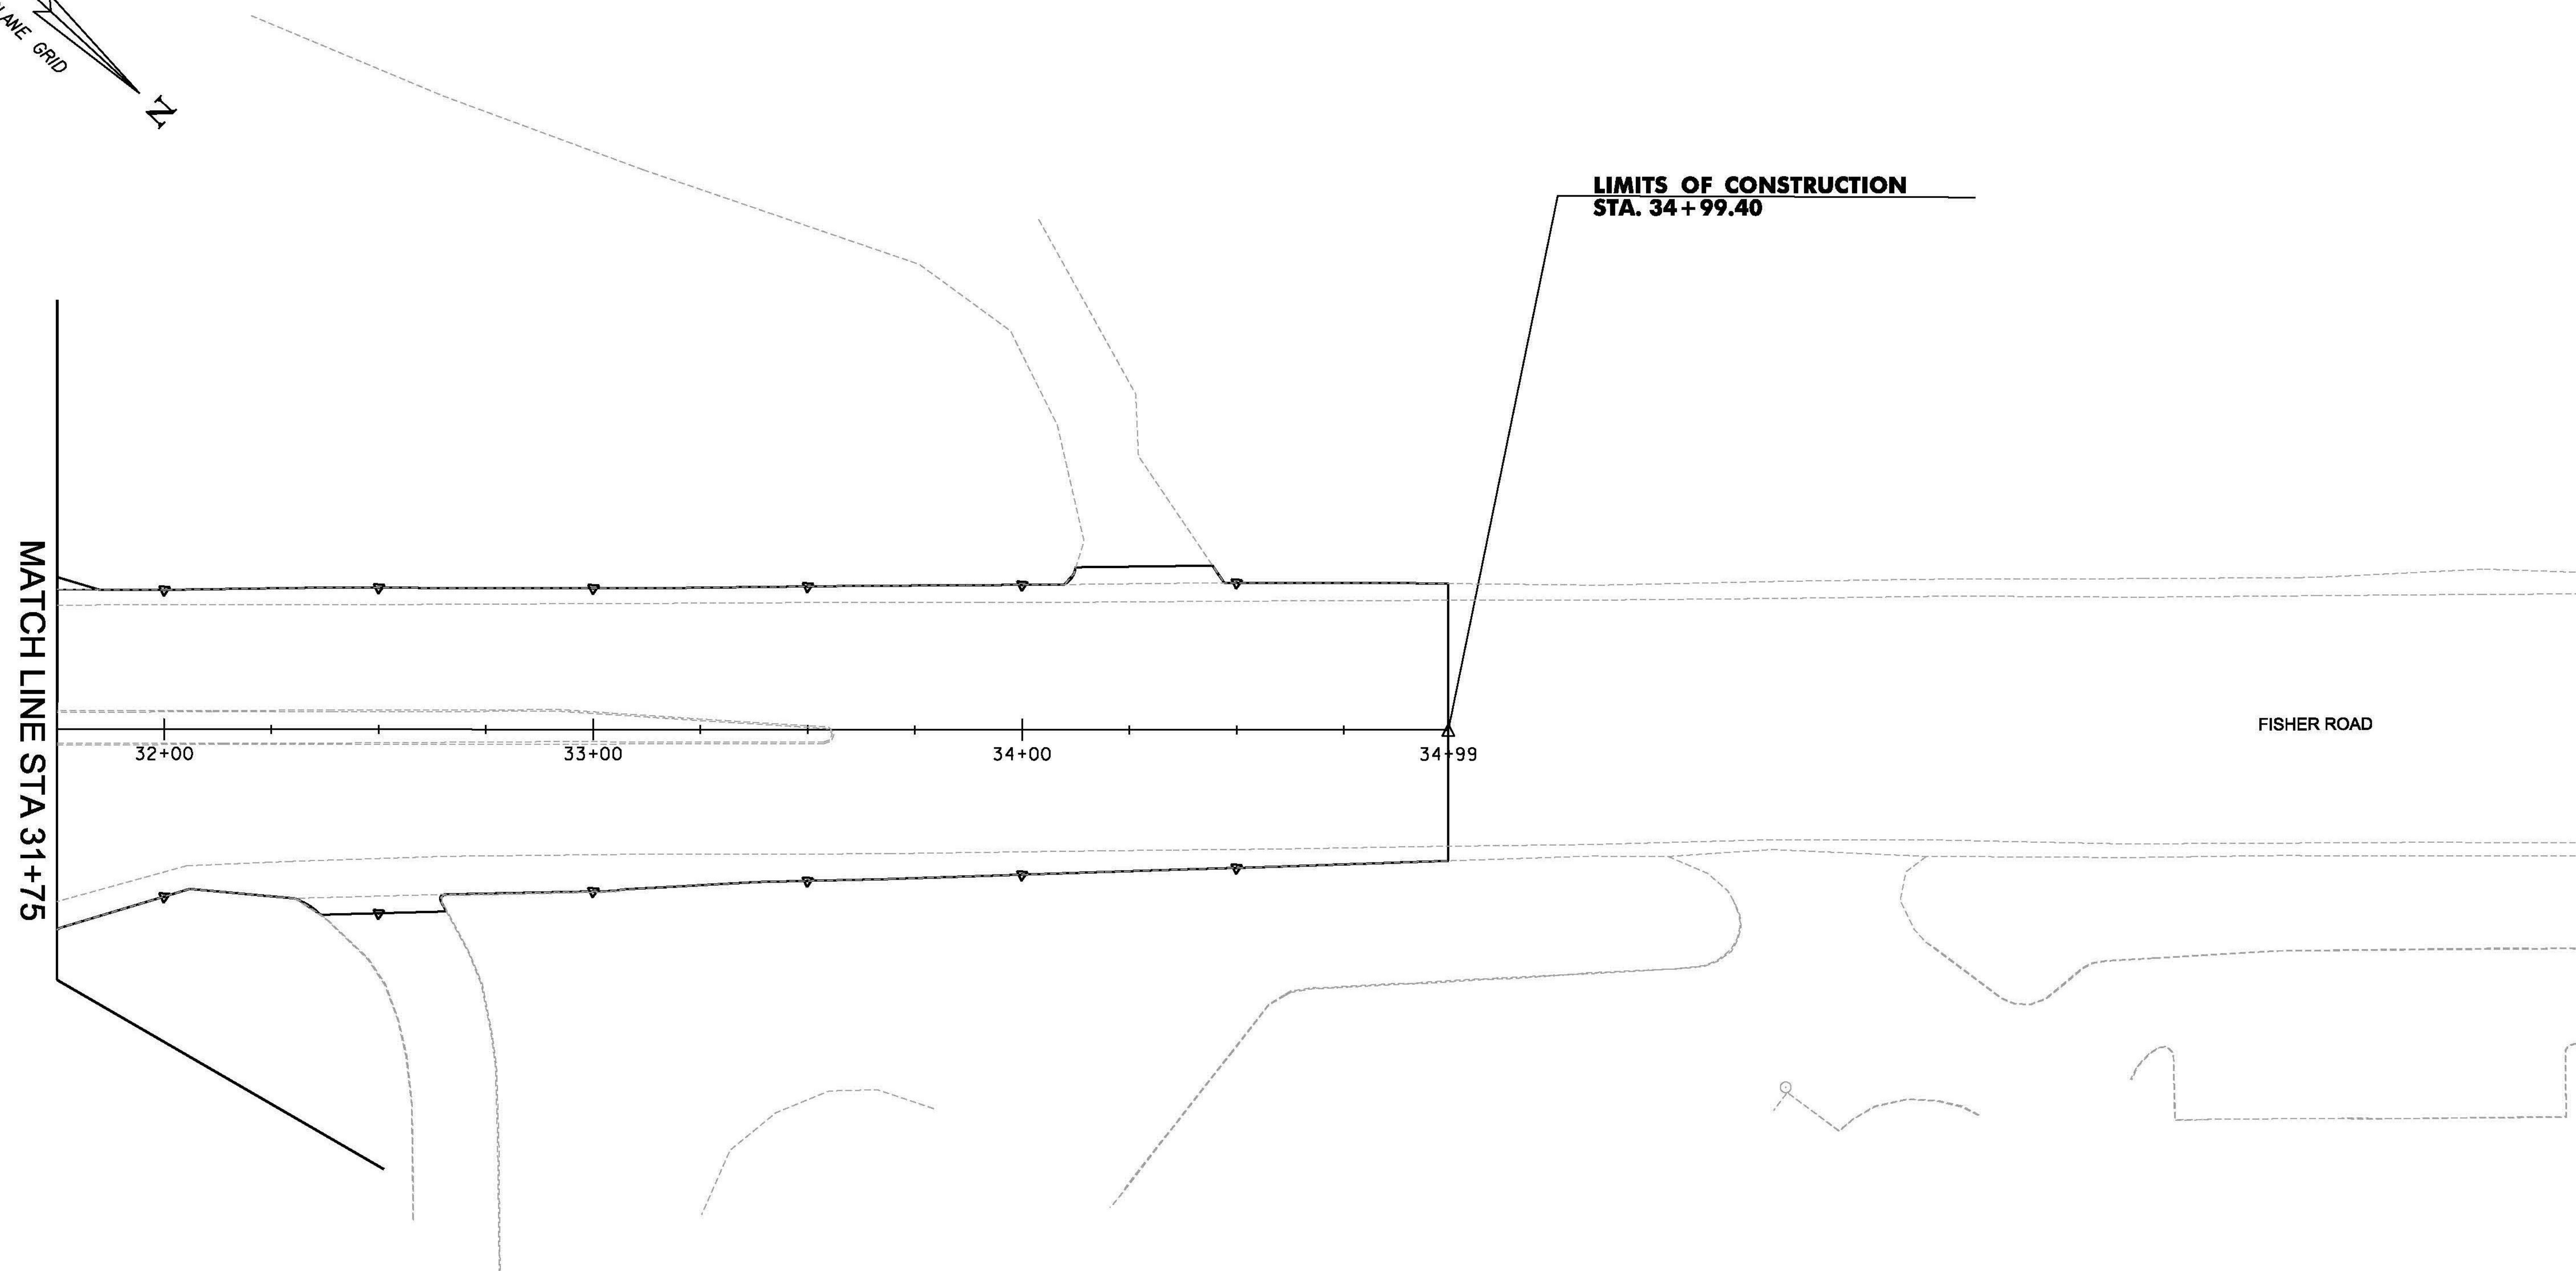

PROJECT NAME: BERLIN	PLOT DATE: 10/20/2014
PROJECT NUMBER: STPG SGNL(40)	DRAWN BY: T. SISSON
FILE NAME: +11b358bdr.dgn	CHECKED BY: M. LACROIX
PROJECT LEADER: P. COBURN	SHEET 7 OF 123
DESIGNED BY: T. SISSON	
ALIGNMENT SHEET 4	