


STEEL BEAM GUARDRAIL, GALVANIZED
~~STA. 68+51, LT. - STA. 70+50, LT. (190')~~ STA 68+59.5 LT ~ STA 70+50 LT
~~STA. 68+49, RT. - STA. 68+98, RT. (50')~~
 STA 69+74.5 RT

MANUFACTURED TERMINAL SECTION, FLARED
~~STA. 68+12, LT. - STA. 68+51, LT.~~ STA 68+22 LT ~ STA 68+59.5 LT
~~STA. 68+12, RT. - STA. 68+49, RT.~~ STA 69+74.5 RT ~ STA 70+12 RT

REMOVAL AND DISPOSAL OF GUARDRAIL
 STA. 69+73, LT. - STA. 69+84, LT. (11')
 STA. 68+65, RT. - STA. 68+98, RT. (33')

**BEGIN PROJECT
 BERLIN STPG SGNL (40)
 STA. 65+92.66
 COLD PLANE
 & OVERLAY**


VT ROUTE 62
 TO BERLIN CORNERS

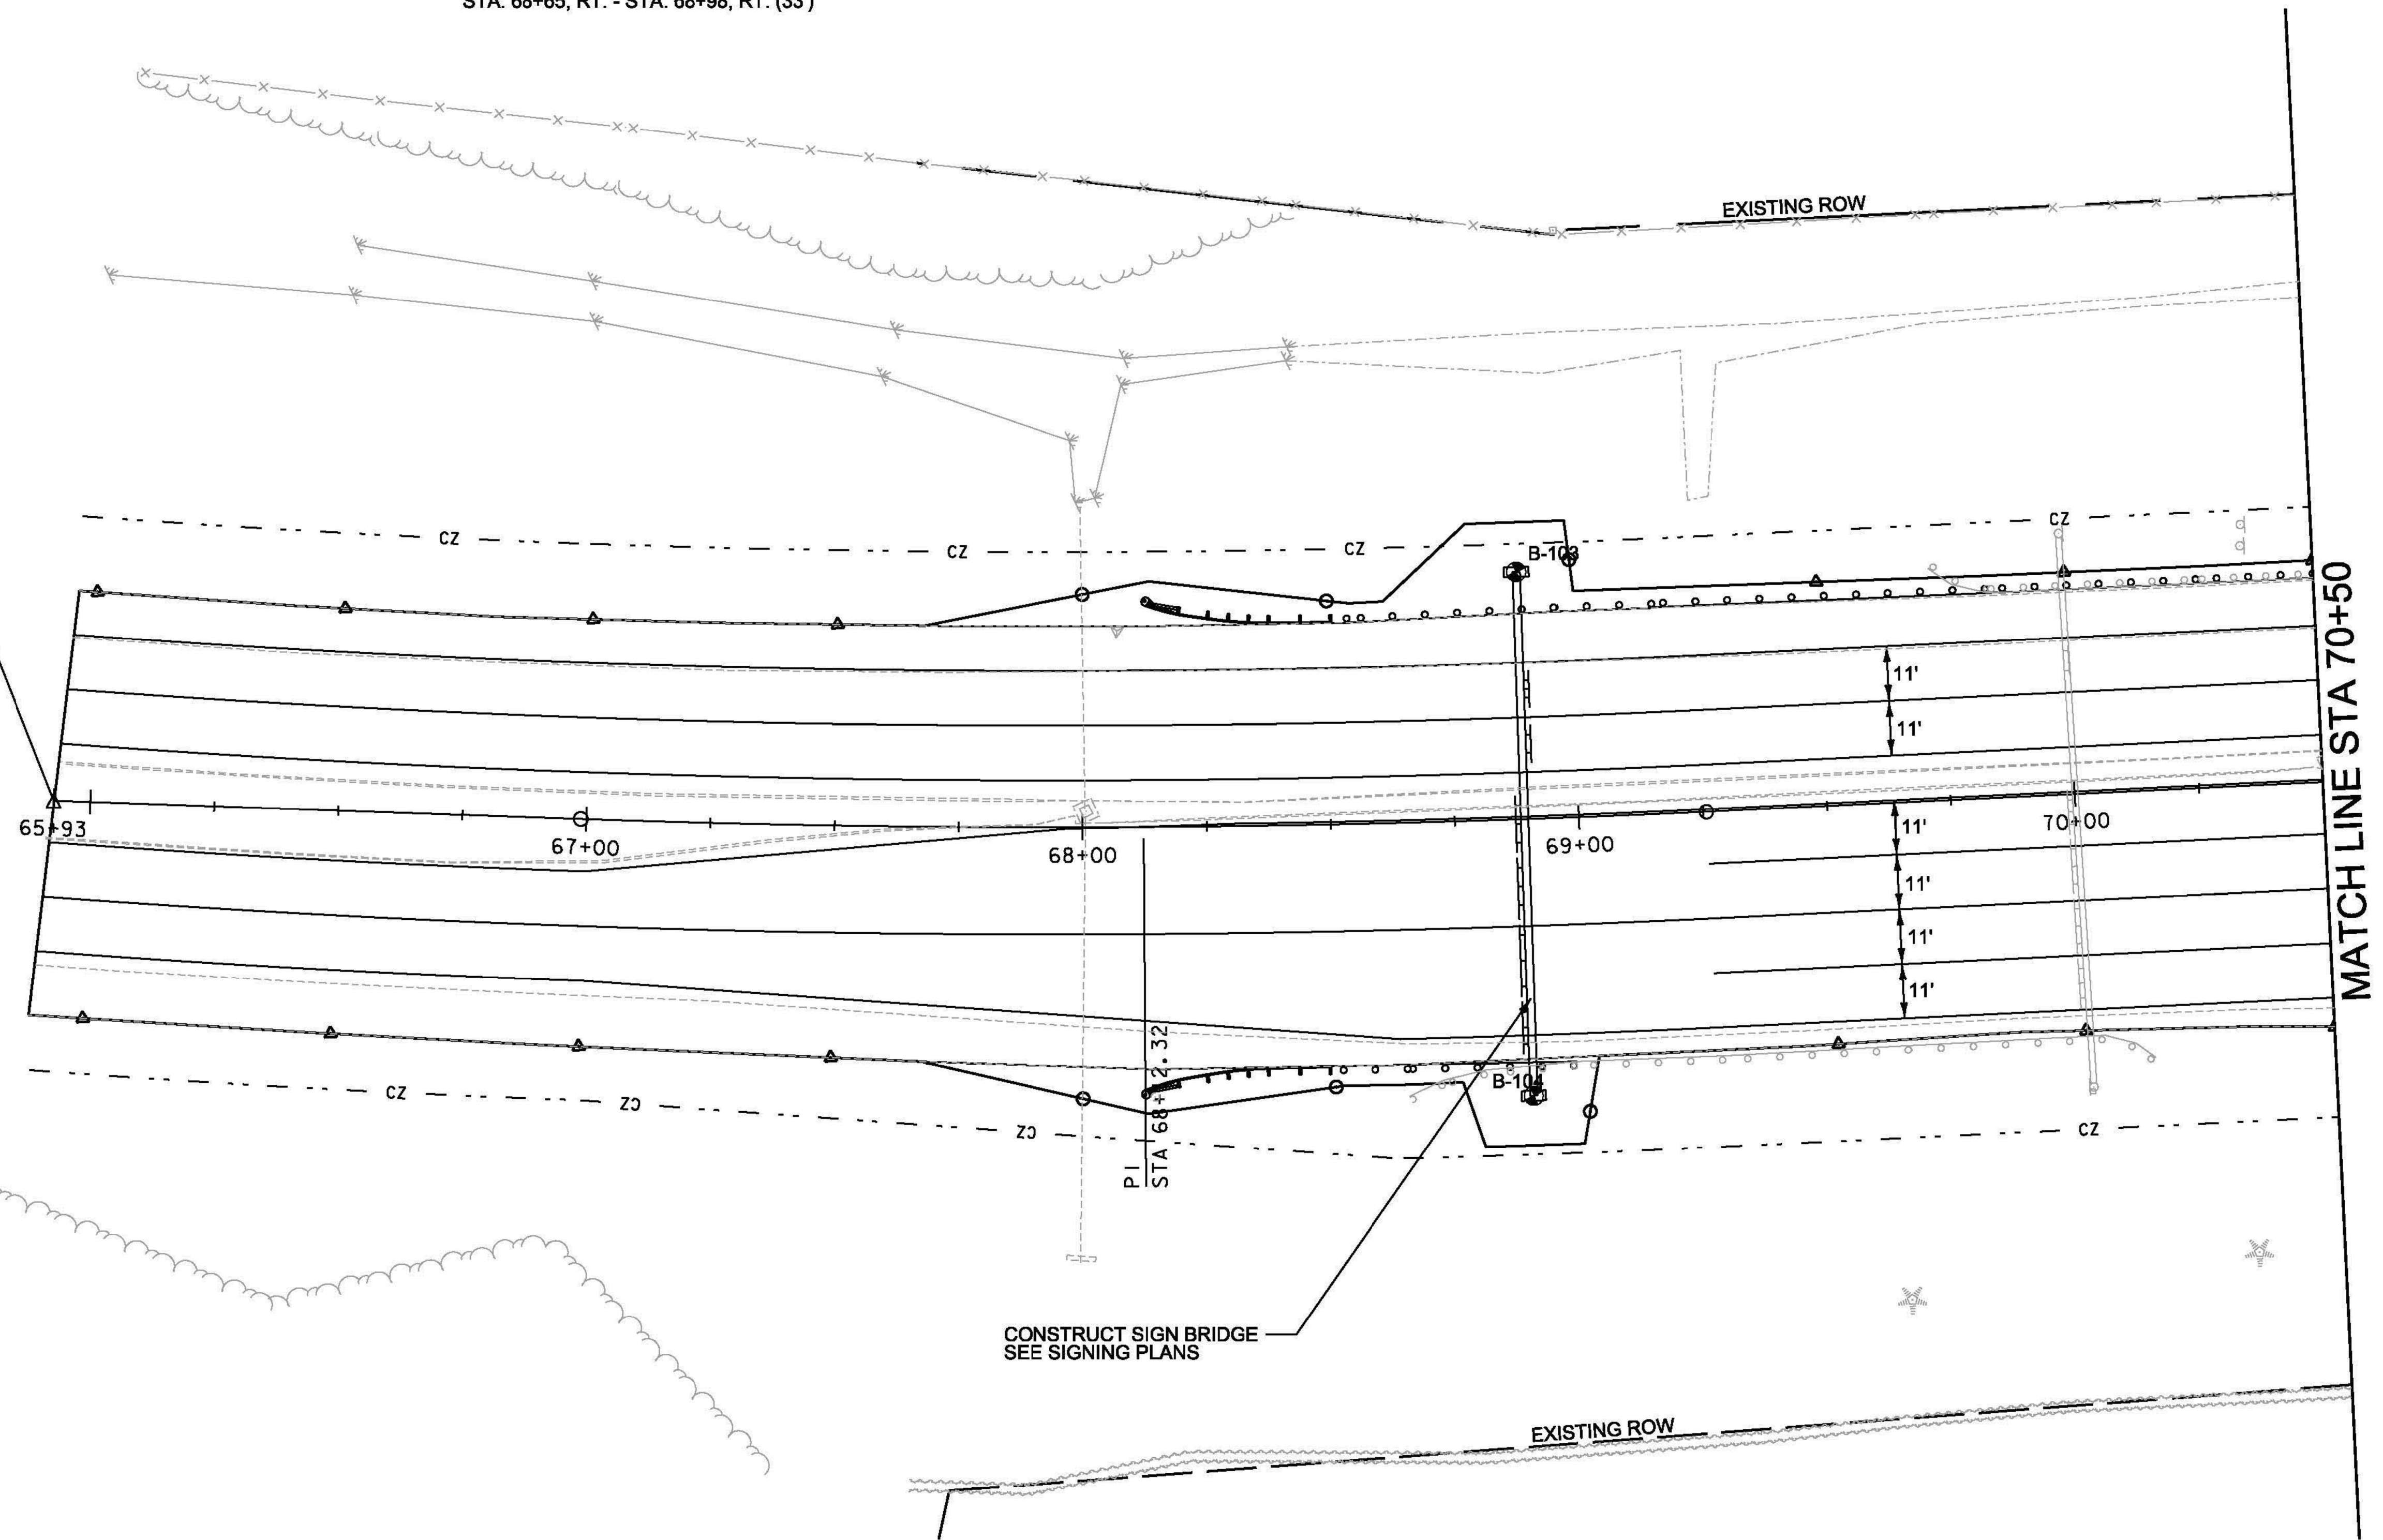

CONSTRUCT SIGN BRIDGE
 SEE SIGNING PLANS

EXISTING ROW

EXISTING ROW

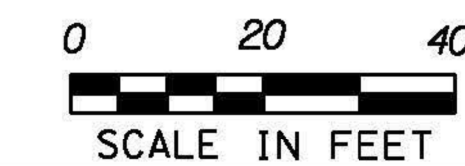

PROJECT NAME: BERLIN
 PROJECT NUMBER: STPG SGNL(40)

FILE NAME: +11b358bdr.dgn
 PROJECT LEADER: P. COBURN
 DESIGNED BY: T. SISSON
 PLAN SHEET 1

PLOT DATE: 10/28/2014
 DRAWN BY: T. SISSON
 CHECKED BY: M. LACROIX
 SHEET 22 OF 123