



STEEL BEAM GUARDRAIL, GALVANIZED  
 STA. 28+85, RT. - STA. 74+53, RT. (225') STA 76+00 RT  
 STA. 70+50, LT. - STA. 31+00, LT. (285')

MANUFACTURED TERMINAL SECTION, FLARED  
 STA. 28+47, RT. - STA. 28+85, RT.  
 STA. 31+00, LT. - STA. 31+38, LT.  
 STA 75+75 LT ~ STA 76+12.5 LT

REMOVAL OF EXISTING CURB  
 STA. 28+19, LT. - STA. 29+33, RT.

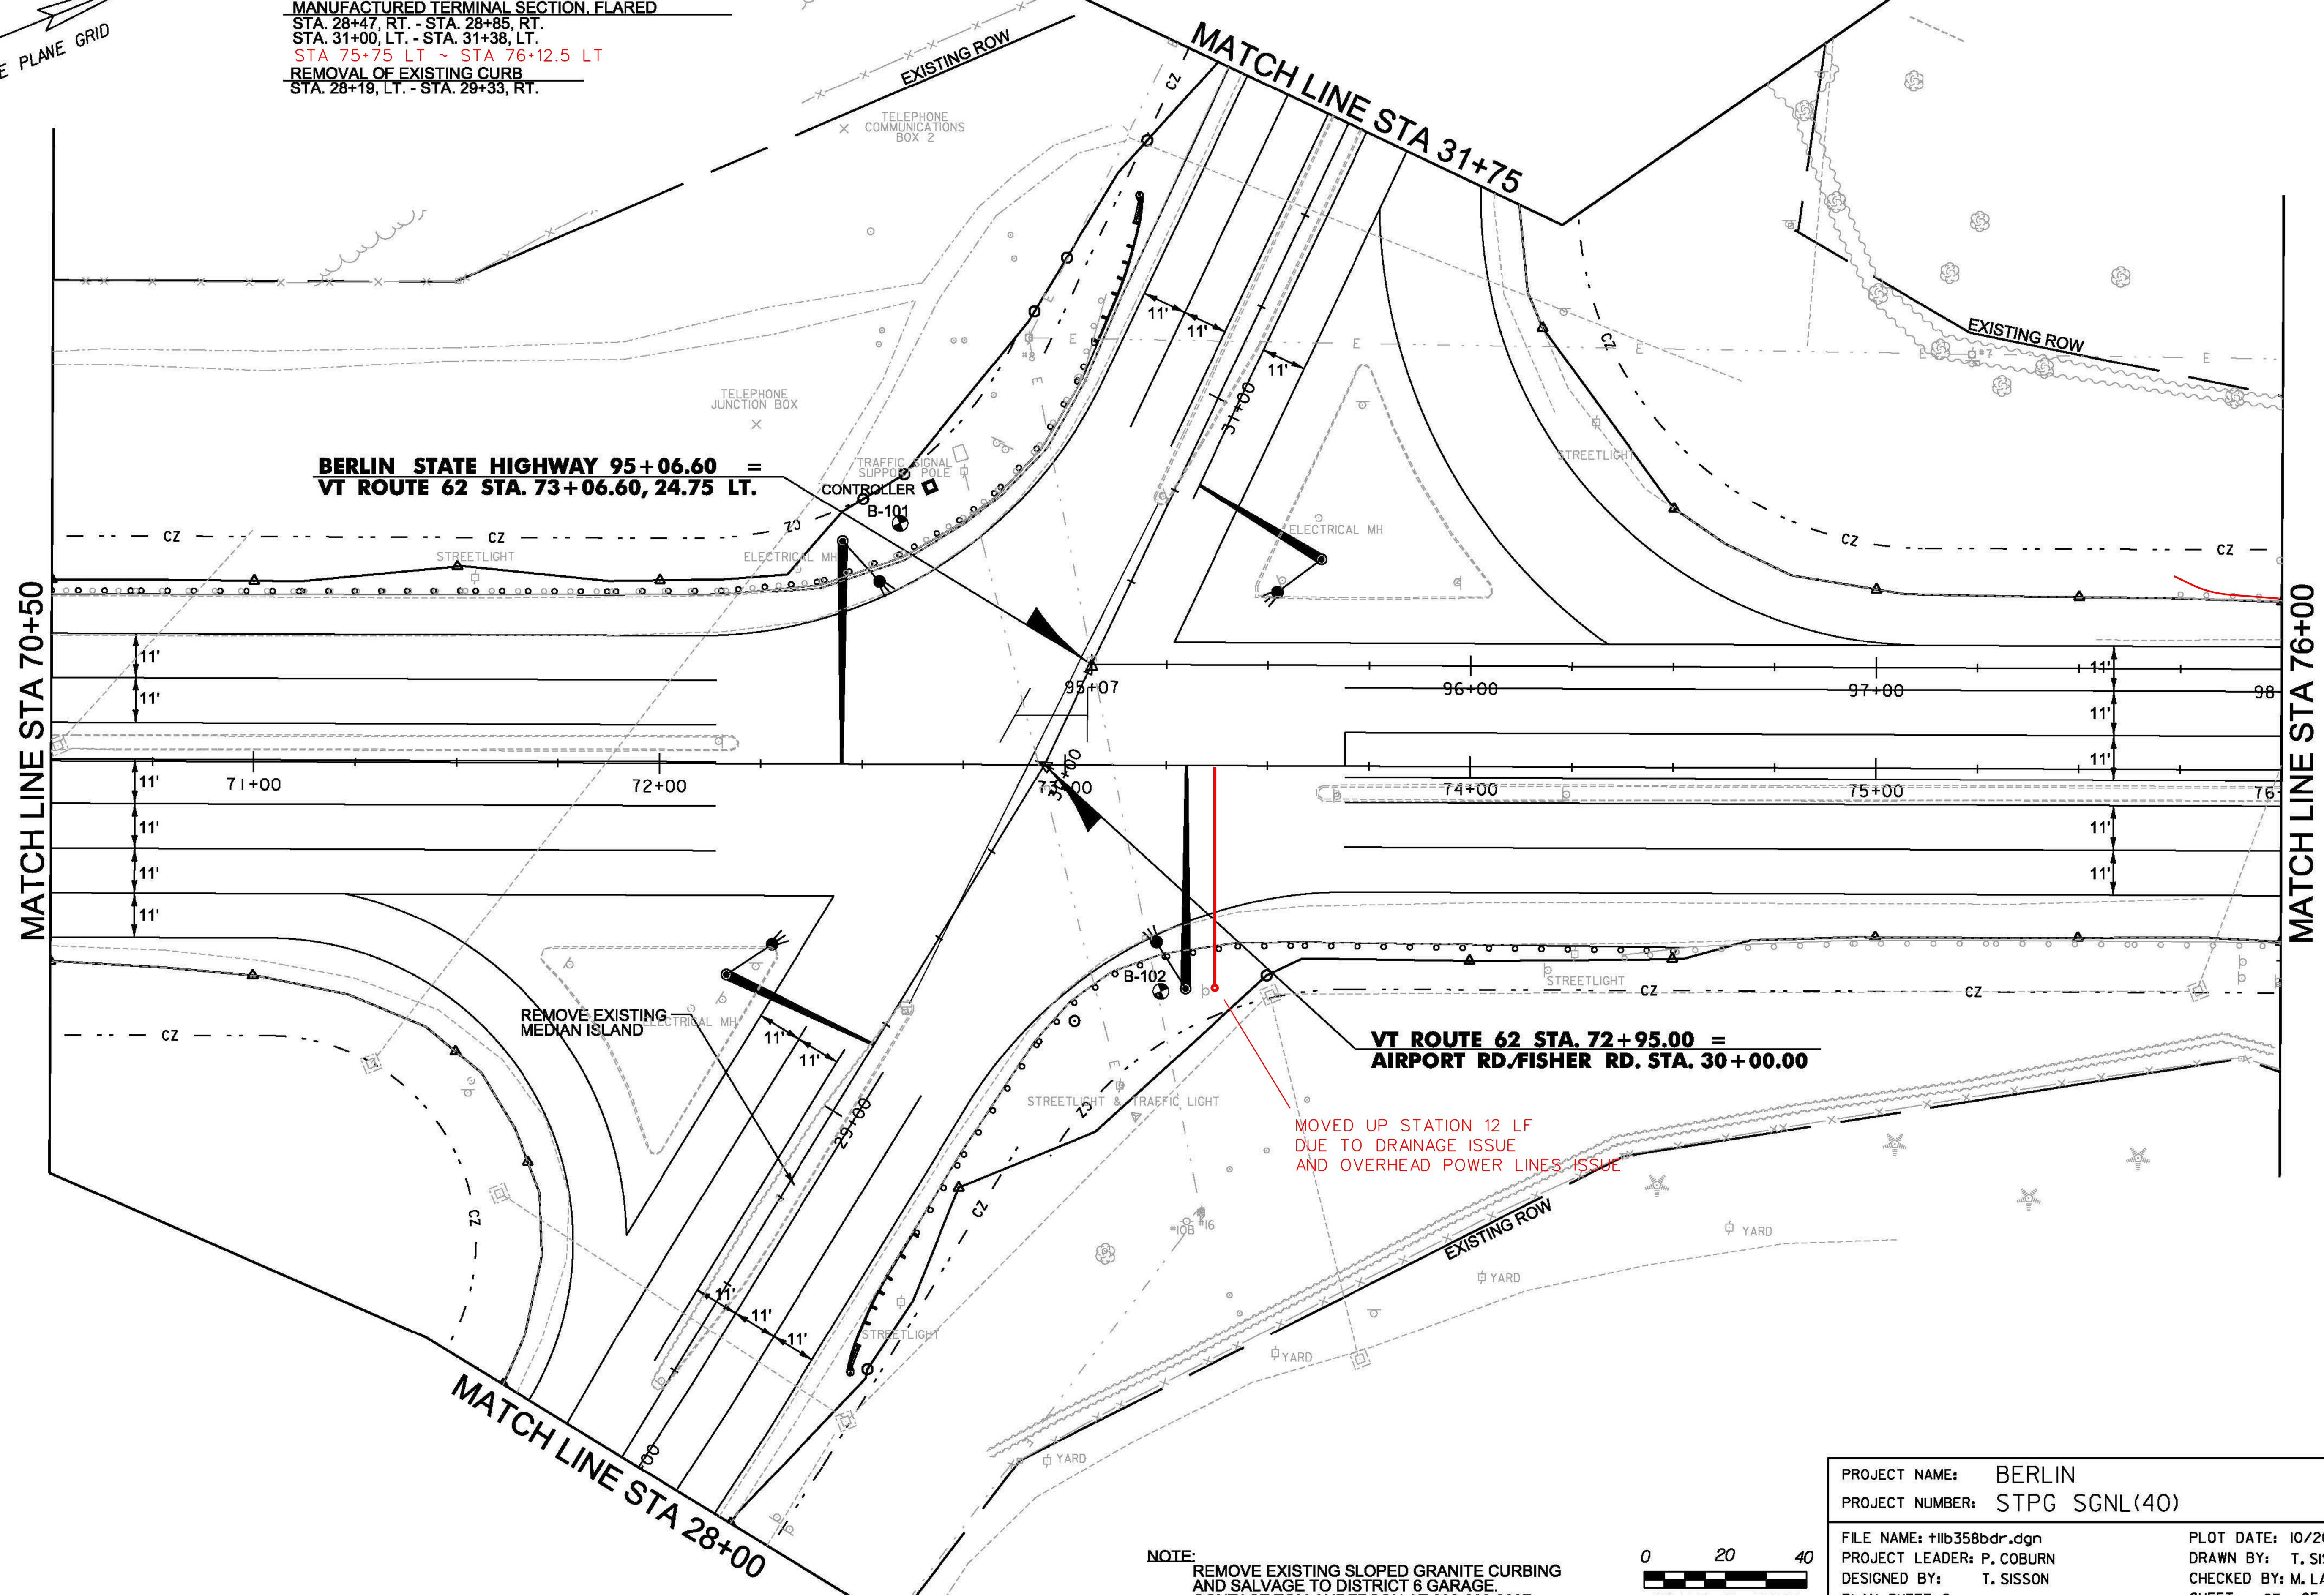

NOTE:  
 REMOVE EXISTING SLOPED GRANITE CURBING  
 AND SALVAGE TO DISTRICT 6 GARAGE.  
 CONTACT TOM ANDERSON AT 802-828-2687

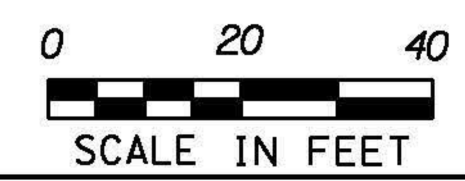

PROJECT NAME: BERLIN	PLOT DATE: 10/20/2014
PROJECT NUMBER: STPG SGNL(40)	DRAWN BY: T. SISSON
FILE NAME: t1b358bdr.dgn	CHECKED BY: M. LACROIX
PROJECT LEADER: P. COBURN	SHEET 23 OF 123
DESIGNED BY: T. SISSON	PLAN SHEET 2