



SPECIAL PROVISION (HAND-PLACED BITUMINOUS CONCRETE MATERIAL, DRIVES)
 STA. 32+50, RT (20')
 STA. 34+28, LT (20')

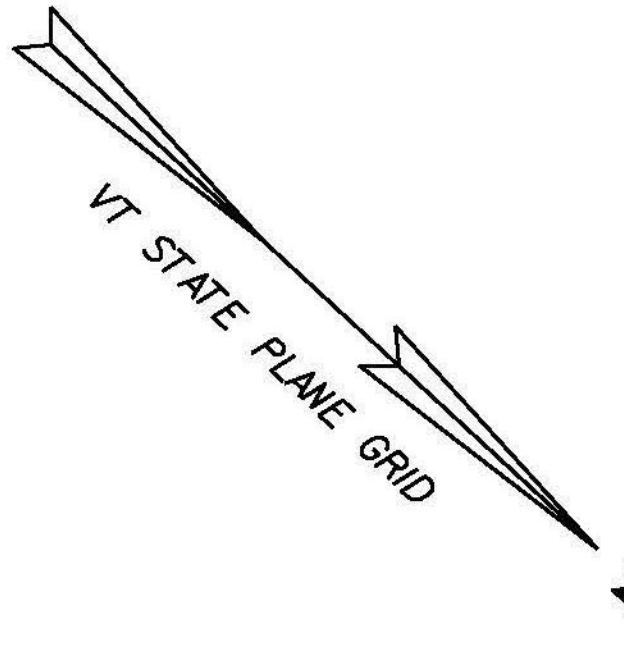


MATCH LINE STA 31+75

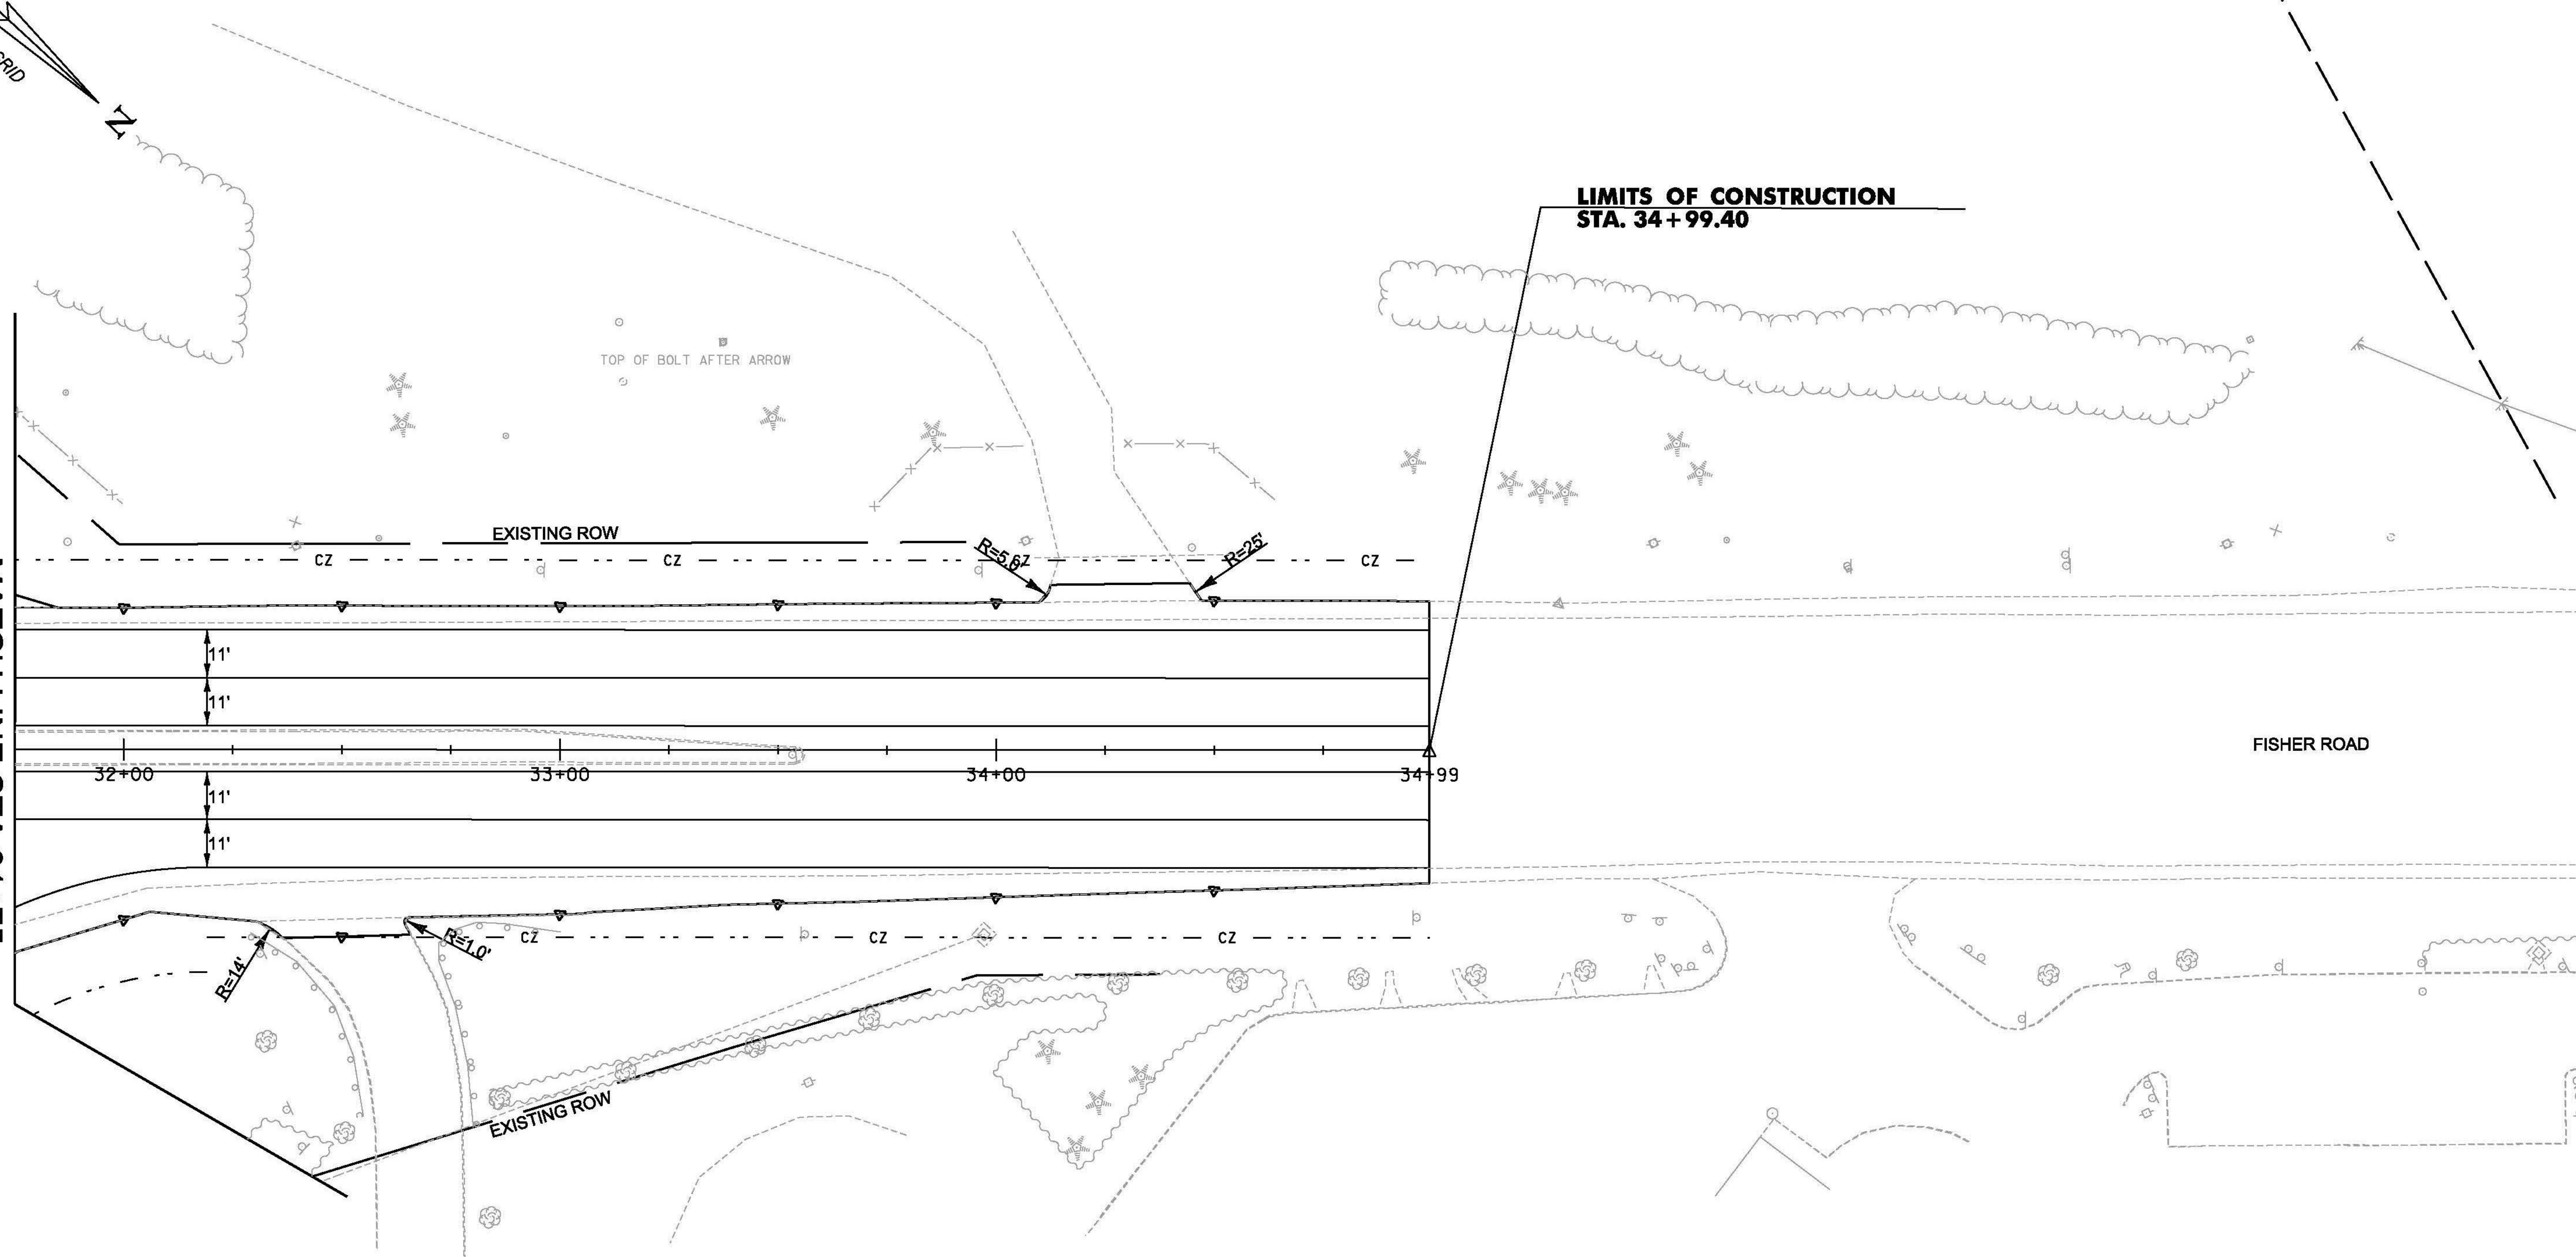

LIMITS OF CONSTRUCTION
STA. 34+99.40

FISHER ROAD

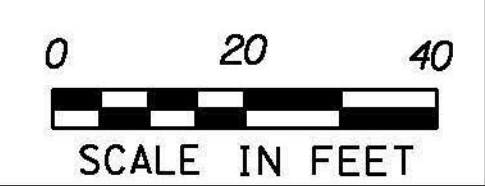

PROJECT NAME:	BERLIN	FILE NAME:	+11b358bdr.dgn	PLOT DATE:	10/20/2014
PROJECT NUMBER:	STPG SGNL(40)	PROJECT LEADER:	P. COBURN	DRAWN BY:	T. SISSON
		DESIGNED BY:	T. SISSON	CHECKED BY:	M. LACROIX
		PLAN SHEET 4		SHEET 25	OF 123