


EXCAVATION OF SURFACES AND PAVEMENTS  
 STA. 85+00, LT. - STA. 90+75, LT.

N

VT STATE PLANE GRID

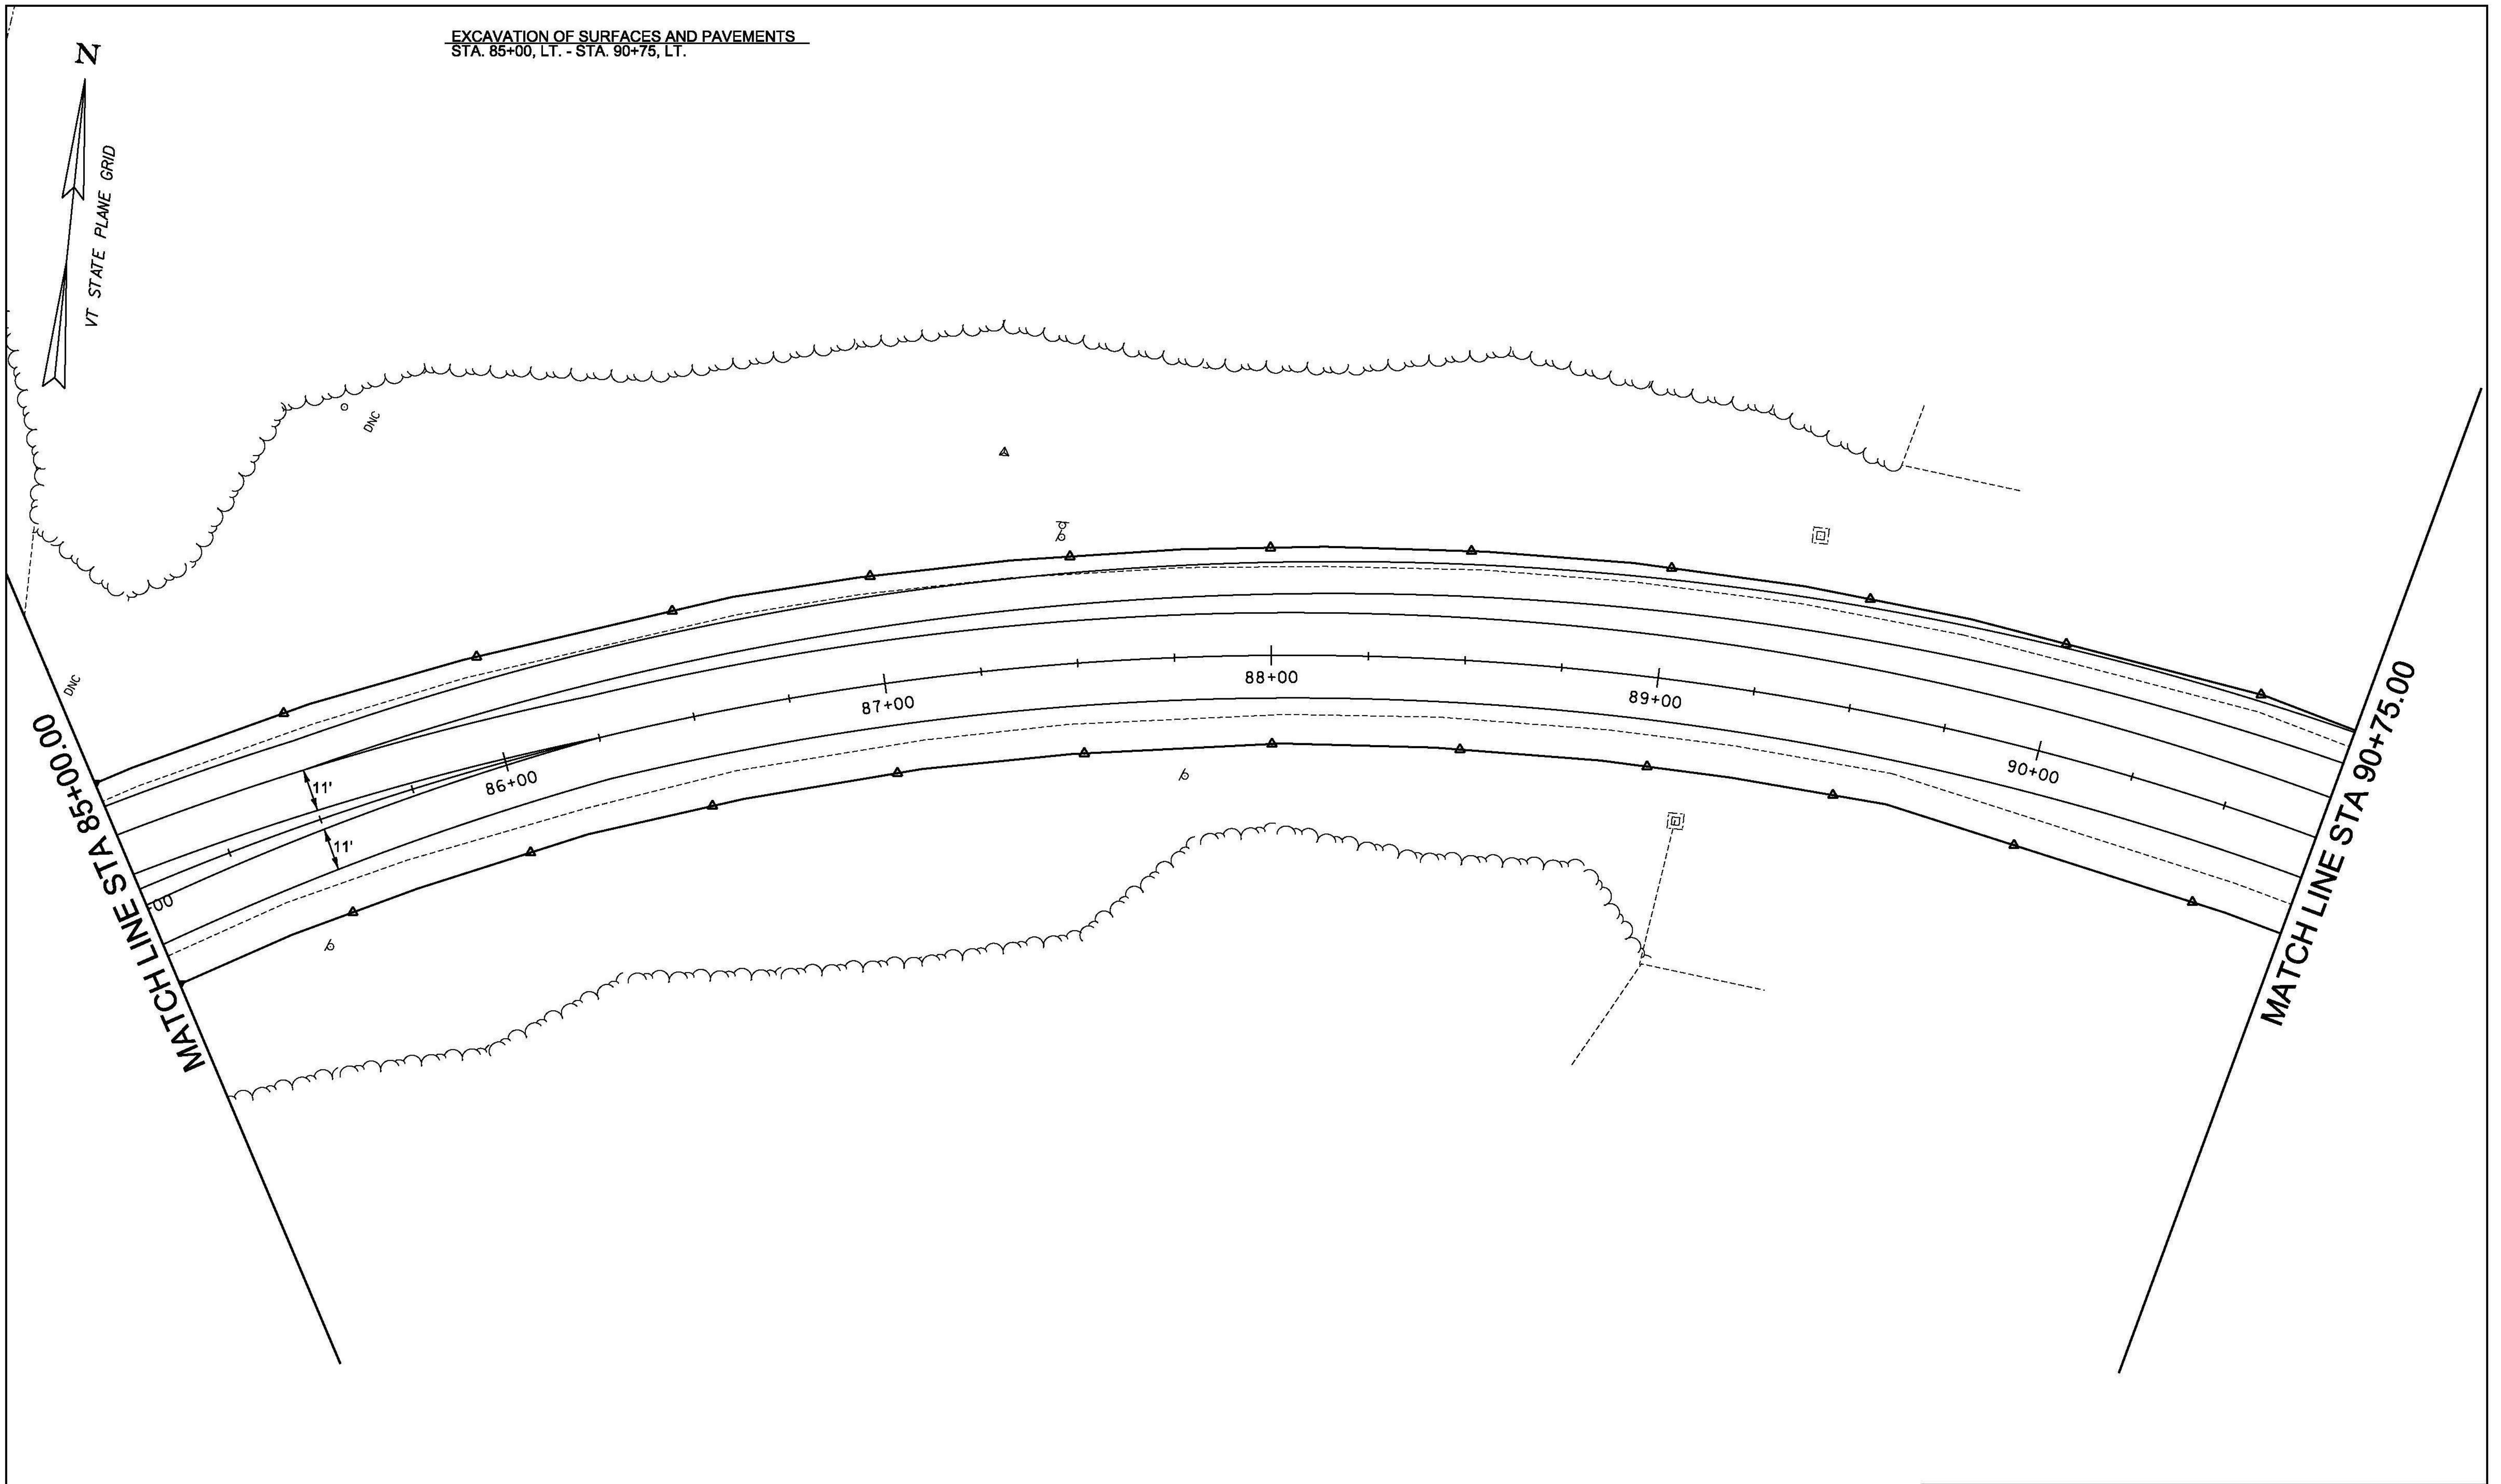

PROJECT NAME: BERLIN	PLOT DATE: 10/20/2014
PROJECT NUMBER: STPG SGNL(40)	DRAWN BY: T. SISSON
FILE NAME: +lib358bdr.dgn	CHECKED BY: M. LACROIX
PROJECT LEADER: P. COBURN	SHEET 28 OF 123
DESIGNED BY: T. SISSON	
PLAN SHEET 7	