



EXCAVATION OF SURFACES AND PAVEMENTS
 STA. 90+75, LT. - STA. 91+50, LT.

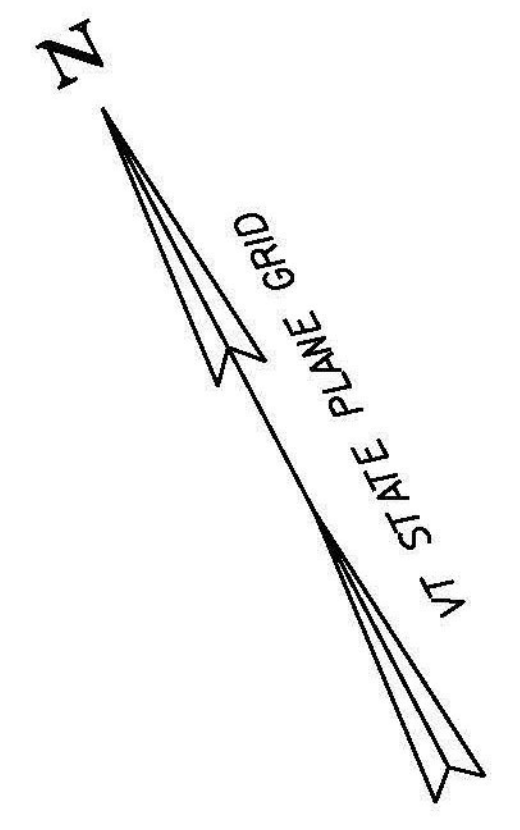

EXISTING ROW

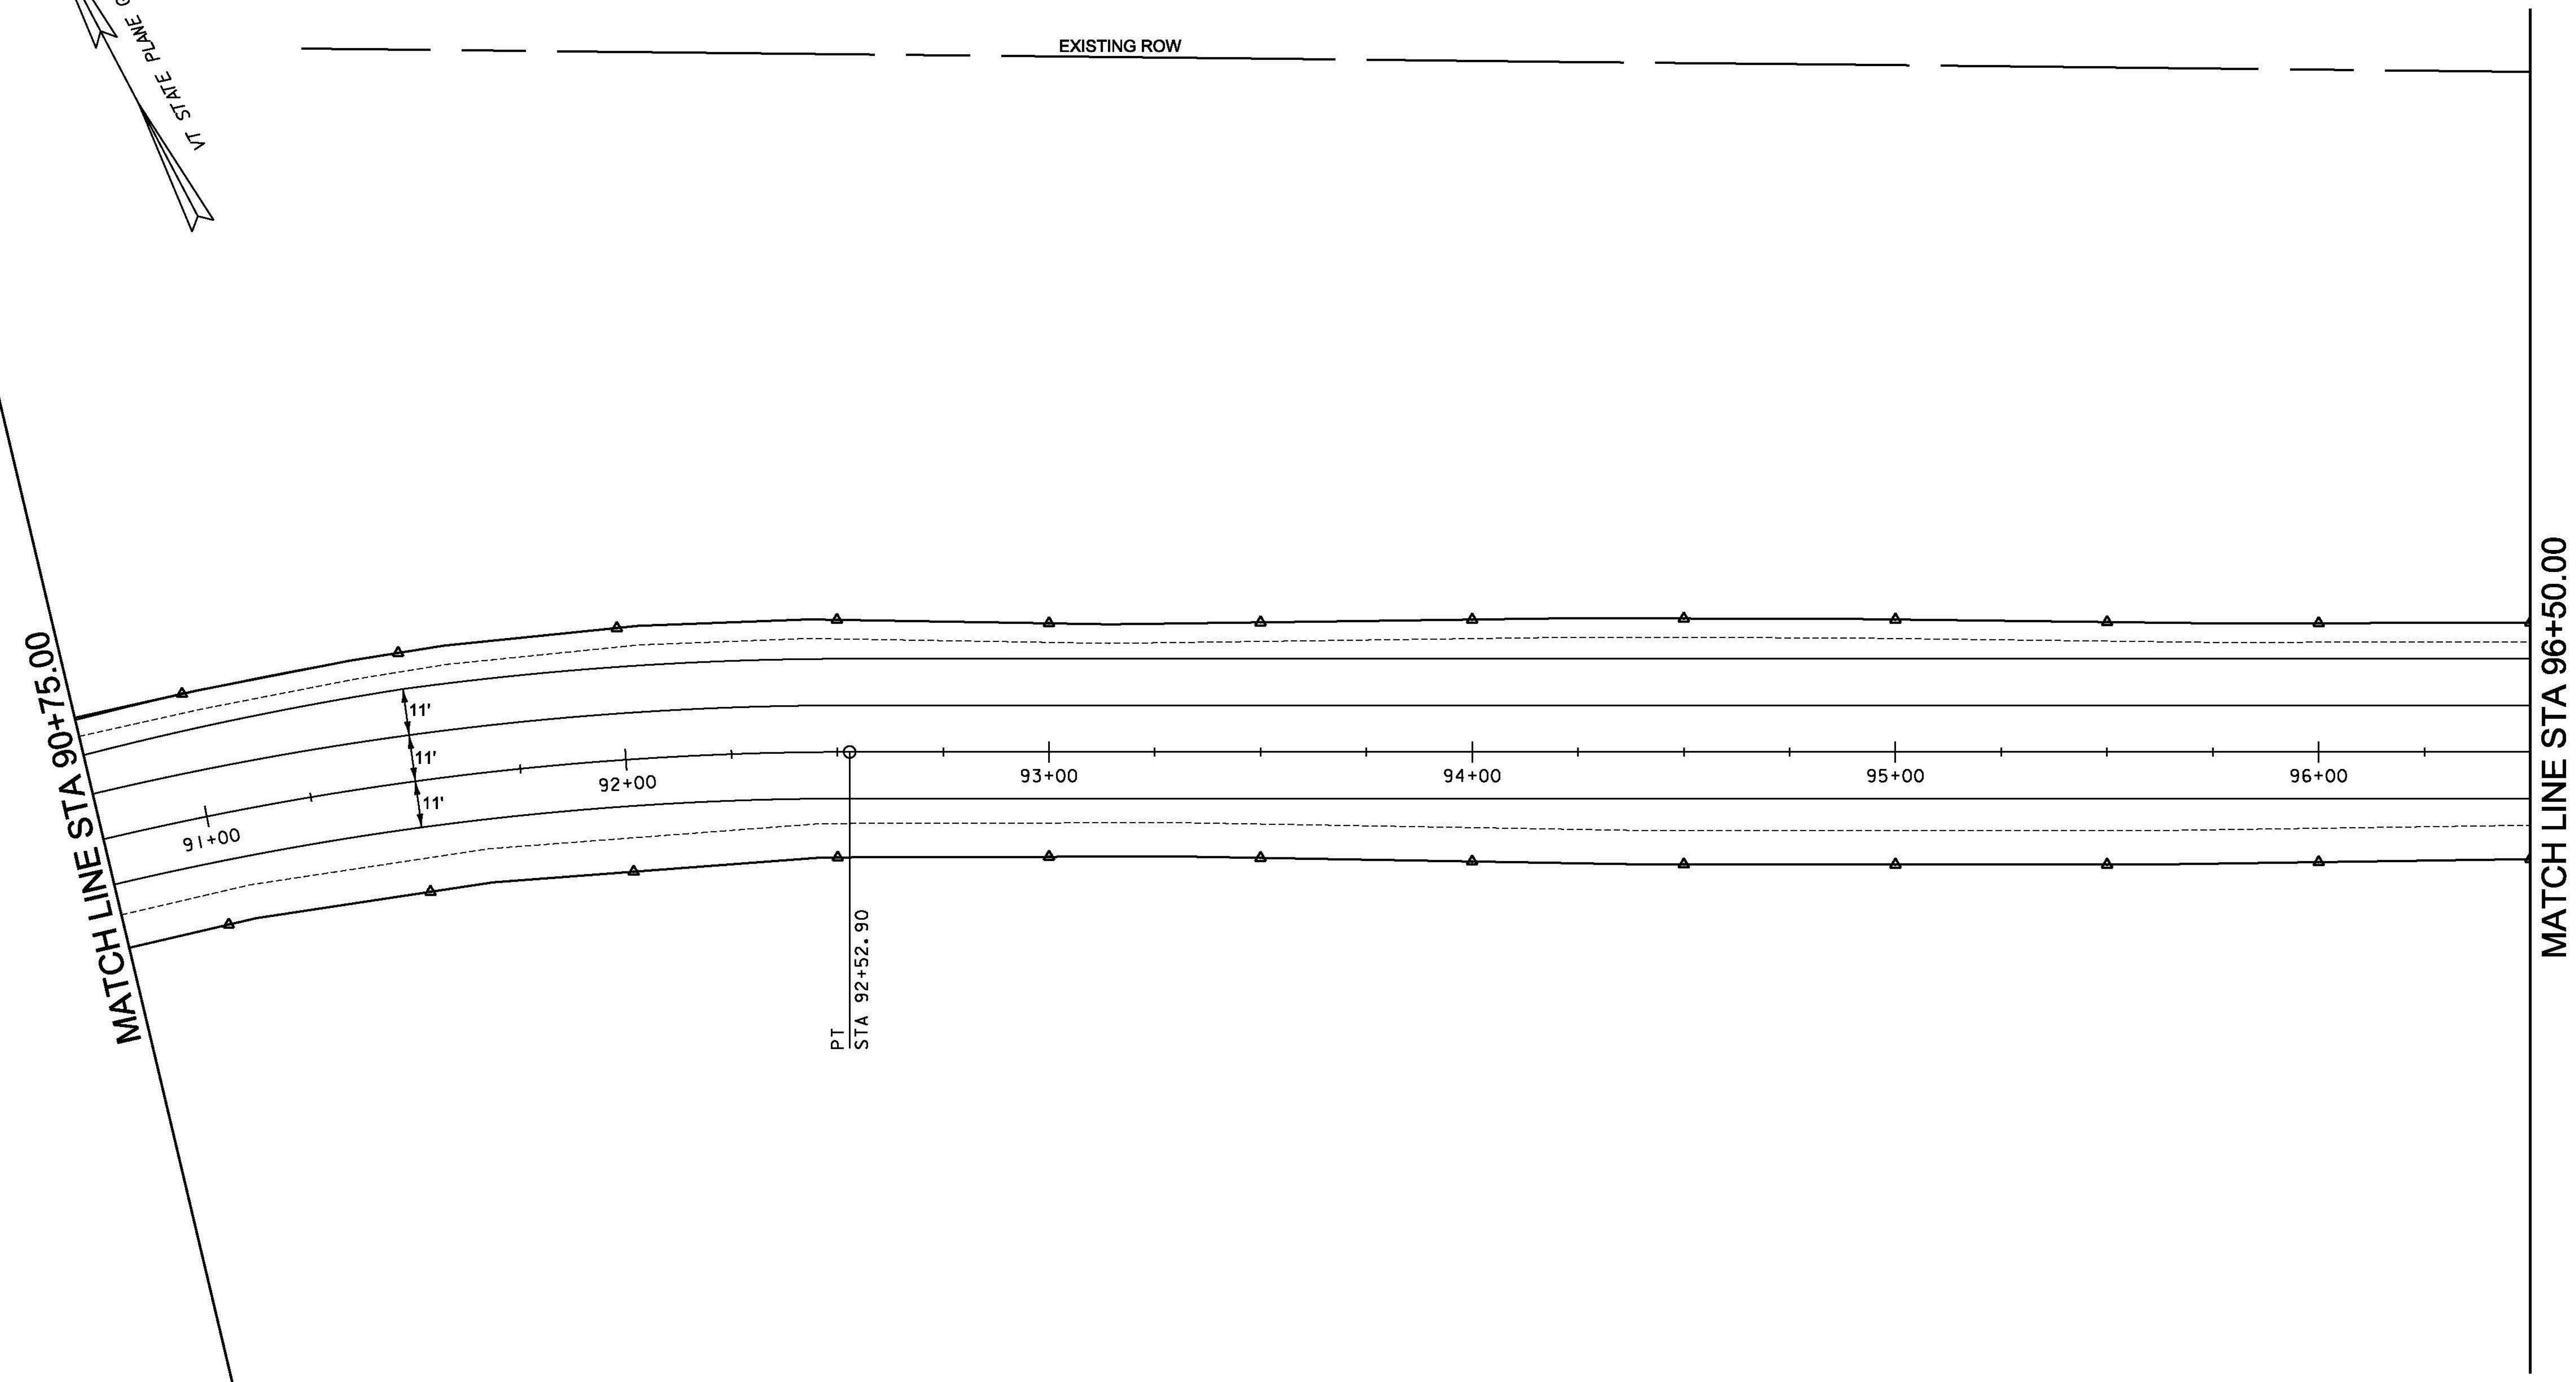

MATCH LINE STA 90+75.00

MATCH LINE STA 96+50.00

PT
 STA 92+52.90

91+00

92+00


93+00

94+00

95+00

96+00

11'
 11'
 11'

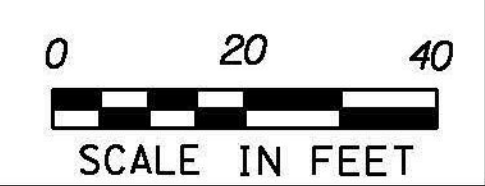

PROJECT NAME: BERLIN	PLOT DATE: 10/20/2014
PROJECT NUMBER: STPG SGNL(40)	DRAWN BY: T. SISSON
FILE NAME: +lib358bdr.dgn	CHECKED BY: M. LACROIX
PROJECT LEADER: P. COBURN	SHEET 29 OF 123
DESIGNED BY: T. SISSON	PLAN SHEET 8