



MATCH LINE STA 96+50.00

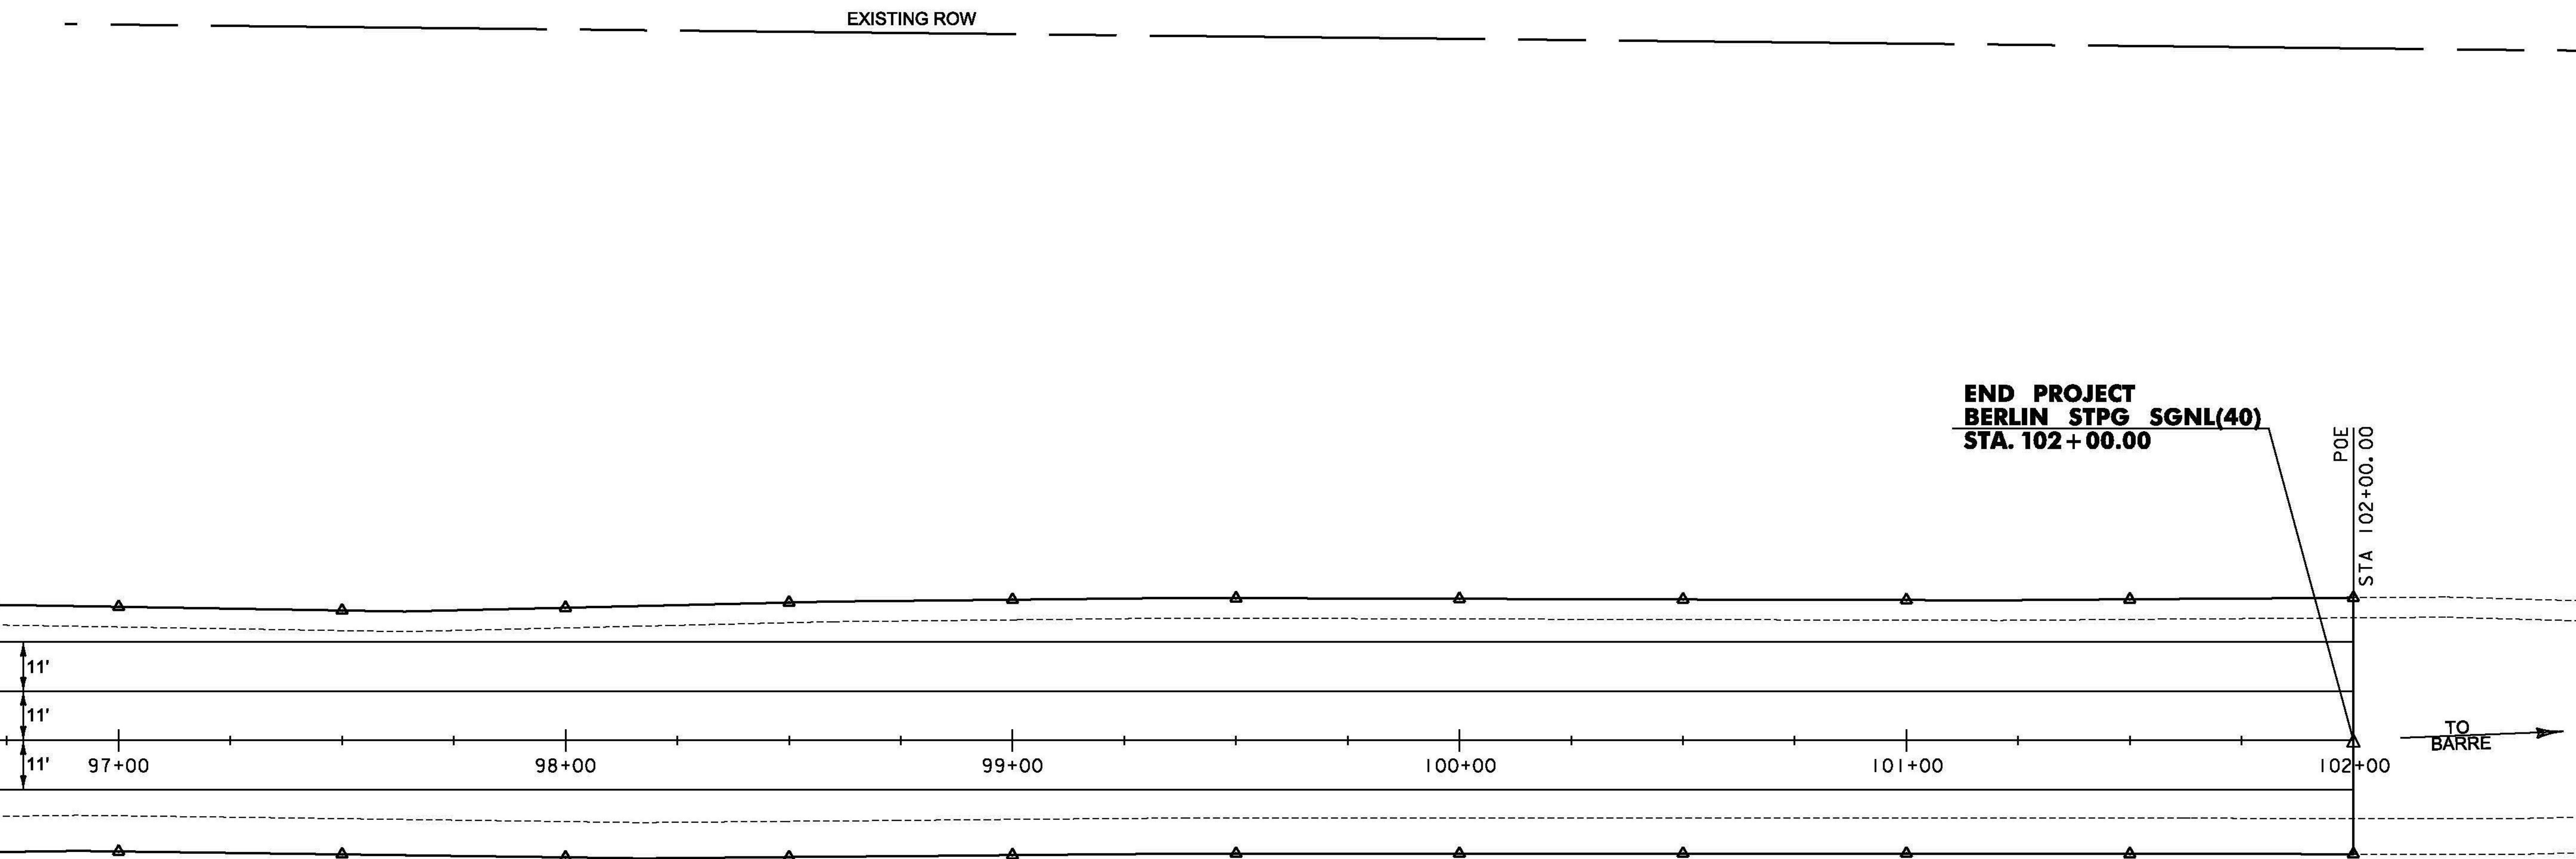

**END PROJECT
BERLIN STPG SGNL(40)
STA. 102+00.00**

POE
STA 102+00.00

TO
BARRE

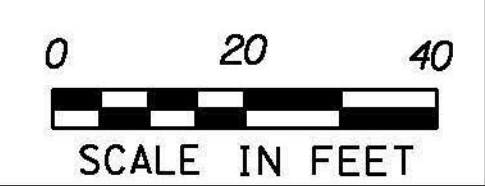

PROJECT NAME: BERLIN	FILE NAME: +lib358bdr.dgn	PLOT DATE: 10/20/2014
PROJECT NUMBER: STPG SGNL(40)	PROJECT LEADER: P. COBURN	DRAWN BY: T. SISSON
	DESIGNED BY: T. SISSON	CHECKED BY: M. LACROIX
	PLAN SHEET 9	SHEET 30 OF 123