



P1

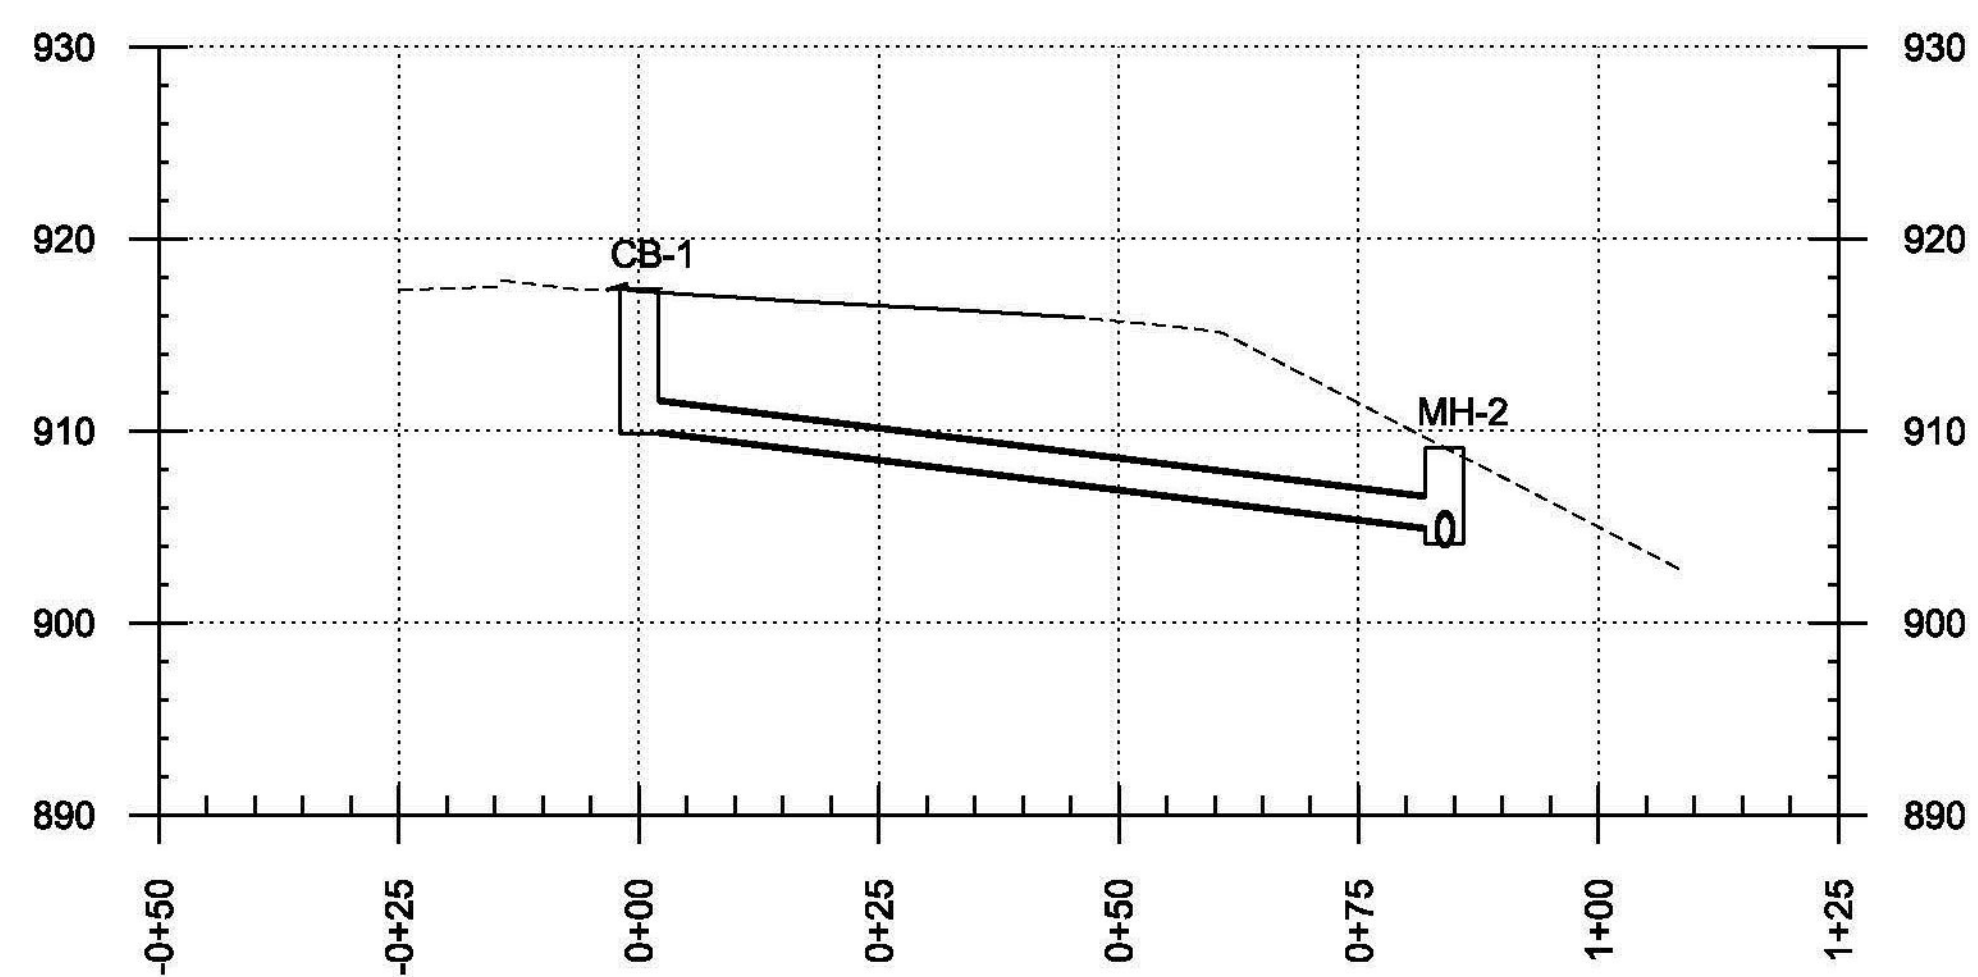

<p>CB-1</p> <p>GRATE = TYPE D SIZE = 4' DIA. RIM = 917.37' SUMP = 0.00' DEPTH = 7.54'</p>	<p>①</p> <p>SLOPE = 6.25% NEW PIPE TYPE: CPEP(SL) LENGTH = 84.00' INV IN = 910.00' INV OUT = 905.00'</p>
---	---

P2

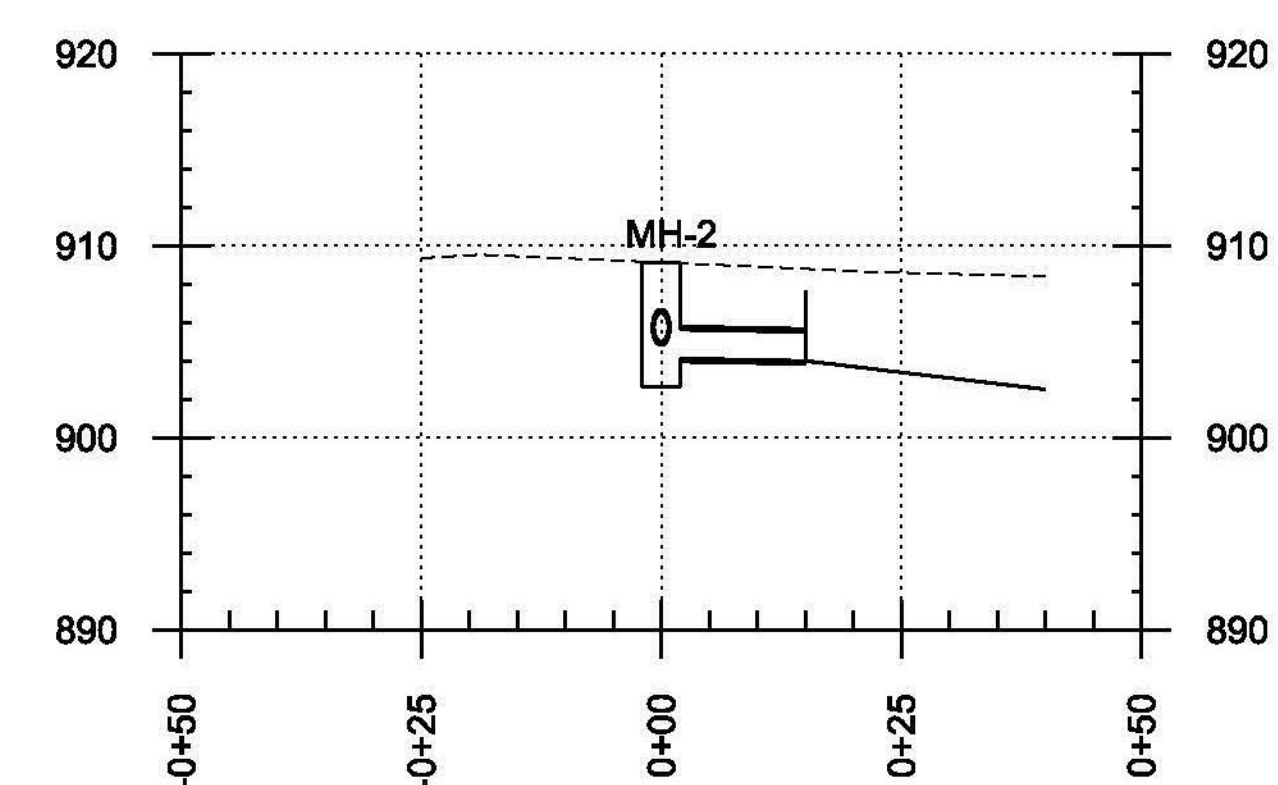

<p>MH-2</p> <p>CAST IRON COVER SIZE = 4' DIA. RIM = 909.13' SUMP = 1.50' DEPTH = 6.50'</p>	<p>②</p> <p>SLOPE = 1.00% NEW PIPE TYPE: CPEP(SL) LENGTH = 15.00' INV IN = 904.13' INV OUT = 904.00'</p>
--	---

PROJECT NAME:	BERLIN
PROJECT NUMBER:	STPG SGNL(40)
FILE NAME: +lib358pro-drn.dgn	PLOT DATE: 10/20/2014
PROJECT LEADER: P. COBURN	DRAWN BY: T. SISSON
DESIGNED BY: T. SISSON	CHECKED BY: M. LACROIX
DRAINAGE PROFILES	SHEET 32 OF 123