


646.4071 - DURABLE 4 INCH WHITE LINE, RECESSED TYPE A TAPE
 A1 - STA. 65+92.66, LT - STA. 70+50.00, LT (SOLID) (452')
 A2 - STA. 65+92.66, LT - STA. 70+50.00, LT (DASHED) (454')
 A3 - STA. 67+00.00, RT - STA. 69+25.63, RT (DOTTED) (227')
 A4 - STA. 69+25.63, RT - STA. 70+50.00, RT (SOLID) (125')
 A5 - STA. 65+92.62 LT - STA. 69+25.63 LT (DASHED) (333')
 A6 - STA. 67+00.00, RT - STA. 69+25.63, RT (DOTTED) (229')
 A7 - STA. 69+25.63, RT - STA. 70+50.00, RT (SOLID) (125')
 A8 - STA. 65+92.66, LT - STA. 70+50.00, LT (SOLID) (463')
 A12 - STA. 69+25.63, LT - STA. 70+50.00, LT (SOLID) (124')

646.4971 - DURABLE LETTER OR SYMBOL, RECESSED TYPE A TAPE
 STA. 69+29.63 RT (A)
 STA. 69+29.63 RT (B)
 STA. 69+29.63 RT (C)
 STA. 69+29.63 RT (D)
 STA. 69+29.63 RT (E)
 STA. 69+29.63 RT (F)
 STA. 69+29.63 RT (G)
 STA. 69+29.63 RT (H)
 STA. 69+29.63 RT (I)
 STA. 69+29.63 RT (J)
 STA. 69+29.63 RT (K)
 STA. 69+29.63 RT (L)
 STA. 69+29.63 RT (M)
 STA. 69+29.63 RT (N)
 STA. 69+29.63 RT (O)
 STA. 69+29.63 RT (P)
 STA. 69+29.63 RT (Q)
 STA. 69+29.63 RT (R)
 STA. 69+29.63 RT (S)
 STA. 69+29.63 RT (T)
 STA. 69+29.63 RT (U)
 STA. 69+29.63 RT (V)
 STA. 69+29.63 RT (W)
 STA. 69+29.63 RT (X)
 STA. 69+29.63 RT (Y)
 STA. 69+29.63 RT (Z)

646.4171 - DURABLE 4 INCH YELLOW LINE, RECESSED TYPE A TAPE
 B1 - STA. 65+92.66, LT - STA. 70+50.00, LT (SOLID) (456')
 B2 - STA. 65+92.66, RT - STA. 70+50.00, LT (SOLID) (460')

**BEGIN PROJECT
 BERLIN STPG SGNL (40)
 STA. 65+92.66**

VT ROUTE 62
 TO BERLIN CORNERS

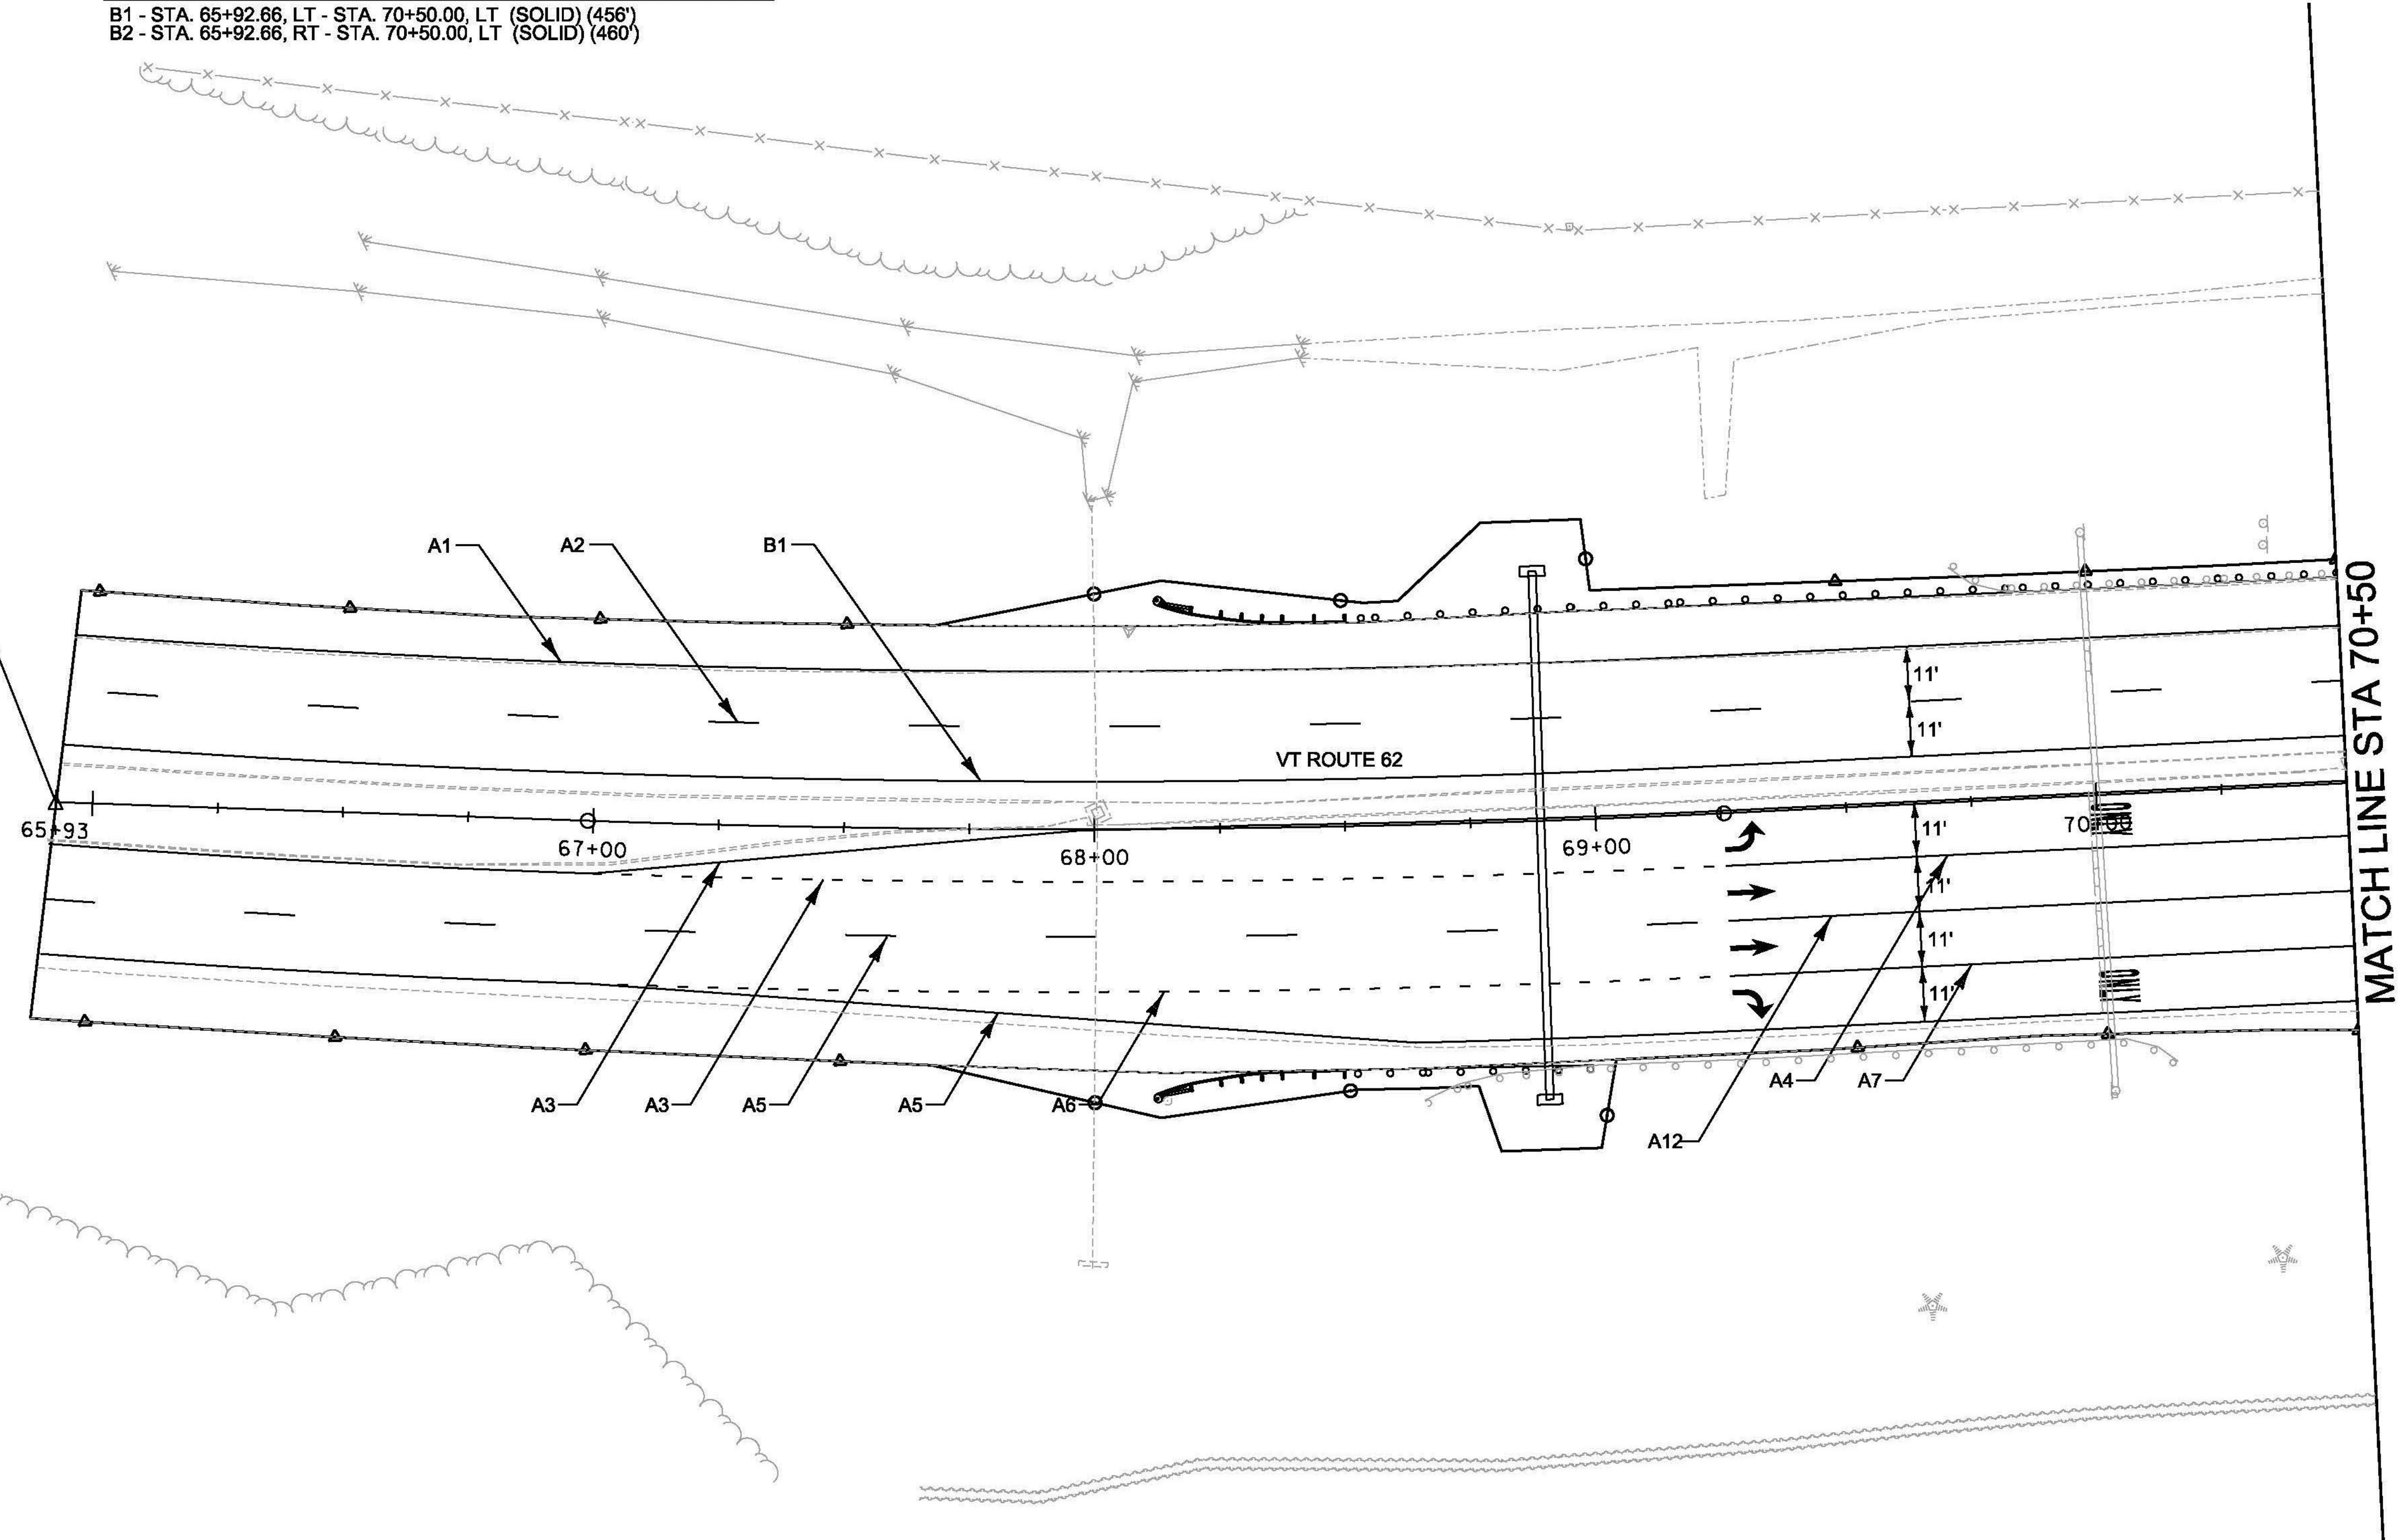

PROJECT NAME:	BERLIN	PLOT DATE:	10/28/2014
PROJECT NUMBER:	STPG SGNL(40)	DRAWN BY:	T. SISSON
FILE NAME:	+lib358bdr.dgn	CHECKED BY:	M. LACROIX
PROJECT LEADER:	P. COBURN	SHEET	45 OF 123
DESIGNED BY:	T. SISSON		
PAVEMENT MARKING SHEET 1			