
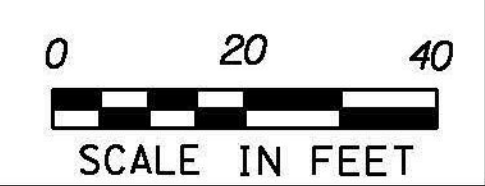


646.4071 - DURABLE 4 INCH WHITE LINE, RECESSED TYPE A TAPE
 A29 - STA. 31+75.00, LT - STA. 34+99.40, LT (SOLID) (325')
 A30 - STA. 31+75.00, LT - STA. 33+00.00, LT (SOLID) (125')
 A31 - STA. 33+00.00, LT - STA. 34+99.40, LT (DASHED) (200')
 A32 - STA. 31+75.00, RT - STA. 34+99.40, RT (DASHED) (325')
 A33 - STA. 31+75.00, RT - STA. 34+99.40, RT (SOLID) (326')

646.4171 - DURABLE 4 INCH YELLOW LINE, RECESSED TYPE A TAPE
 B10 - STA. 31+75.00, LT - STA. 34+99.40, LT (SOLID) (325')
 B11 - STA. 31+75.00, RT - STA. 34+99.40, RT (SOLID) (325')

646.4971 - DURABLE LETTER OR SYMBOL, RECESSED TYPE A TAPE
 STA. 31+98.19, LT ("A")
 STA. 31+98.19, LT ("B")
 STA. 32+51.10 LT ("III")
 STA. 33+04.00 LT ("A")
 STA. 33+04.00 LT ("B")

MATCH LINE STA 31+75

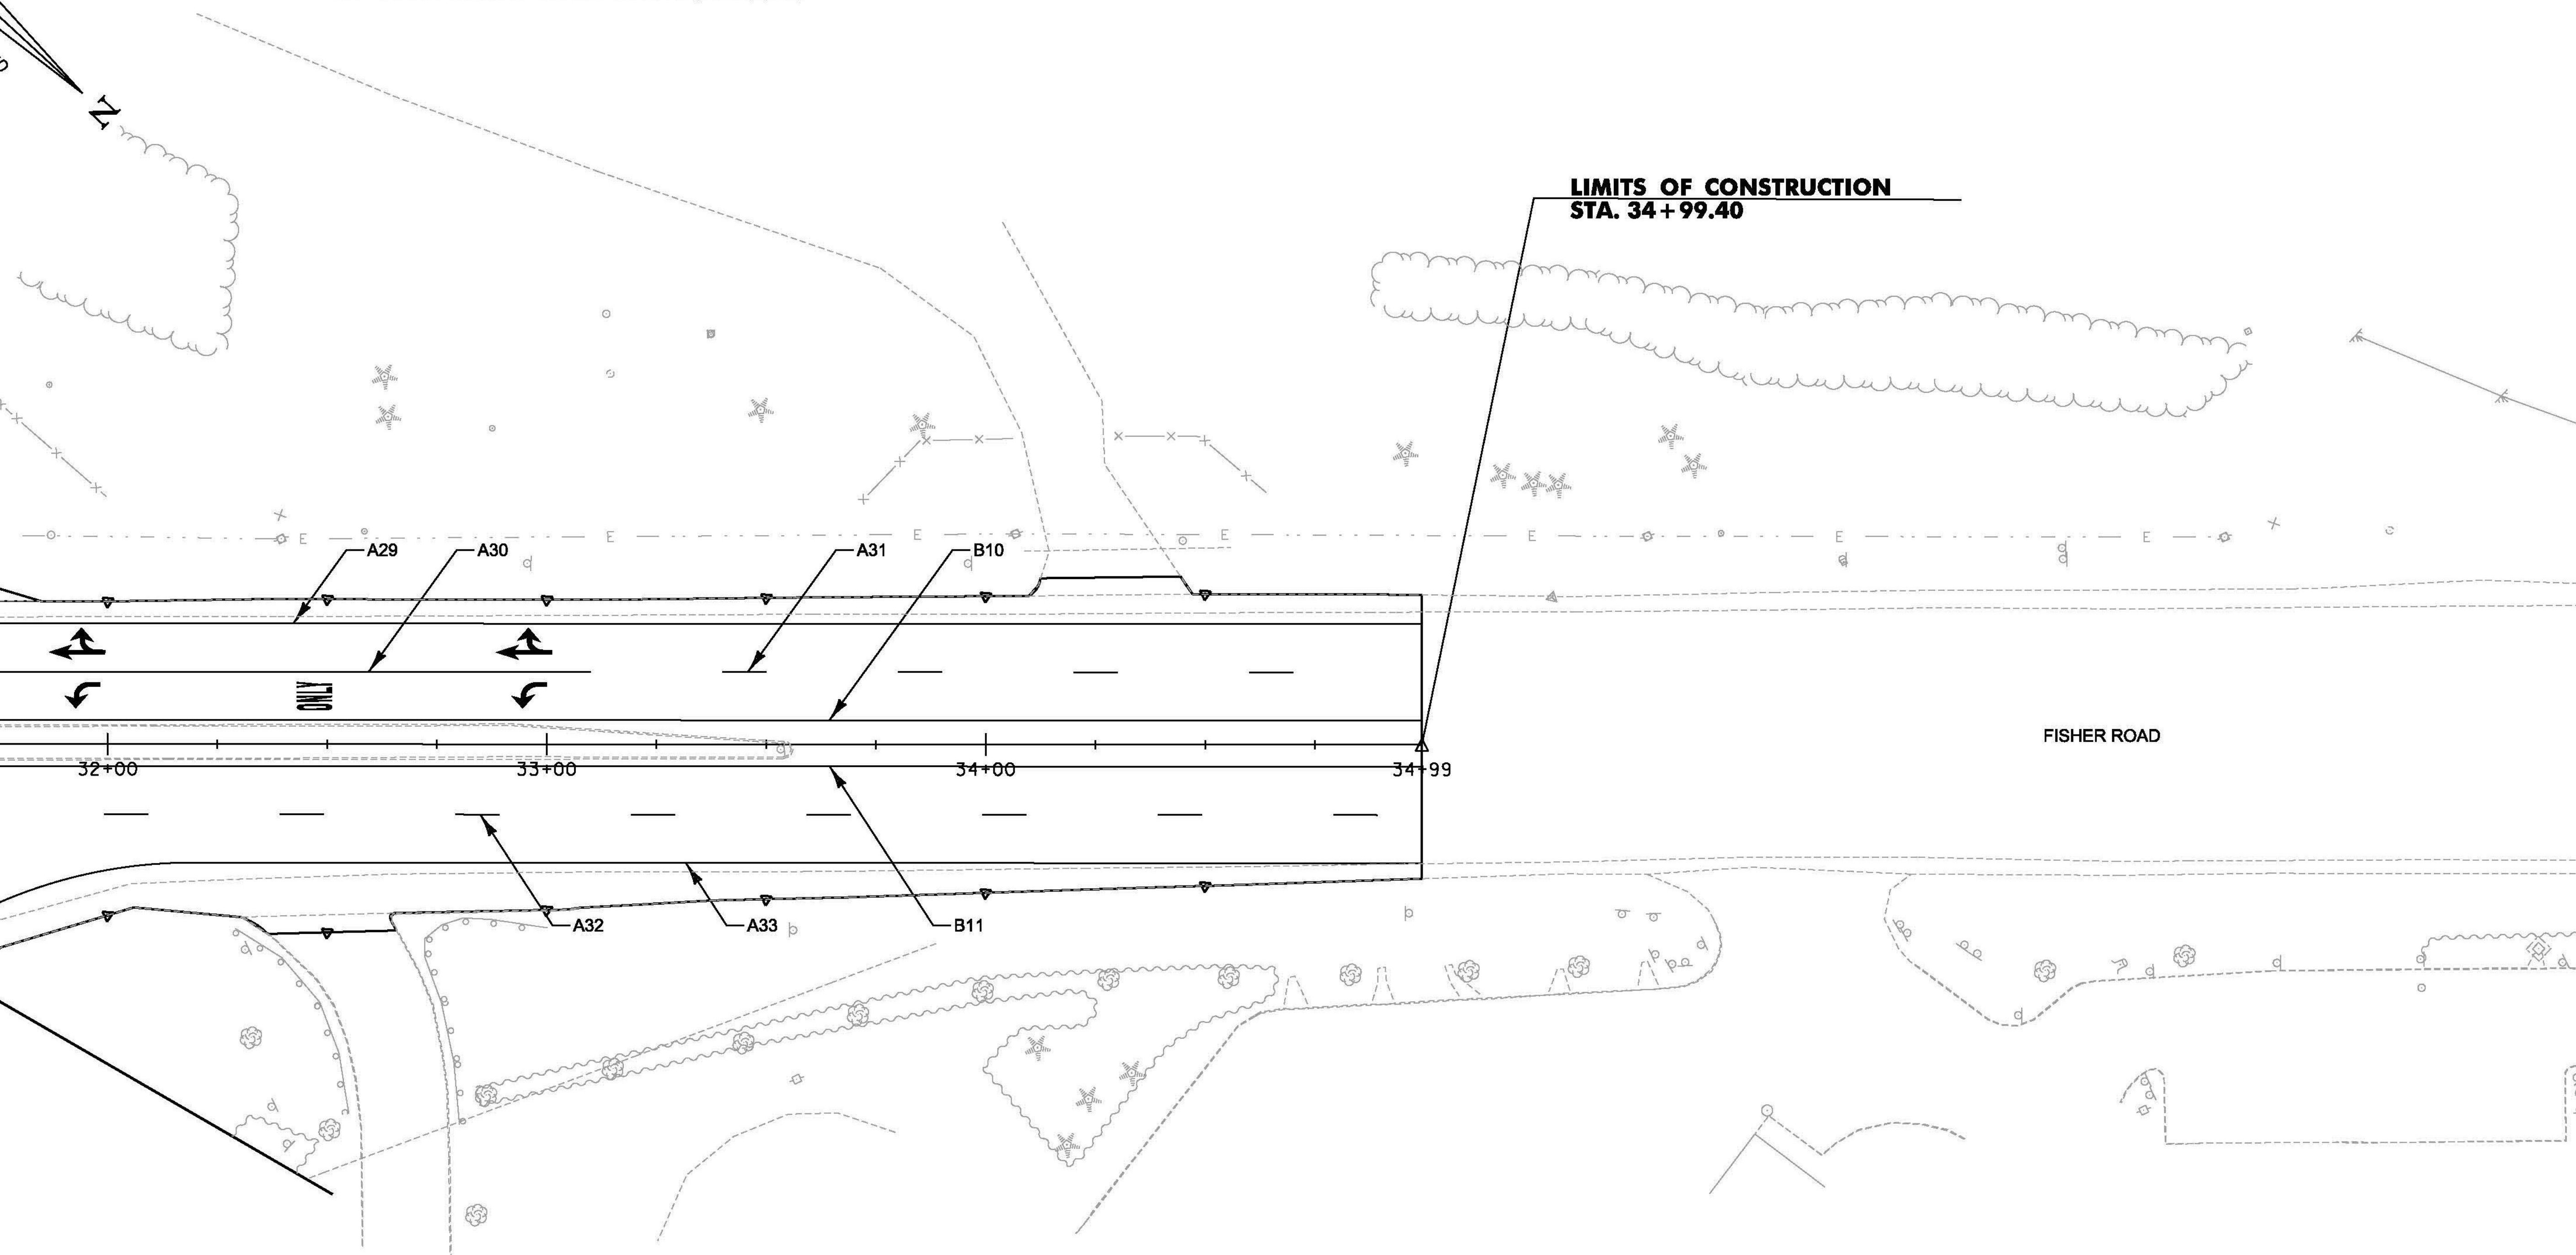

PROJECT NAME:	BERLIN	PLOT DATE:	10/28/2014
PROJECT NUMBER:	STPG SGNL(40)	DRAWN BY:	T. SISSON
FILE NAME:	+lib358bdr.dgn	CHECKED BY:	M. LACROIX
PROJECT LEADER:	P. COBURN	SHEET	48 OF 123
DESIGNED BY:	T. SISSON		
PAVEMENT MARKING SHEET 4			