

646.4071 - DURABLE 4 INCH WHITE LINE, RECESSED TYPE A TAPE

- A39 - STA. 76+00.00, LT - STA. 81+44.03, LT (DIAGONALS) (740')
- A40 - STA. 76+00.00, LT - STA. 81+77.14, LT (SOLID) (577')
- A41 - STA. 76+00.00, LT - STA. 81+77.14, LT (DASHED) (574')
- A42 - STA. 76+00.00, LT - STA. 79+99.23, LT (SOLID) (400')
- A43 - STA. 79+99.23, LT - STA. 81+00.00, LT (DOTTED) (102')
- A44 - STA. 76+00.00, LT - STA. 76+25.18, LT (SOLID) (25')
- A45 - STA. 79+00.00, RT - STA. 81+77.14, RT (SOLID) (264')
- A46 - STA. 79+13.66, RT - STA. 81+77.14, RT (DIAGONALS) (550')
- A47 - STA. 76+00.00, RT - STA. 78+84.68, RT (SOLID) (299')

646.4971 - DURABLE LETTER OR SYMBOL, RECESSED TYPE A TAPE



- STA. 76+01.58, LT ("N")
- STA. 76+76.42, LT ("S")
- STA. 77+51.27, LT ("E")
- STA. 78+26.11, LT ("W")
- STA. 79+00.95, LT (" ")
- STA. 79+75.79, LT (" ")

646.4171 - DURABLE 4 INCH YELLOW LINE, RECESSED TYPE A TAPE

- B15 - STA. 76+00.00, RT - STA. 81+77.14, RT (SOLID) (571')
- B16 - STA. 76+00.00, RT - STA. 81+77.14, RT (SOLID) (567')

646.4671 - DURABLE 12 INCH WHITE LINE, RECESSED TYPE A TAPE

- C3 - STA. 76+25.18, RT - STA. 79+00.00, RT (GORE OUTSIDE) (275')
- C4 - STA. 76+25.18, RT - STA. 78+92.40, RT (GORE OUTSIDE) (281')
- C5 - STA. 76+29.92, RT - STA. 78+99.65, RT (GORE DIAGONALS) (697')

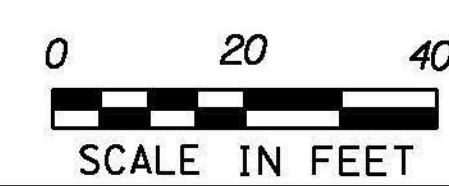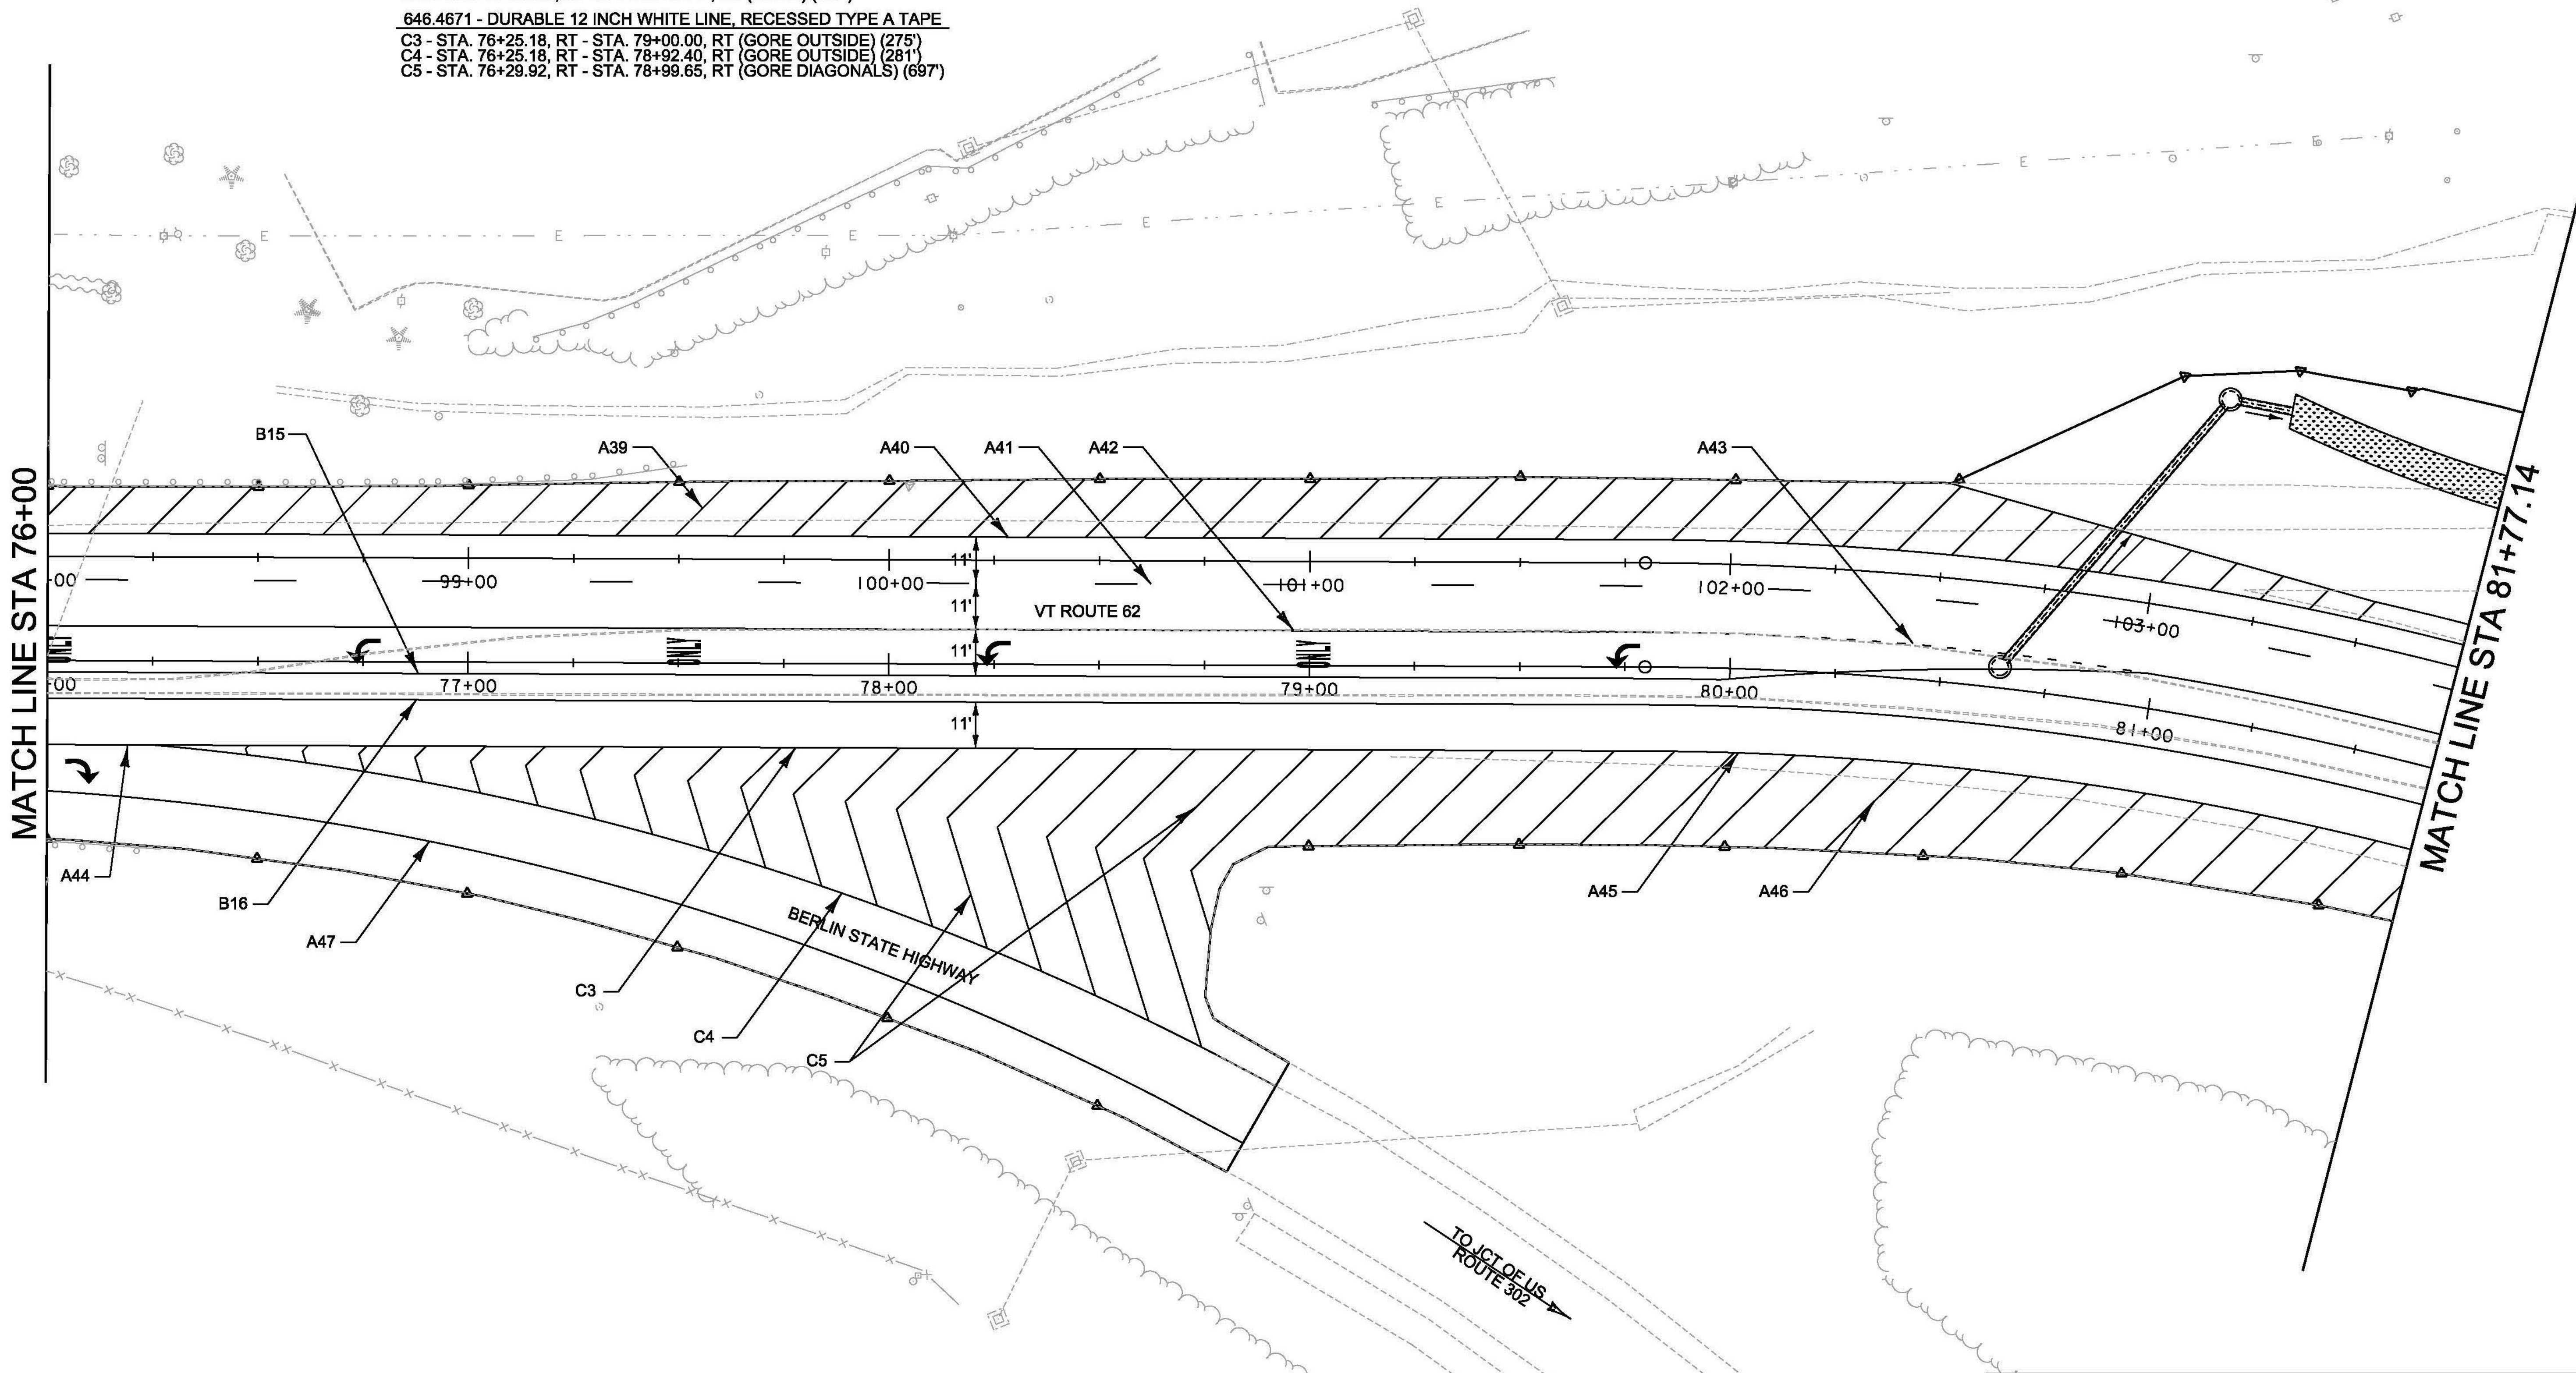

PROJECT NAME:	BERLIN	PLOT DATE:	10/28/2014
PROJECT NUMBER:	STPG SGNL(40)	DRAWN BY:	T. SISSON
FILE NAME:	+lib358bdr.dgn	CHECKED BY:	M. LACROIX
PROJECT LEADER:	P. COBURN	SHEET	49 OF 123
DESIGNED BY:	T. SISSON		
PAVEMENT MARKING SHEET 5			