

646.4071 - DURABLE 4 INCH WHITE LINE, RECESSED TYPE A TAPE
 A48 - STA. 106+32.81, LT - STA. 109+68.00, LT (DIAGONALS) (242')
 A49 - STA. 81+77.14, LT - STA. 109+68.00, LT (SOLID) (591')
 A50 - STA. 82+64.99, LT - STA. 85+00.00, LT (SOLID) (241')
 A51 - STA. 81+77.14, RT - STA. 85+00.00, RT (SOLID) (326')
 A52 - STA. 81+77.14, RT - STA. 83+87.61, RT (DIAGONALS) (240')



646.4171 - DURABLE 4 INCH YELLOW LINE, RECESSED TYPE A TAPE
 B17 - STA. 104+75.00, RT - STA. 109+68.00, RT (SOLID) (494')
 B18 - STA. 81+77.14, LT - STA. 83+75.00, LT (SOLID) (208')
 B19 - STA. 81+77.14, RT - STA. 83+75.00, RT (SOLID) (204')
 B20 - STA. 83+75.00, LT - STA. 85+00.00, LT (DOUBLE) (252')
 B21 - STA. 83+75.00, RT - STA. 85+00.00, RT (DOUBLE) (248')

646.4571 - DURABLE 8 INCH YELLOW LINE, RECESSED TYPE A TAPE
 F2 - STA. 83+75.00, LT - STA. 85+00.00, LT (ISLAND DIAGONALS) (162')

646.4671 - DURABLE 12 INCH WHITE LINE, RECESSED TYPE A TAPE
 C6 - STA. 103+89.70, RT - STA. 104+75.00, RT (GORE OUTSIDE) (88')
 C7 - STA. 81+83.11, LT - STA. 82+64.72, LT (GORE OUTSIDE) (85')

646.4971 - DURABLE LETTER OR SYMBOL, RECESSED TYPE A TAPE
 STA. 108+65.94, LT ("E")
 STA. 109+61.64, LT ("E")

LIMITS OF CONSTRUCTION
STA. 109+68.33

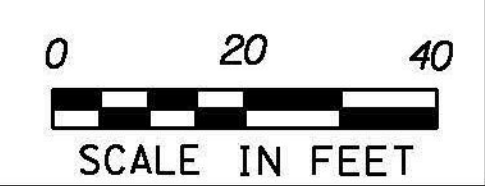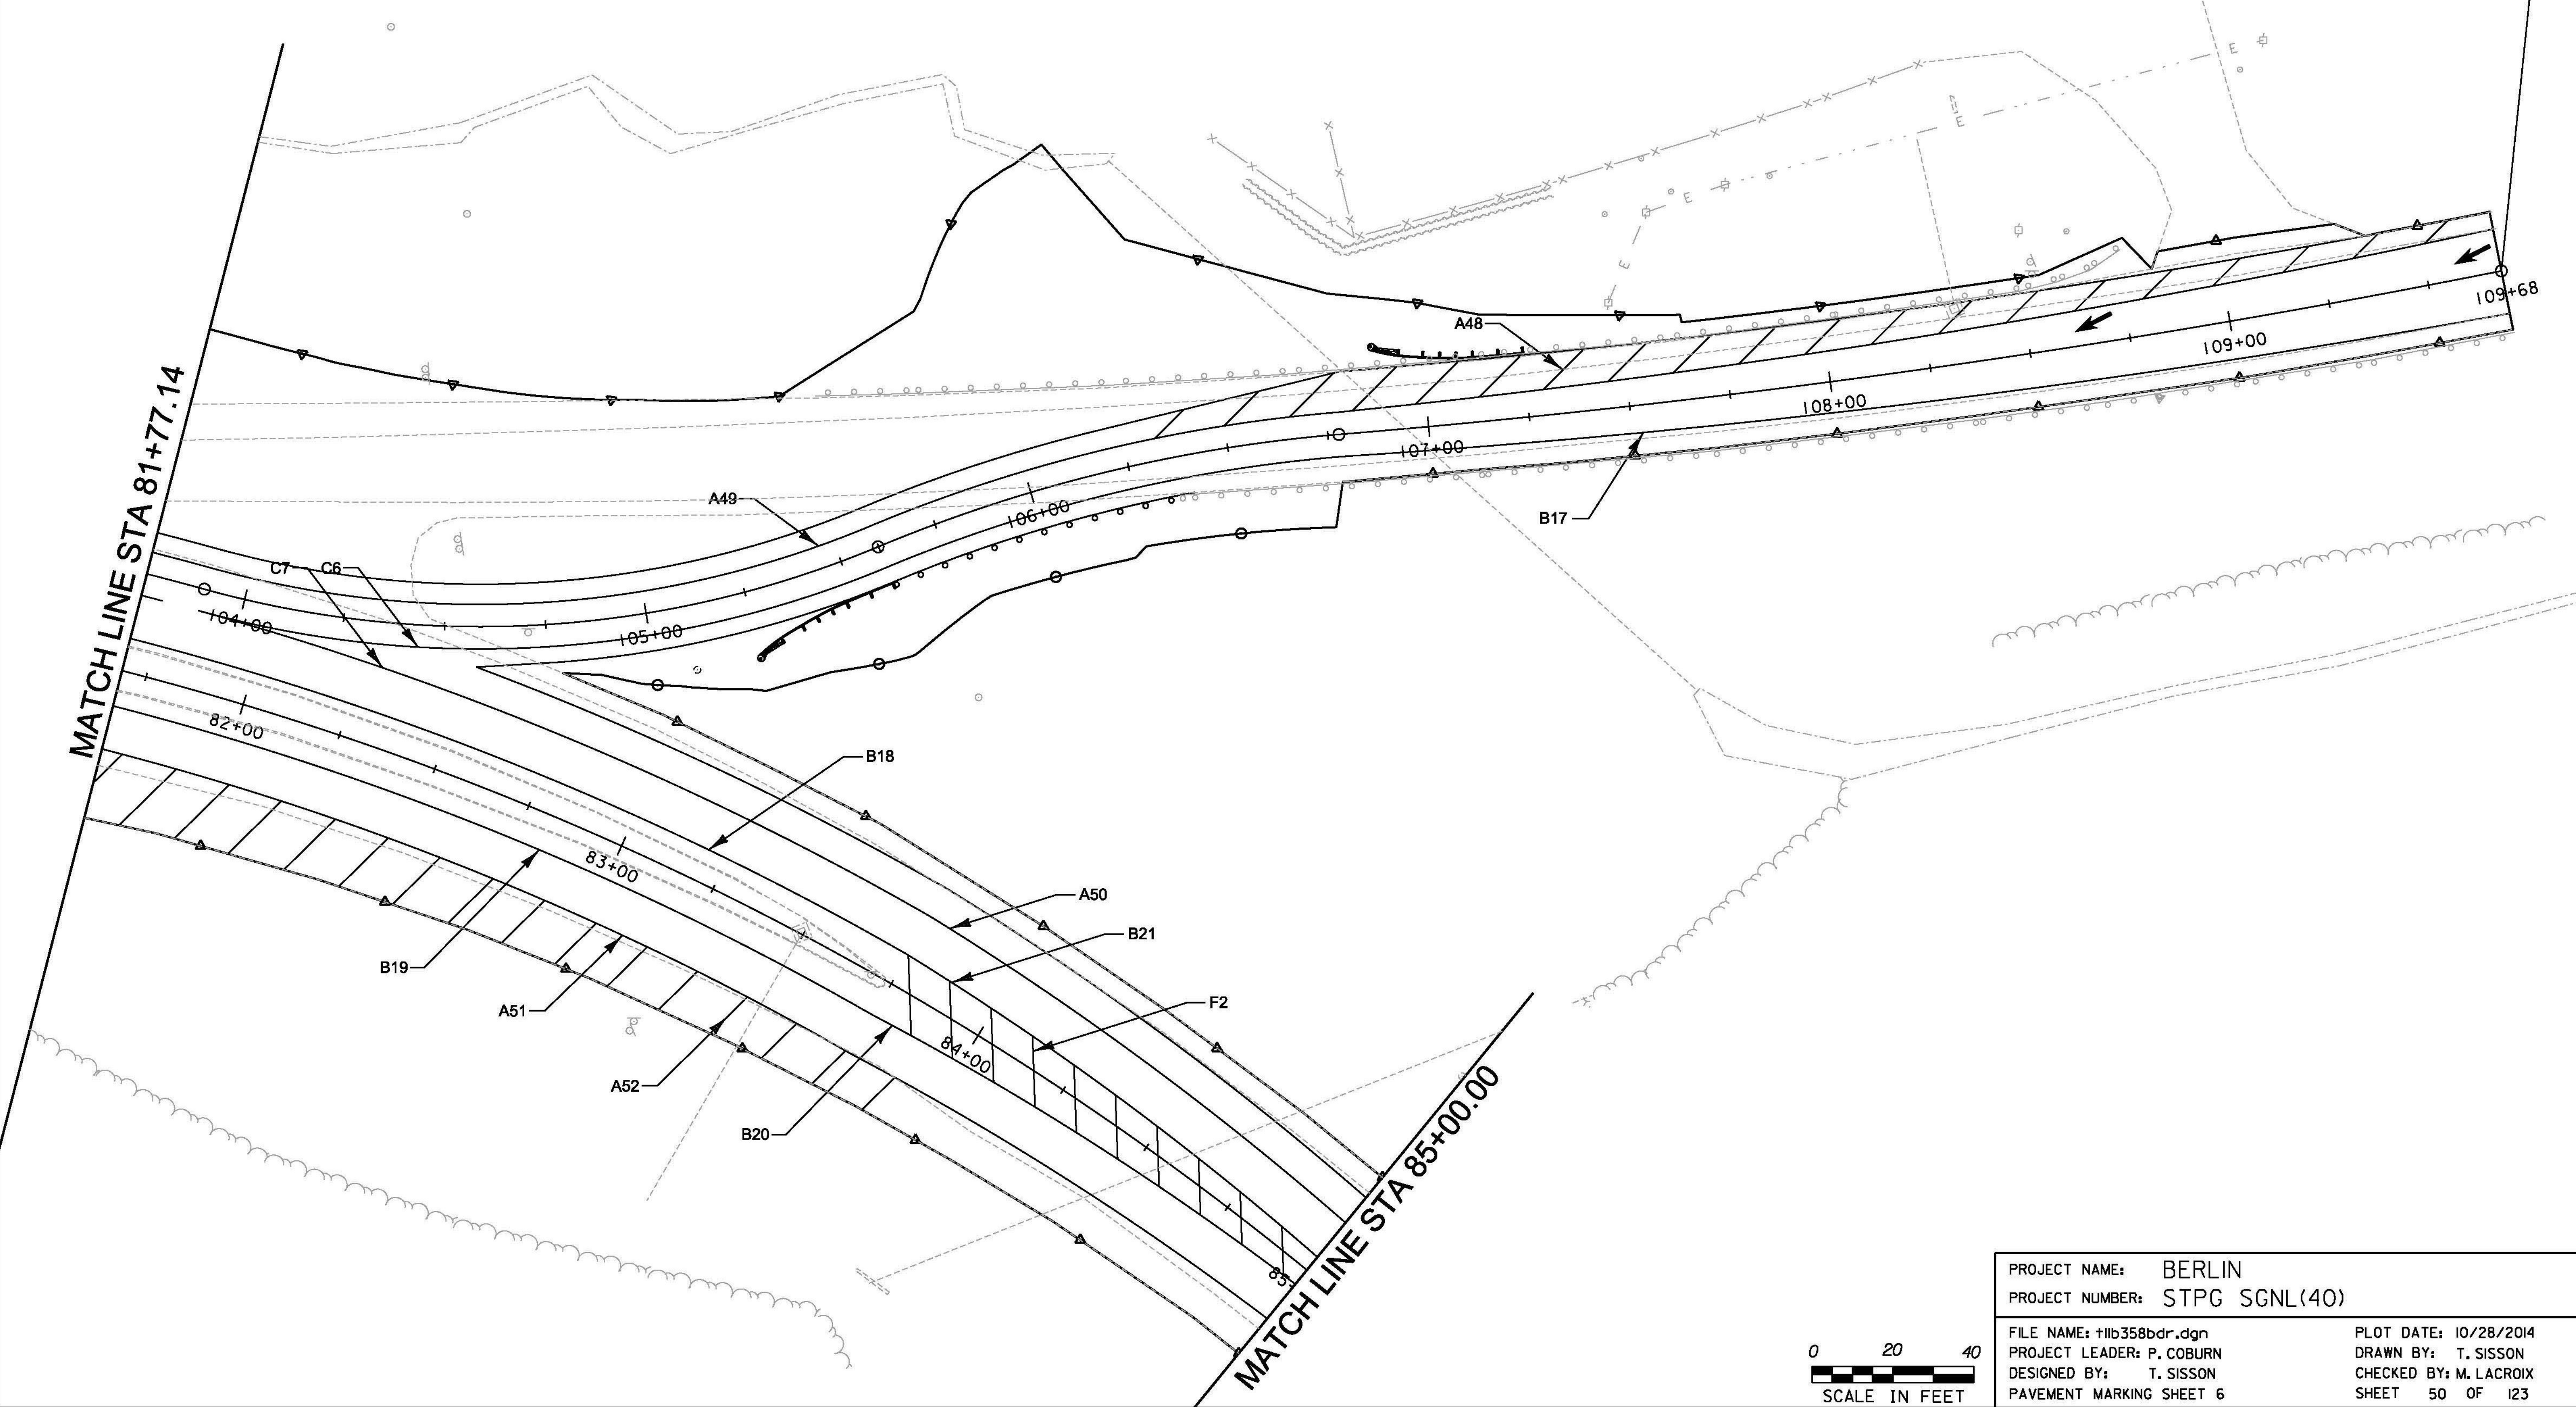

PROJECT NAME:	BERLIN	PLOT DATE:	10/28/2014
PROJECT NUMBER:	STPG SGNL(40)	DRAWN BY:	T. SISSON
FILE NAME:	+11b358bdr.dgn	CHECKED BY:	M. LACROIX
PROJECT LEADER:	P. COBURN	SHEET	50 OF 123
DESIGNED BY:	T. SISSON	PAVEMENT MARKING SHEET	6