


646.4071 - DURABLE 4 INCH WHITE LINE, RECESSED TYPE A TAPE
 A57 - STA. 90+75.00, LT - STA. 96+50.00, RT (SOLID) (550')
 A58 - STA. 90+75.00, LT - STA. 96+50.00, LT (SOLID) (550')
 A59 - STA. 98+13.75, LT - STA. 102+00.00, LT (DASHED) (326')
 646.4171 - DURABLE 4 INCH YELLOW LINE, RECESSED TYPE A TAPE
 B26 - STA. 96+50.00, CL - STA. 102+00.00, CL (DOUBLE) (1100')
 646.4971 - DURABLE LETTER OR SYMBOL, RECESSED TYPE A TAPE
 STA. 98+00.00, LT ("↖")


MATCH LINE STA 96+50.00

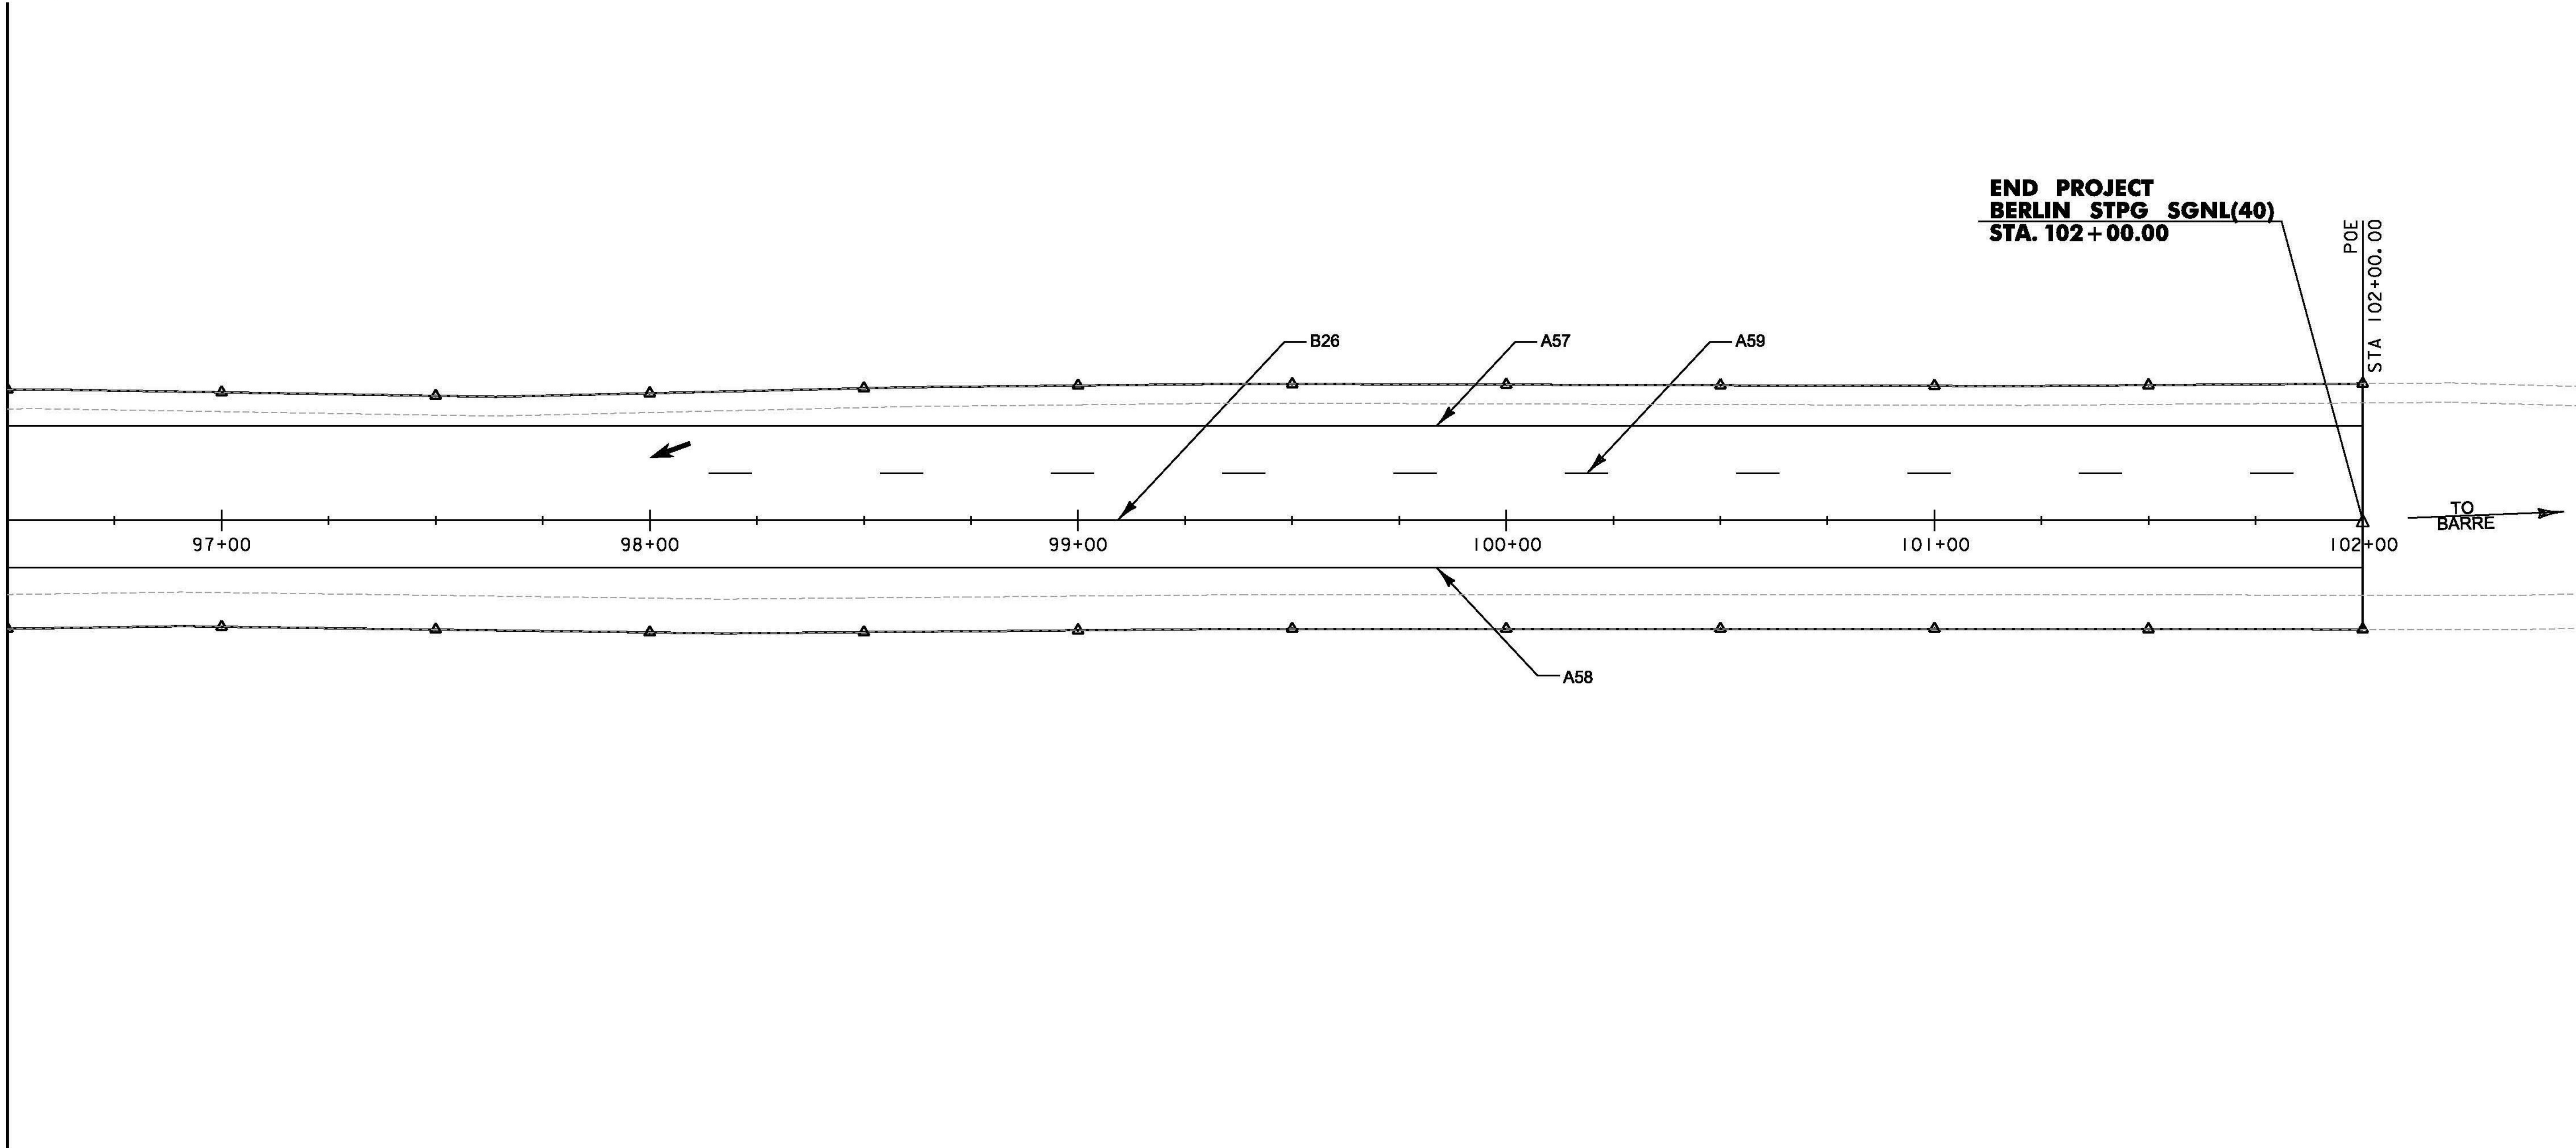

END PROJECT
BERLIN STPG SGNL(40)
STA. 102+00.00

POE
STA 102+00.00

TO BARRE

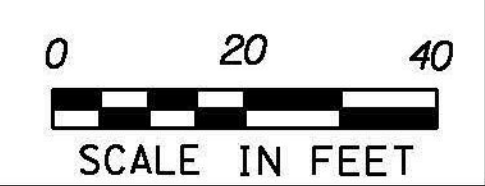

PROJECT NAME: BERLIN	PLOT DATE: 10/28/2014
PROJECT NUMBER: STPG SGNL(40)	DRAWN BY: T. SISSON
FILE NAME: +11b358bdr.dgn	CHECKED BY: M. LACROIX
PROJECT LEADER: P. COBURN	SHEET 53 OF 123
DESIGNED BY: T. SISSON	
PAVEMENT MARKING SHEET 9	