

675.20 - TRAFFIC SIGNS, TYPE A
SEE TRAFFIC SUMMARY SHEETS

675.21 - TRAFFIC SIGNS, TYPE B
SEE TRAFFIC SUMMARY SHEETS

675.50 - REMOVING SIGNS (TYPE A)
AS SHOWN - 7









675.50 - REMOVING SIGNS (TYPE B)
AS SHOWN - 5

675.341 - SQUARE TUBE SIGN POST AND ANCHOR
SEE TRAFFIC SUMMARY SHEETS


677.13 - OVERHEAD TRAFFIC SIGN SUPPORT, MULTI-SUPPORT
STA. 68+88.96, RT - STA. 68+89.03, LT 1 EA

677.35 - REMOVE EXISTING OVERHEAD SIGN ASSEMBLY, MULTI-SUPPORT
STA. 69+99.26, LT - STA. 70+01.02, RT 1 EA

BEGIN PROJECT
BERLIN STPG SGNL (40)
STA. 65+92.66

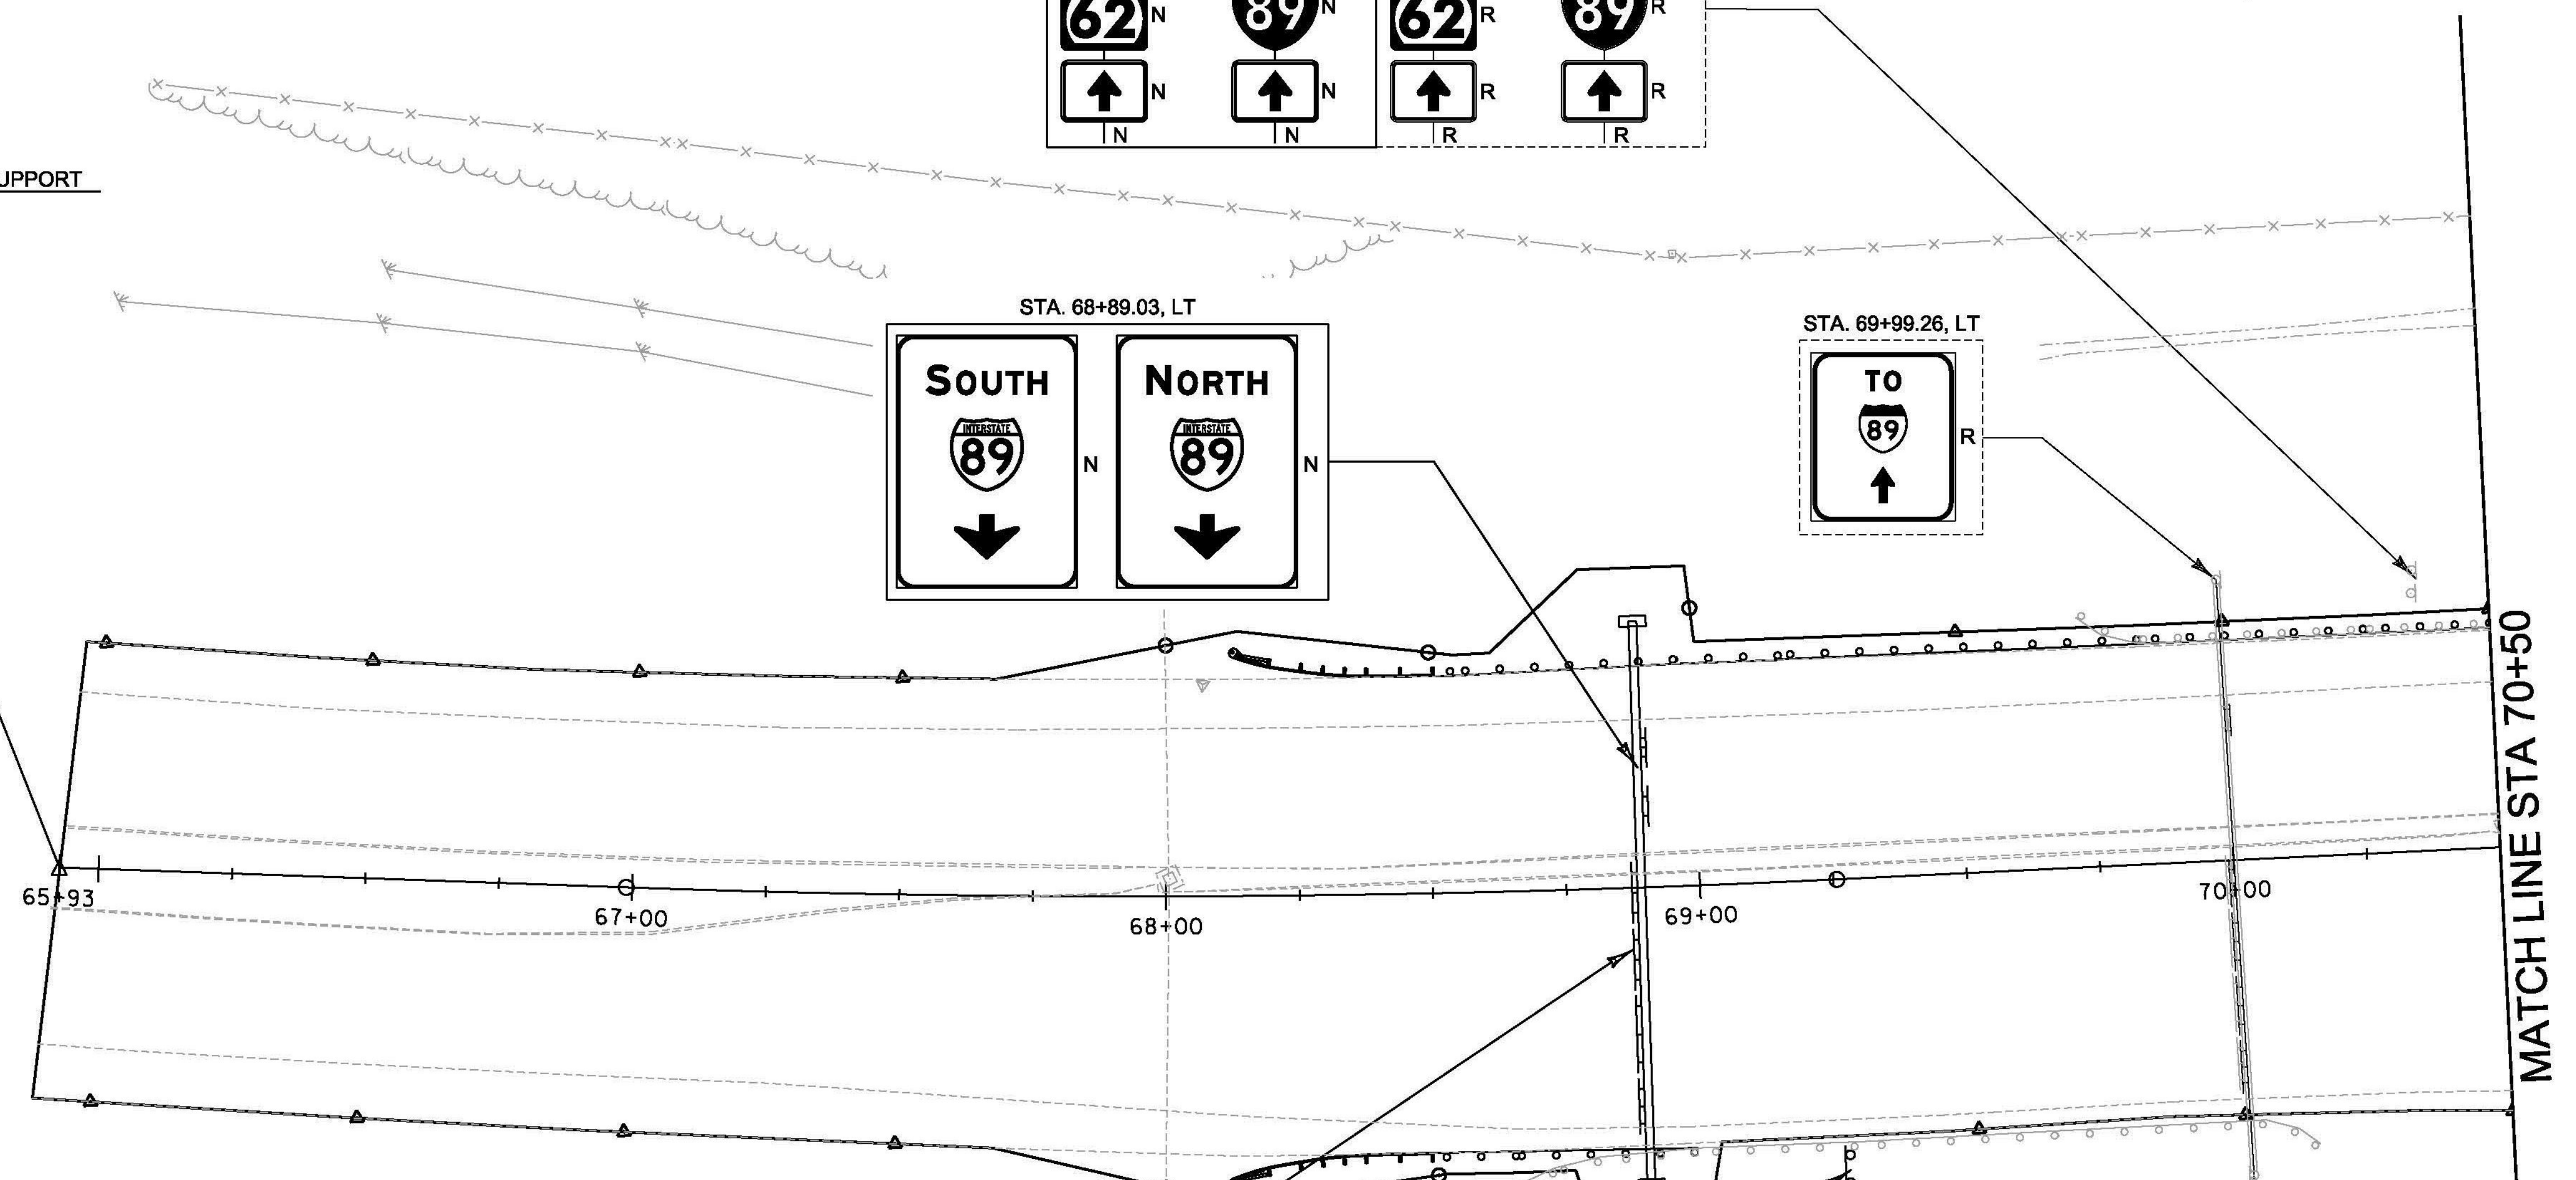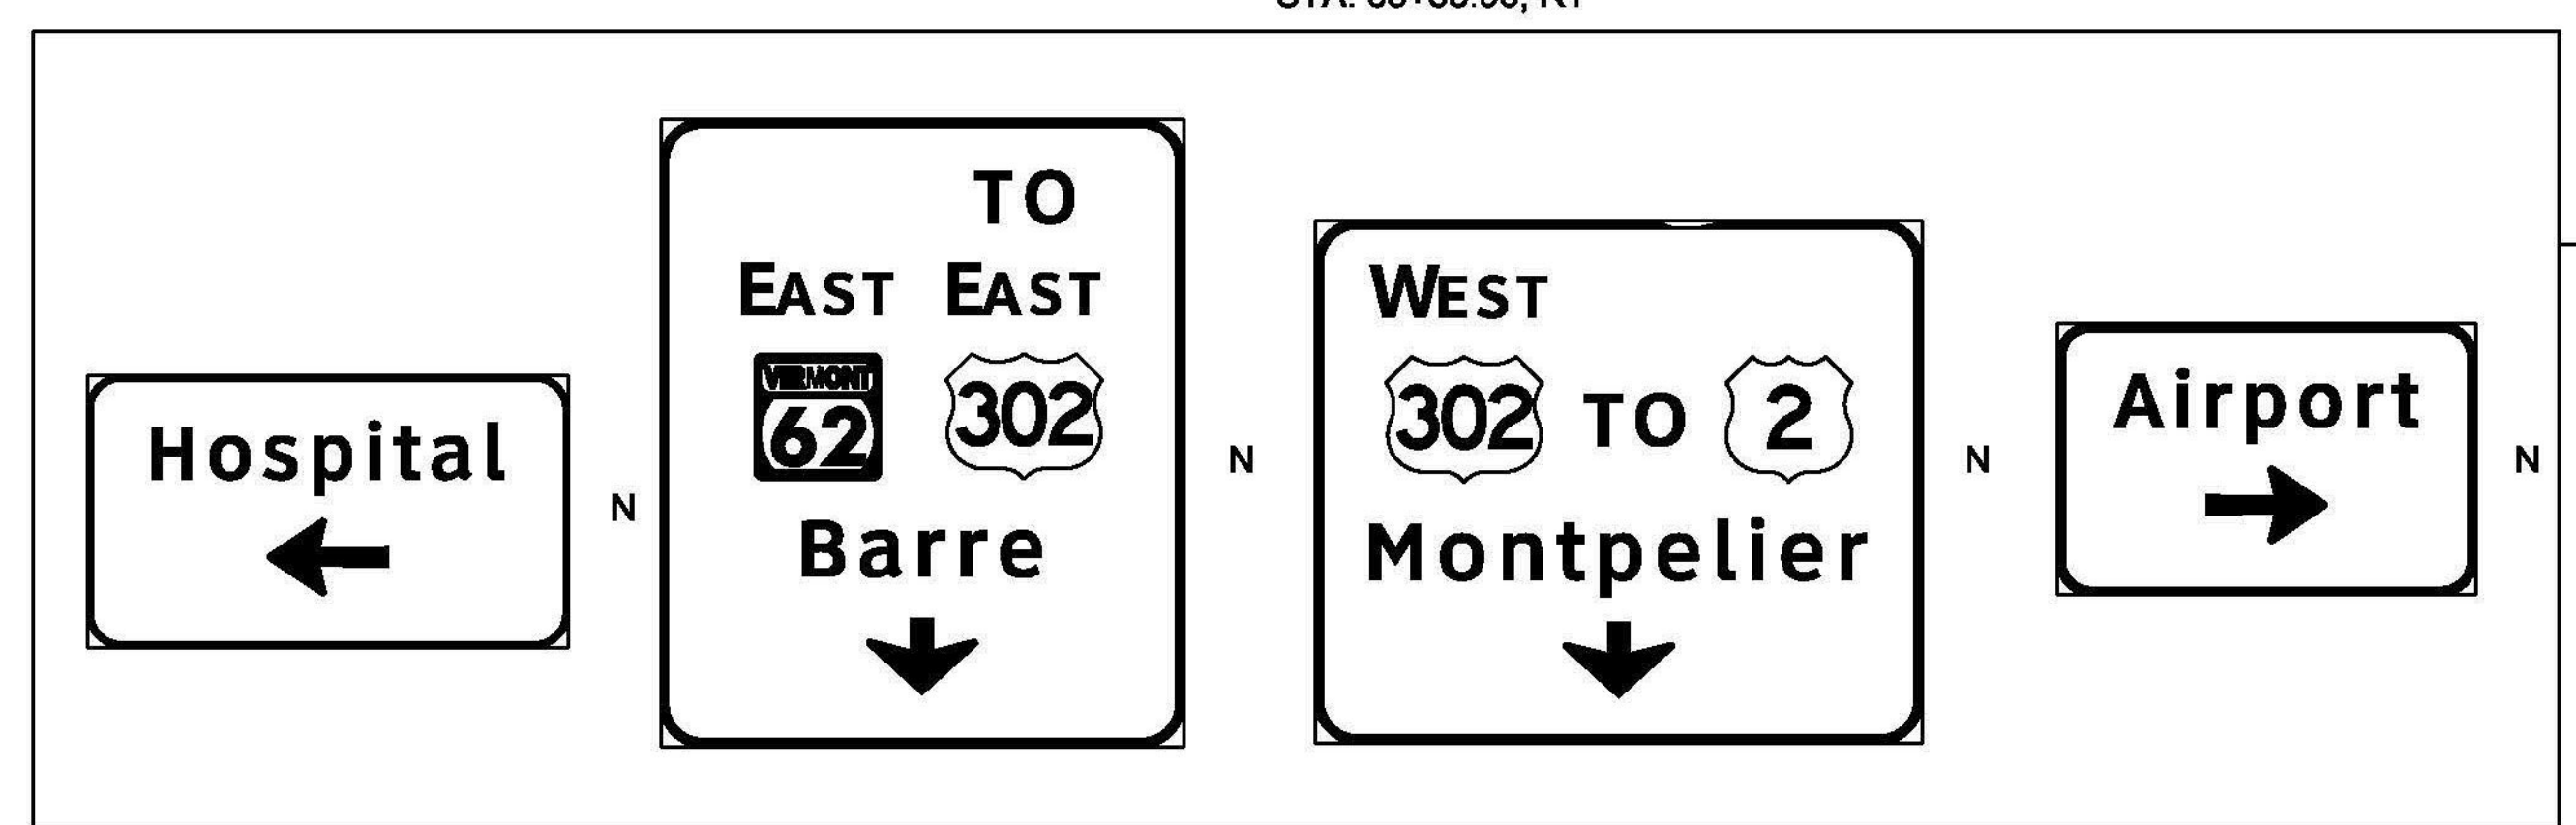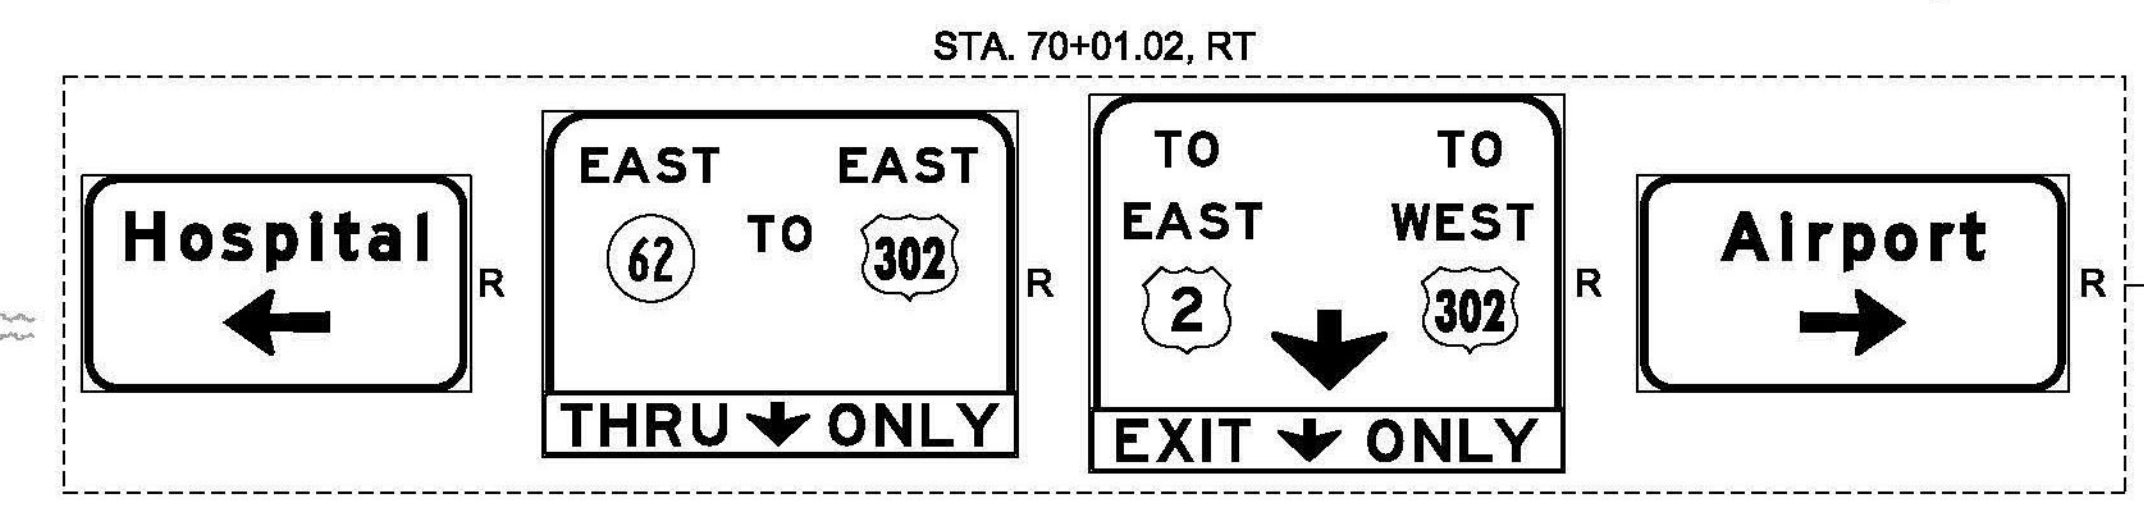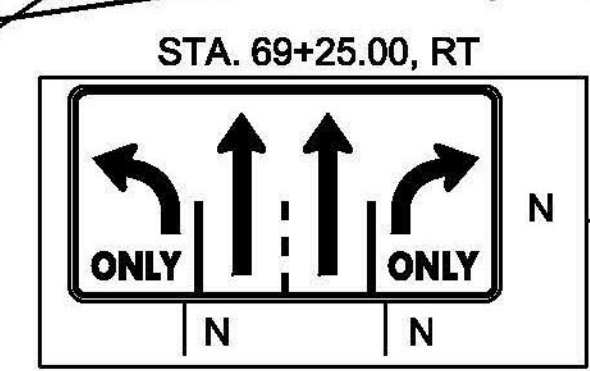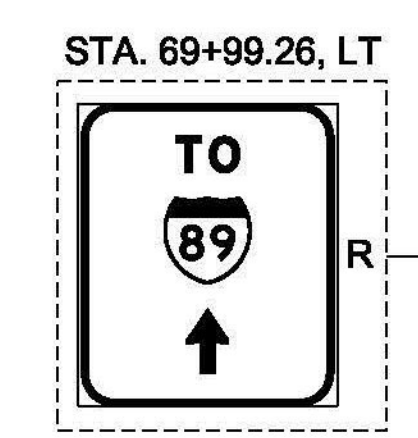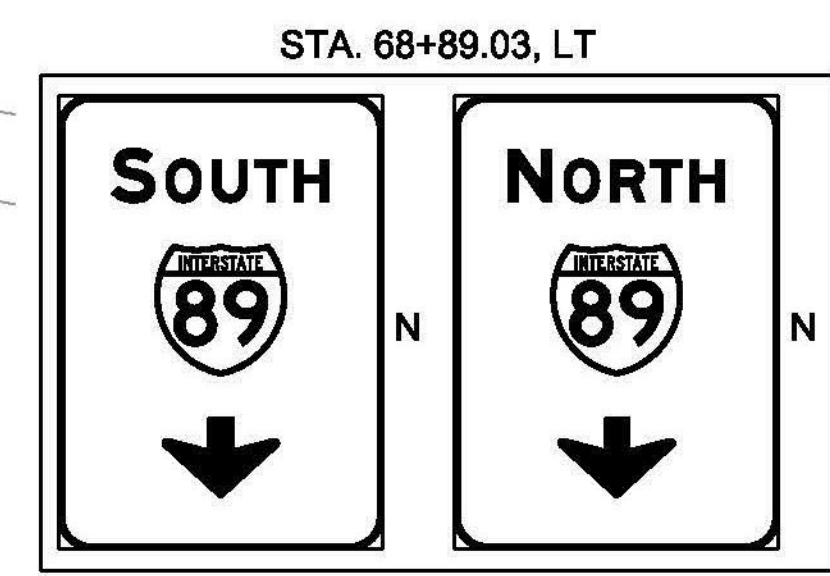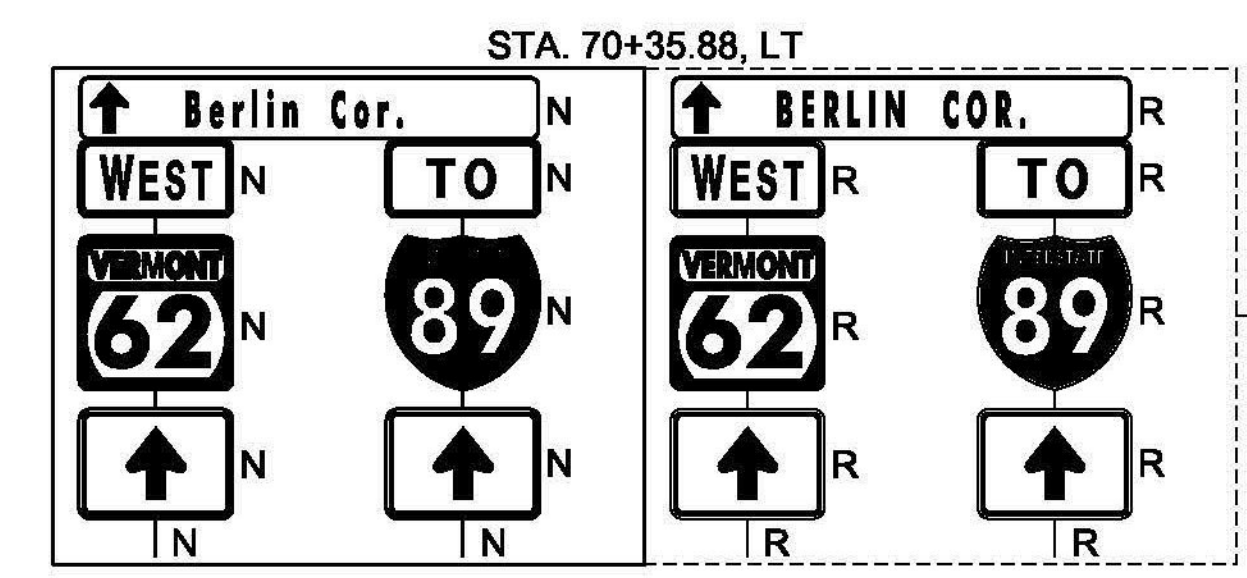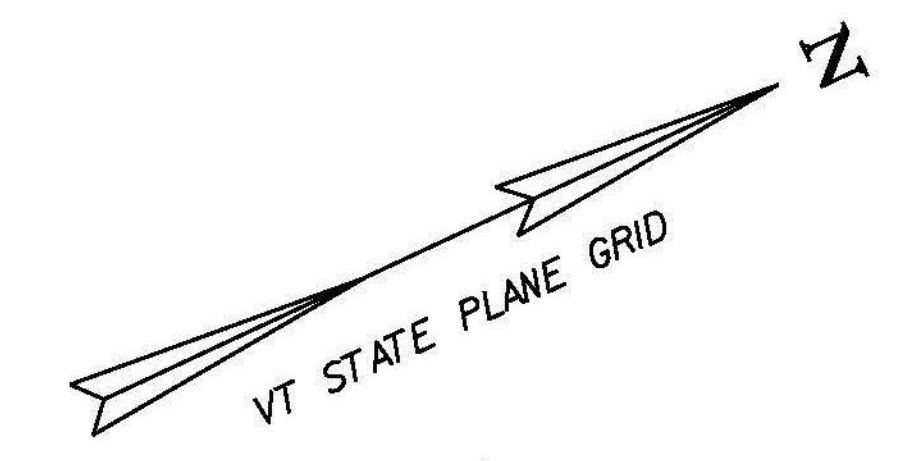

LEGEND
 R = REMOVE
 N = NEW
 B-B = MOUNTED BACK TO BACK

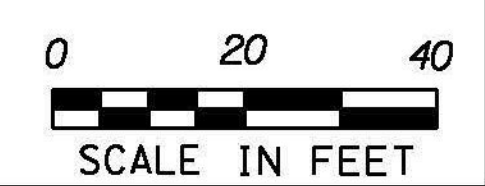

PROJECT NAME: BERLIN
 PROJECT NUMBER: STPG SGNL(40)
 FILE NAME: +lib358bdr.dgn PLOT DATE: 10/28/2014
 PROJECT LEADER: P. COBURN DRAWN BY: T. SISSON
 DESIGNED BY: T. SISSON CHECKED BY: M. LACROIX
 TRAFFIC SIGNING SHEET 1 SHEET 54 OF 123