


NOTE:  
RETAIN SIGN BRIDGE AND OVERHEAD  
SIGNS AT STA. 75+99.49, LT-RT.

675.20 - TRAFFIC SIGNS, TYPE A  
SEE TRAFFIC SUMMARY SHEETS  
675.50 - REMOVING SIGNS (TYPE A)  
AS SHOWN - 56  
675.341 - SQUARE TUBE SIGN POST AND ANCHOR.  
SEE TRAFFIC SUMMARY SHEETS

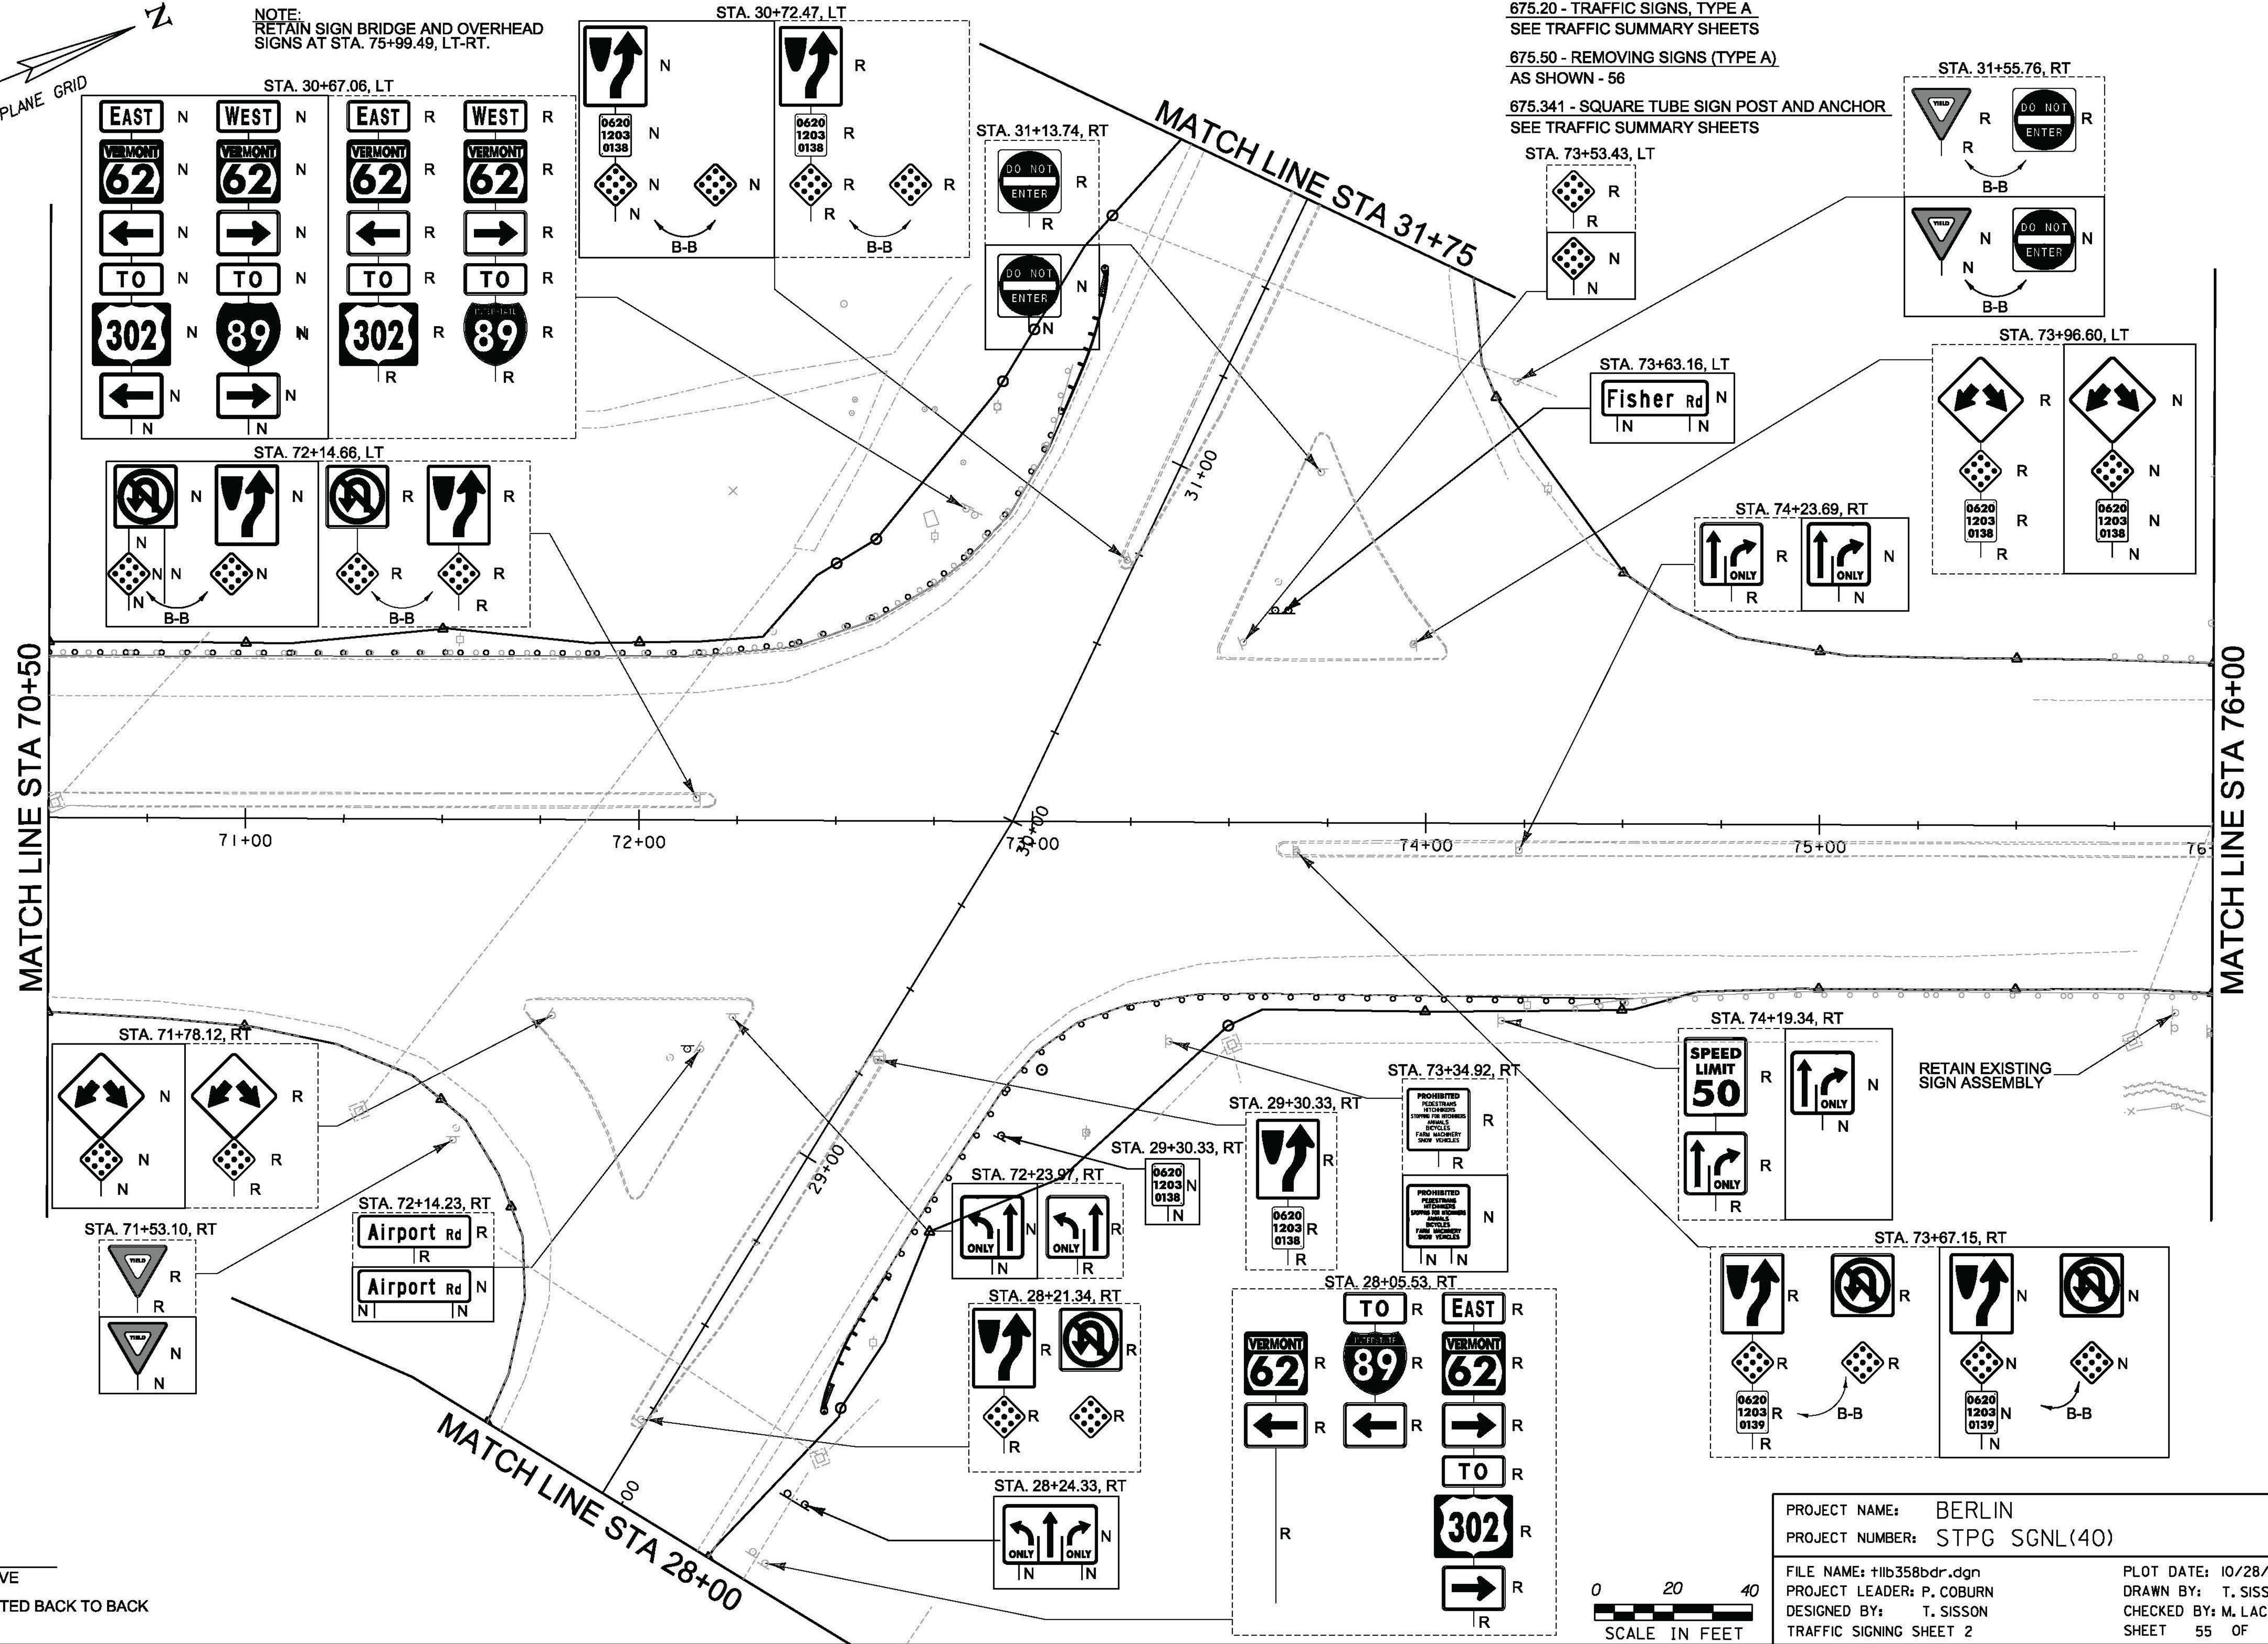


MATCH LINE STA 70+50

MATCH LINE STA 76+00

MATCH LINE STA 28+00

MATCH LINE STA 31+75

LEGEND  
R = REMOVE  
N = NEW  
B-B = MOUNTED BACK TO BACK

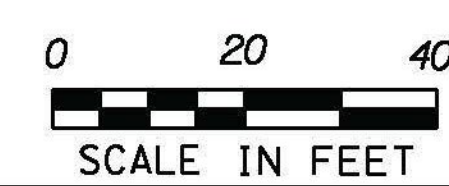

PROJECT NAME: BERLIN  
PROJECT NUMBER: STPG SGNL(40)  
FILE NAME: +lib358bdr.dgn  
PROJECT LEADER: P. COBURN  
DESIGNED BY: T. SISSON  
TRAFFIC SIGNING SHEET 2  
PLOT DATE: 10/28/2014  
DRAWN BY: T. SISSON  
CHECKED BY: M. LACROIX  
SHEET 55 OF 123