




675.20 - TRAFFIC SIGNS, TYPE A
 SEE TRAFFIC SUMMARY SHEETS
 675.50 - REMOVING SIGNS (TYPE A)
 AS SHOWN - 4
 675.341 - SQUARE TUBE SIGN POST AND ANCHOR
 SEE TRAFFIC SUMMARY SHEETS

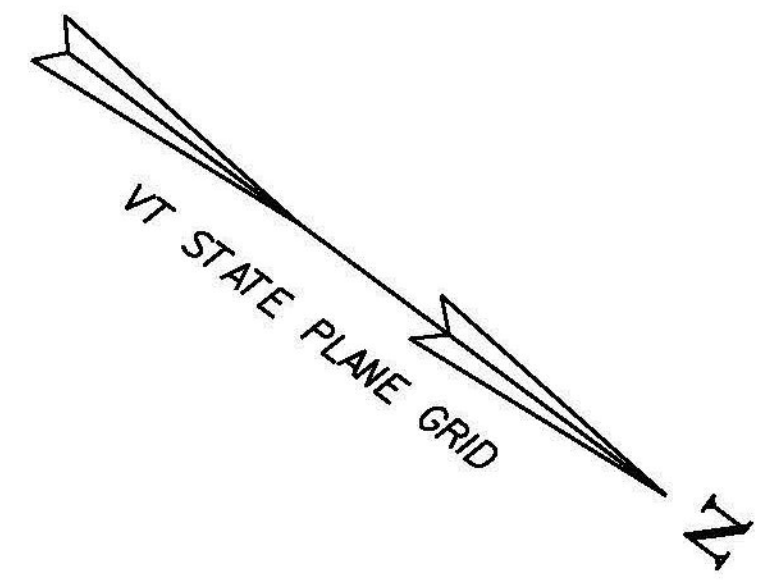

**LIMITS OF CONSTRUCTION
 STA. 24+99.43**

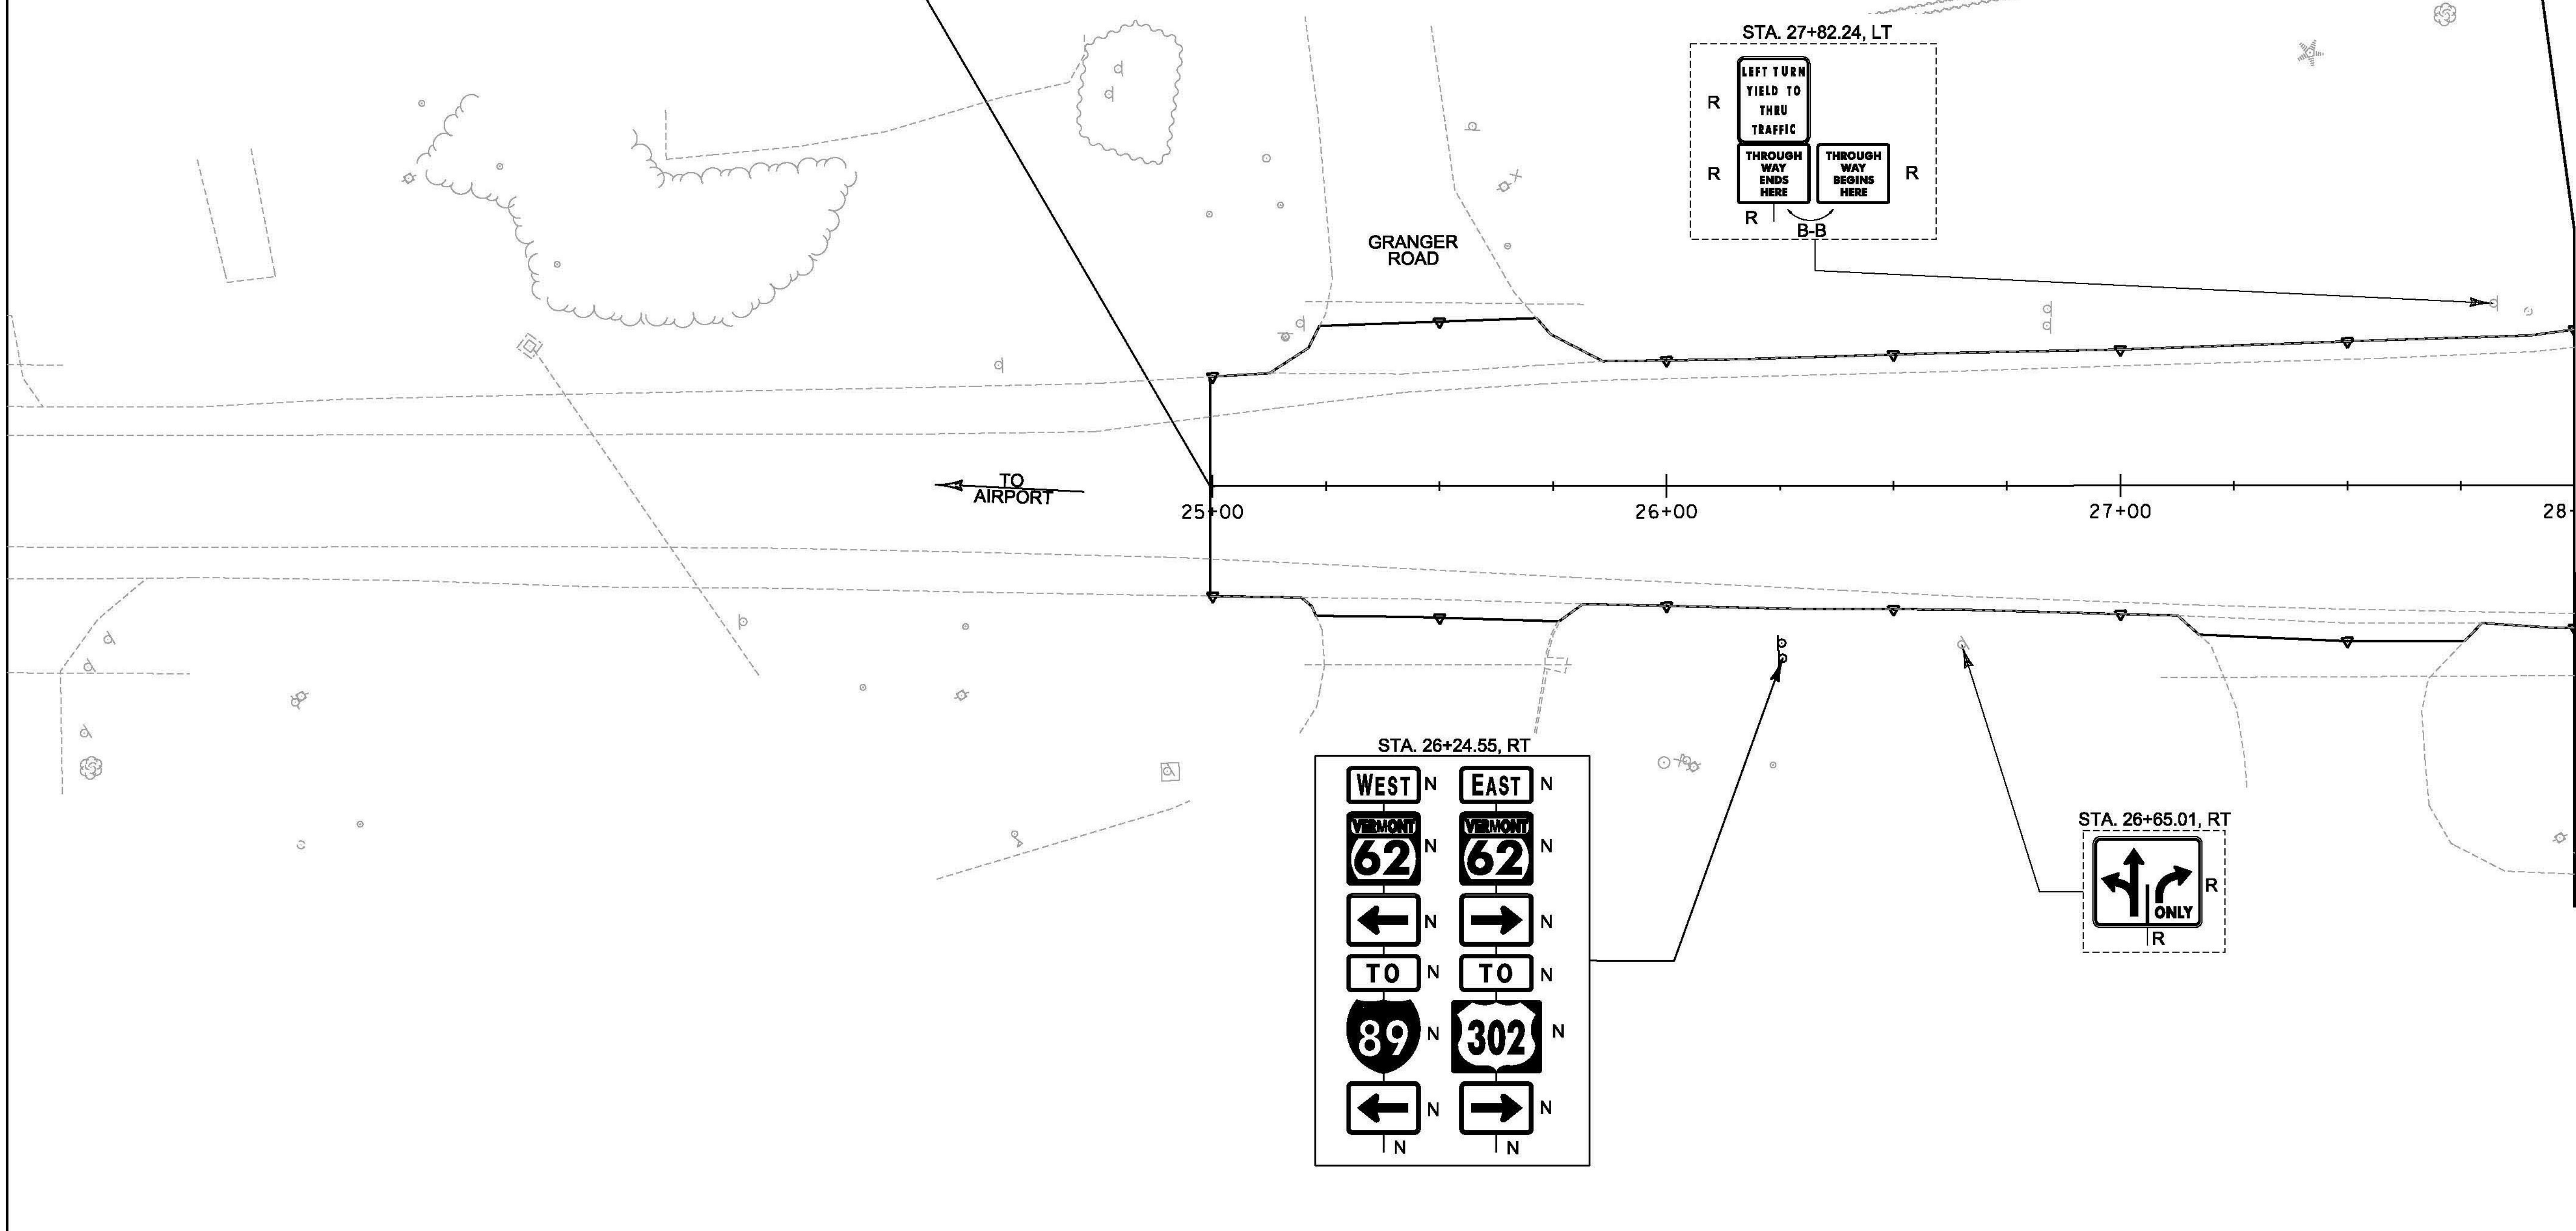

LEGEND
 R = REMOVE
 N = NEW
 B-B = MOUNTED BACK TO BACK

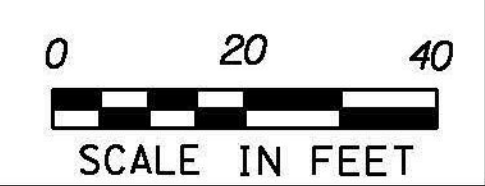

PROJECT NAME: BERLIN	PLOT DATE: 10/20/2014
PROJECT NUMBER: STPG SGNL(40)	DRAWN BY: T. SISSON
FILE NAME: +1ib358bdr.dgn	CHECKED BY: M. LACROIX
PROJECT LEADER: P. COBURN	SHEET 56 OF 123
DESIGNED BY: T. SISSON	
TRAFFIC SIGNING SHEET 3	