



675.20 - TRAFFIC SIGNS, TYPE A  
SEE TRAFFIC SUMMARY SHEETS  
675.50 - REMOVING SIGNS (TYPE A)  
AS SHOWN - 1  
675.341 - SQUARE TUBE SIGN POST AND ANCHOR  
SEE TRAFFIC SUMMARY SHEETS

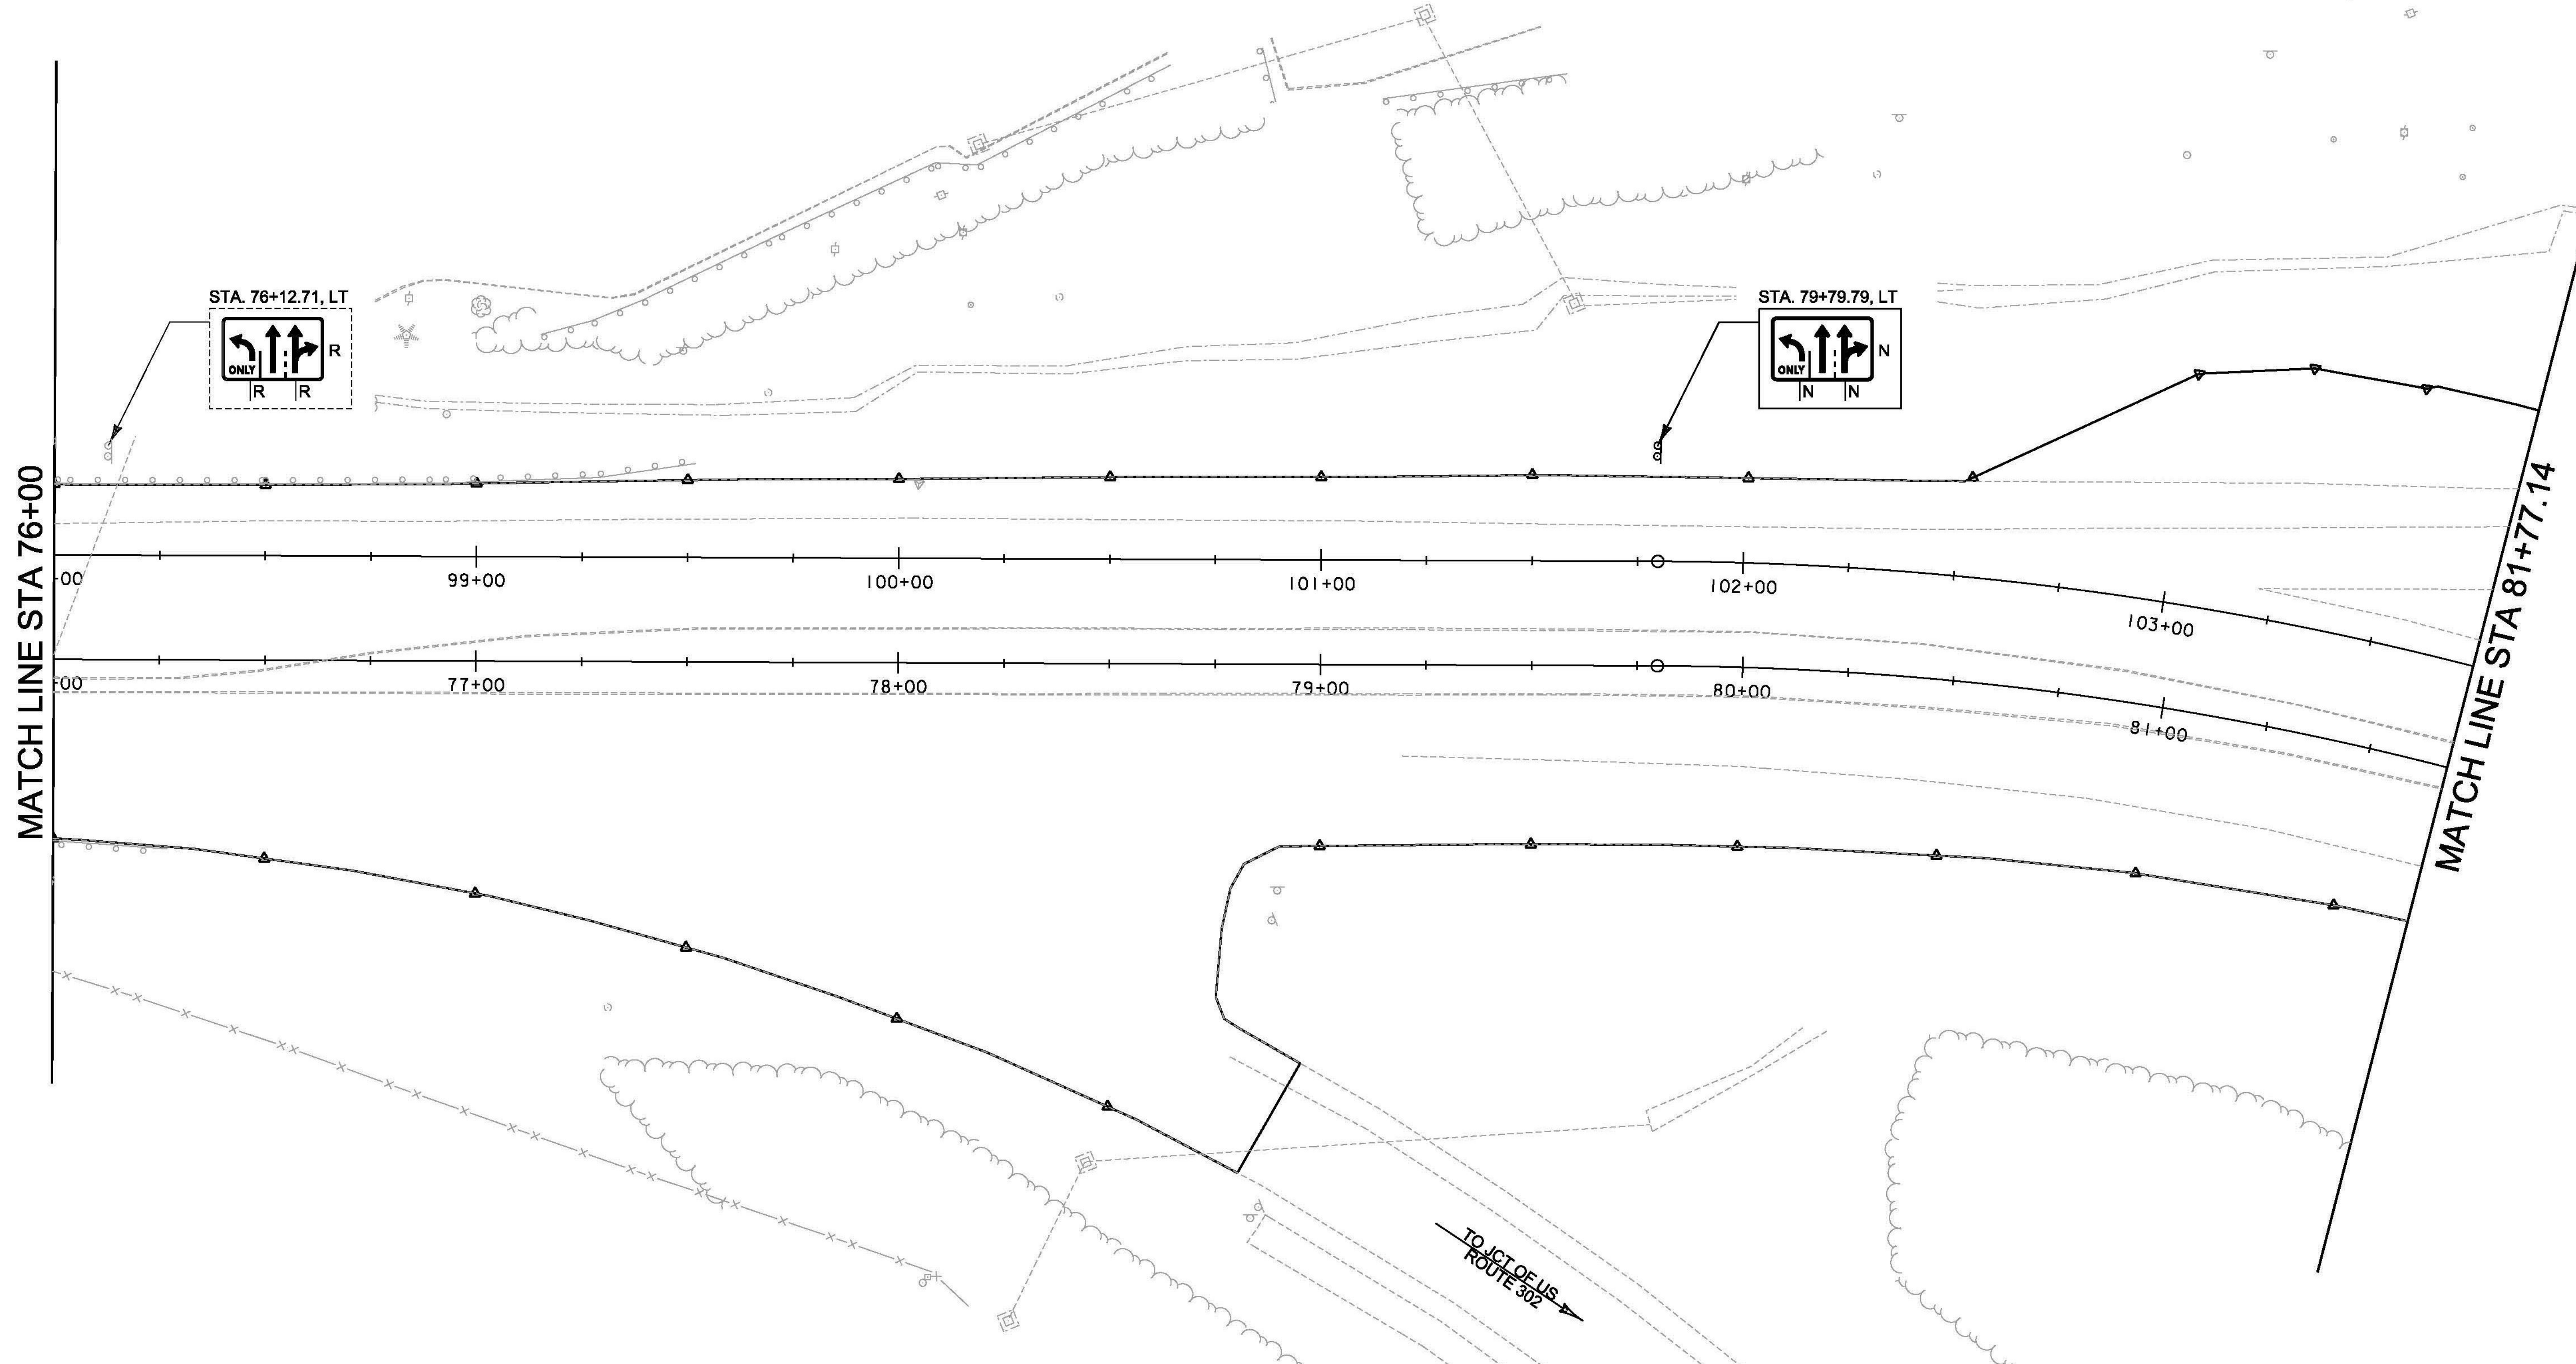

**LEGEND**  
 ZR = REMOVE  
 N = NEW  
 B-B = MOUNTED BACK TO BACK

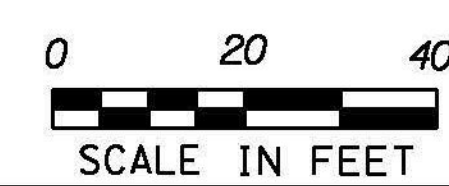

PROJECT NAME: BERLIN	PLOT DATE: 10/20/2014
PROJECT NUMBER: STPG SGNL(40)	DRAWN BY: T. SISSON
FILE NAME: +11b358bdr.dgn	CHECKED BY: M. LACROIX
PROJECT LEADER: P. COBURN	SHEET 58 OF 123
DESIGNED BY: T. SISSON	
TRAFFIC SIGNING SHEET 5	