


675.20 - TRAFFIC SIGNS, TYPE A
SEE TRAFFIC SUMMARY SHEETS

675.50 - REMOVING SIGNS (TYPE A)
AS SHOWN - 14 (12)

675.341 - SQUARE TUBE SIGN POST AND ANCHOR
SEE TRAFFIC SUMMARY SHEETS

676.10 - DELINEATOR WITH STEEL POST


| | |
|---------------------------|------|
| STA. 105+56.97, 15.83' LT | 1 EA |
| STA. 106+56.50, 18.83' LT | 1 EA |
| STA. 107+59.04, 20.15' LT | 1 EA |
| STA. 108+62.30, 20.58' LT | 1 EA |
| STA. 109+66.45, 20.14' LT | 1 EA |

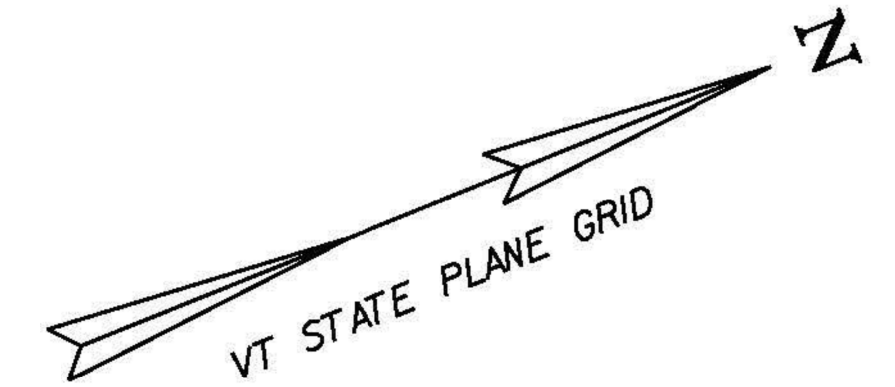

LIMITS OF CONSTRUCTION
STA. 109+68.33

| | |
|---------|---------|
| MM 1.56 | MM 1.61 |
| | |
| N | N |

REMOVED
PRIOR TO
PROJECT

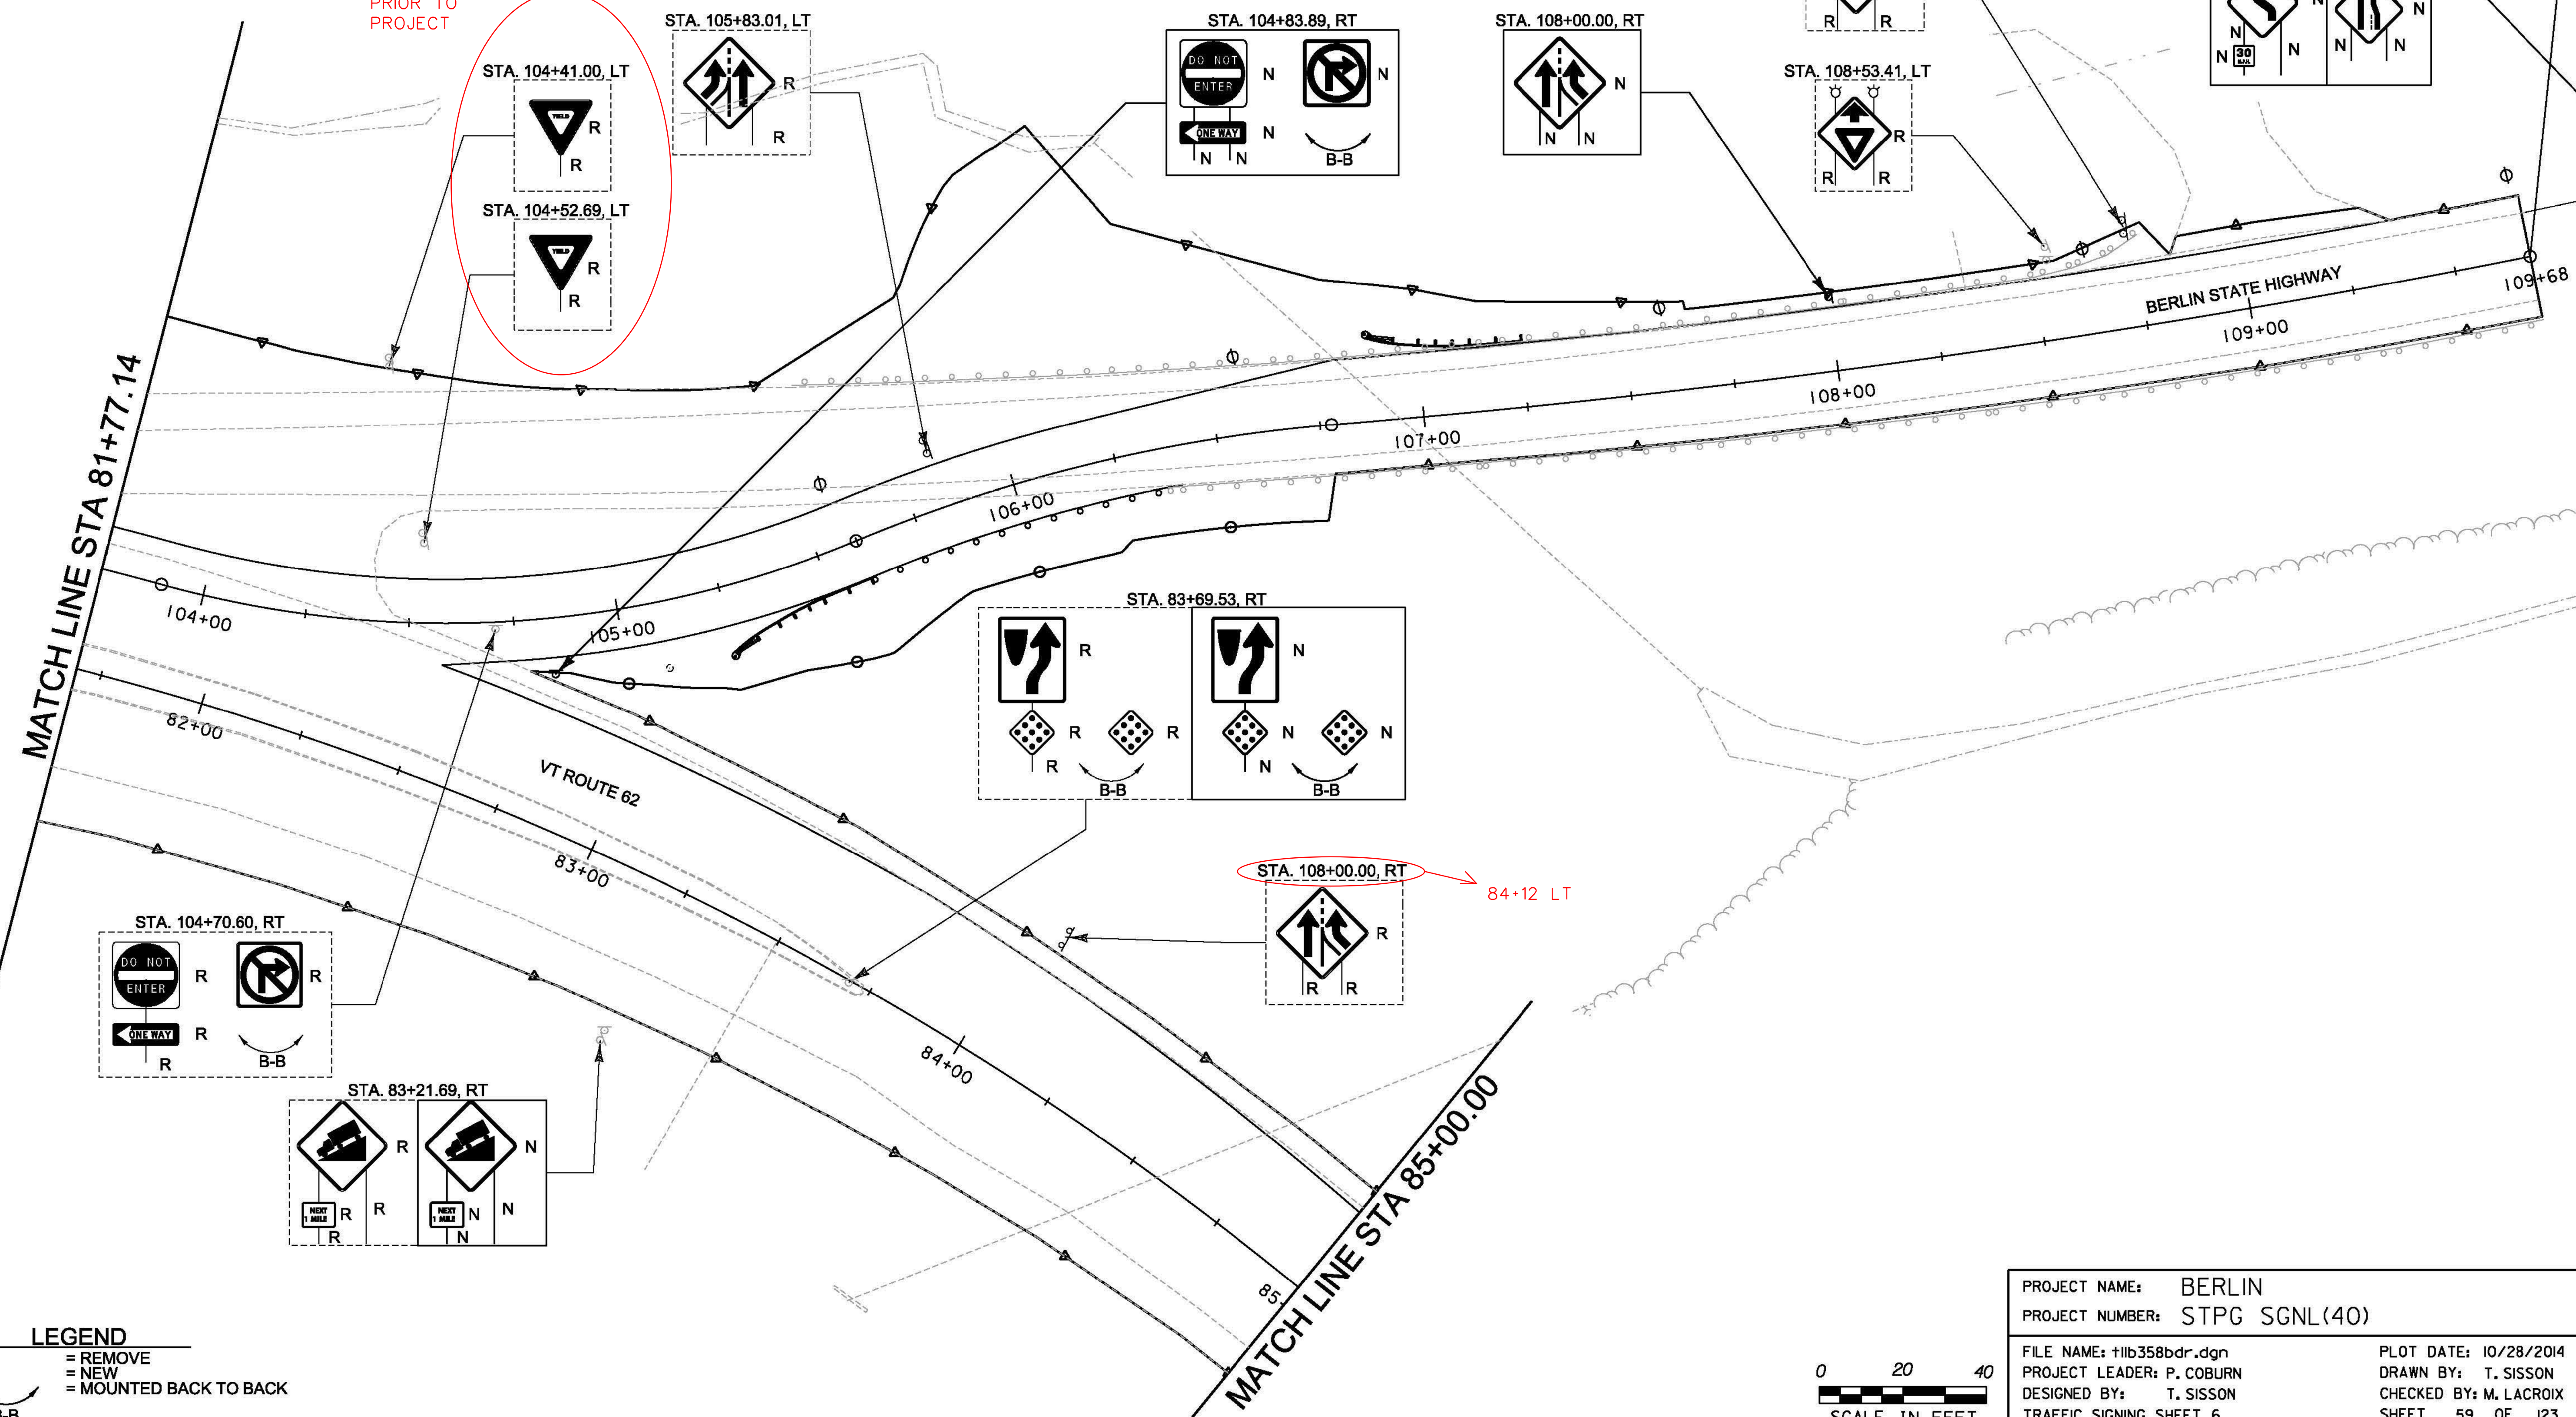

LEGEND

| | |
|--|------------------------|
| | = REMOVE |
| | = NEW |
| | = MOUNTED BACK TO BACK |

0 20 40
SCALE IN FEET

| | |
|-------------------------------|------------------------|
| PROJECT NAME: BERLIN | PLOT DATE: 10/28/2014 |
| PROJECT NUMBER: STPG SGNL(40) | DRAWN BY: T. SISSON |
| FILE NAME: t1b358bdr.dgn | CHECKED BY: M. LACROIX |
| DESIGNED BY: T. SISSON | SHEET 59 OF 123 |
| TRAFFIC SIGNING SHEET 6 | |