

675.20 - TRAFFIC SIGNS, TYPE A
SEE TRAFFIC SUMMARY SHEETS

675.50 - REMOVING SIGNS (TYPE A)
AS SHOWN - ~~X~~ ①

675.341 - SQUARE TUBE SIGN POST AND ANCHOR
SEE TRAFFIC SUMMARY SHEETS

MATCH LINE STA 96+50.00

97+00

98+00




99+00

100+00

101+00

102+00


TO BARRE

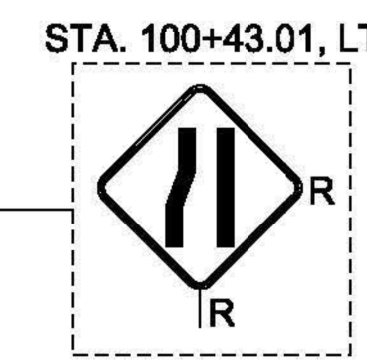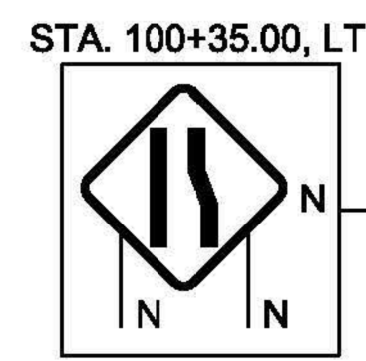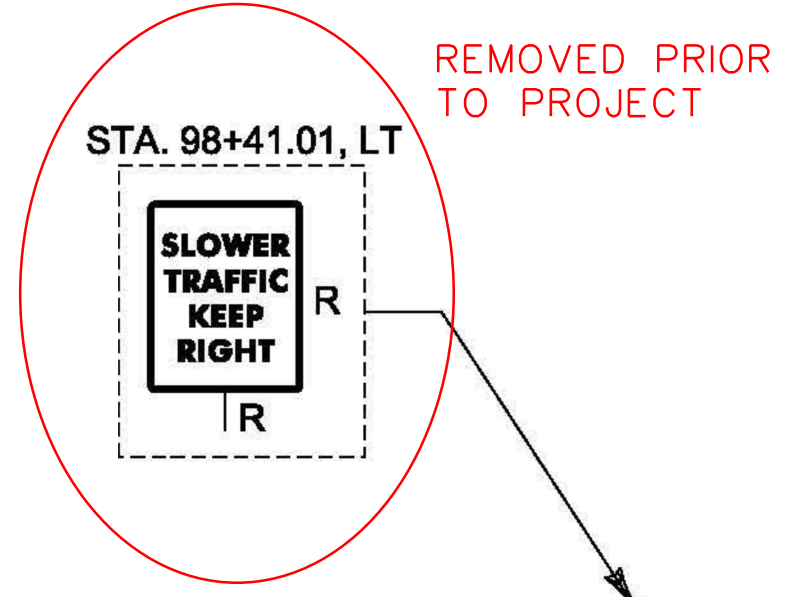

**END PROJECT
BERLIN STPG SGNL(40)
STA. 102+00.00**

LEGEND

~~R~~ = REMOVE
N = NEW
B-B = MOUNTED BACK TO BACK

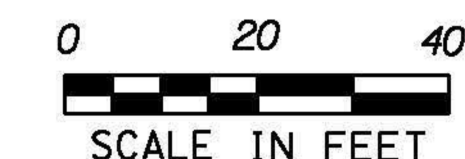

PROJECT NAME: BERLIN	PLOT DATE: 10/28/2014
PROJECT NUMBER: STPG SGNL(40)	DRAWN BY: T. SISSON
FILE NAME: +11b358bdr.dgn	CHECKED BY: M. LACROIX
PROJECT LEADER: P. COBURN	SHEET 62 OF 123
DESIGNED BY: T. SISSON	
TRAFFIC SIGNING SHEET 9	