

MATCH LINE STA 70+50

MATCH LINE STA 31+75


MATCH LINE STA 76+00

CABOT SILT LOAM  
3 TO 8 PERCENT SLOPES  
HYDROGROUP = D  
K FACTOR = 0.32

CABOT SILT LOAM  
8 TO 15 PERCENT SLOPES  
HYDROGROUP = D  
K FACTOR = 0.32

BUCKLAND SILT LOAM  
8 TO 15 PERCENT SLOPES  
HYDROGROUP = C  
K FACTOR = 0.32

MATCH LINE STA 28+00

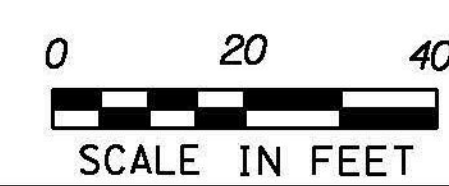

PROJECT NAME:	BERLIN	PLOT DATE:	10/20/2014
PROJECT NUMBER:	STPG SGNL(40)	DRAWN BY:	T. SISSON
FILE NAME:	+lib358bdr.dgn	CHECKED BY:	M. LACRIOX
PROJECT LEADER:	P. COBURN	SHEET	77 OF 123
DESIGNED BY:	T. SISSON	EPSC EXISTING CONDITIONS SHEET 2	