



N

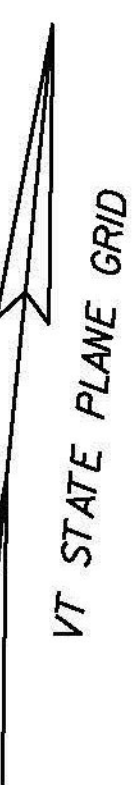


CABOT SILT LOAM
8 TO 15 PERCENT SLOPES, VERY STONY
HYDROGROUP = D
K FACTOR = 0.32

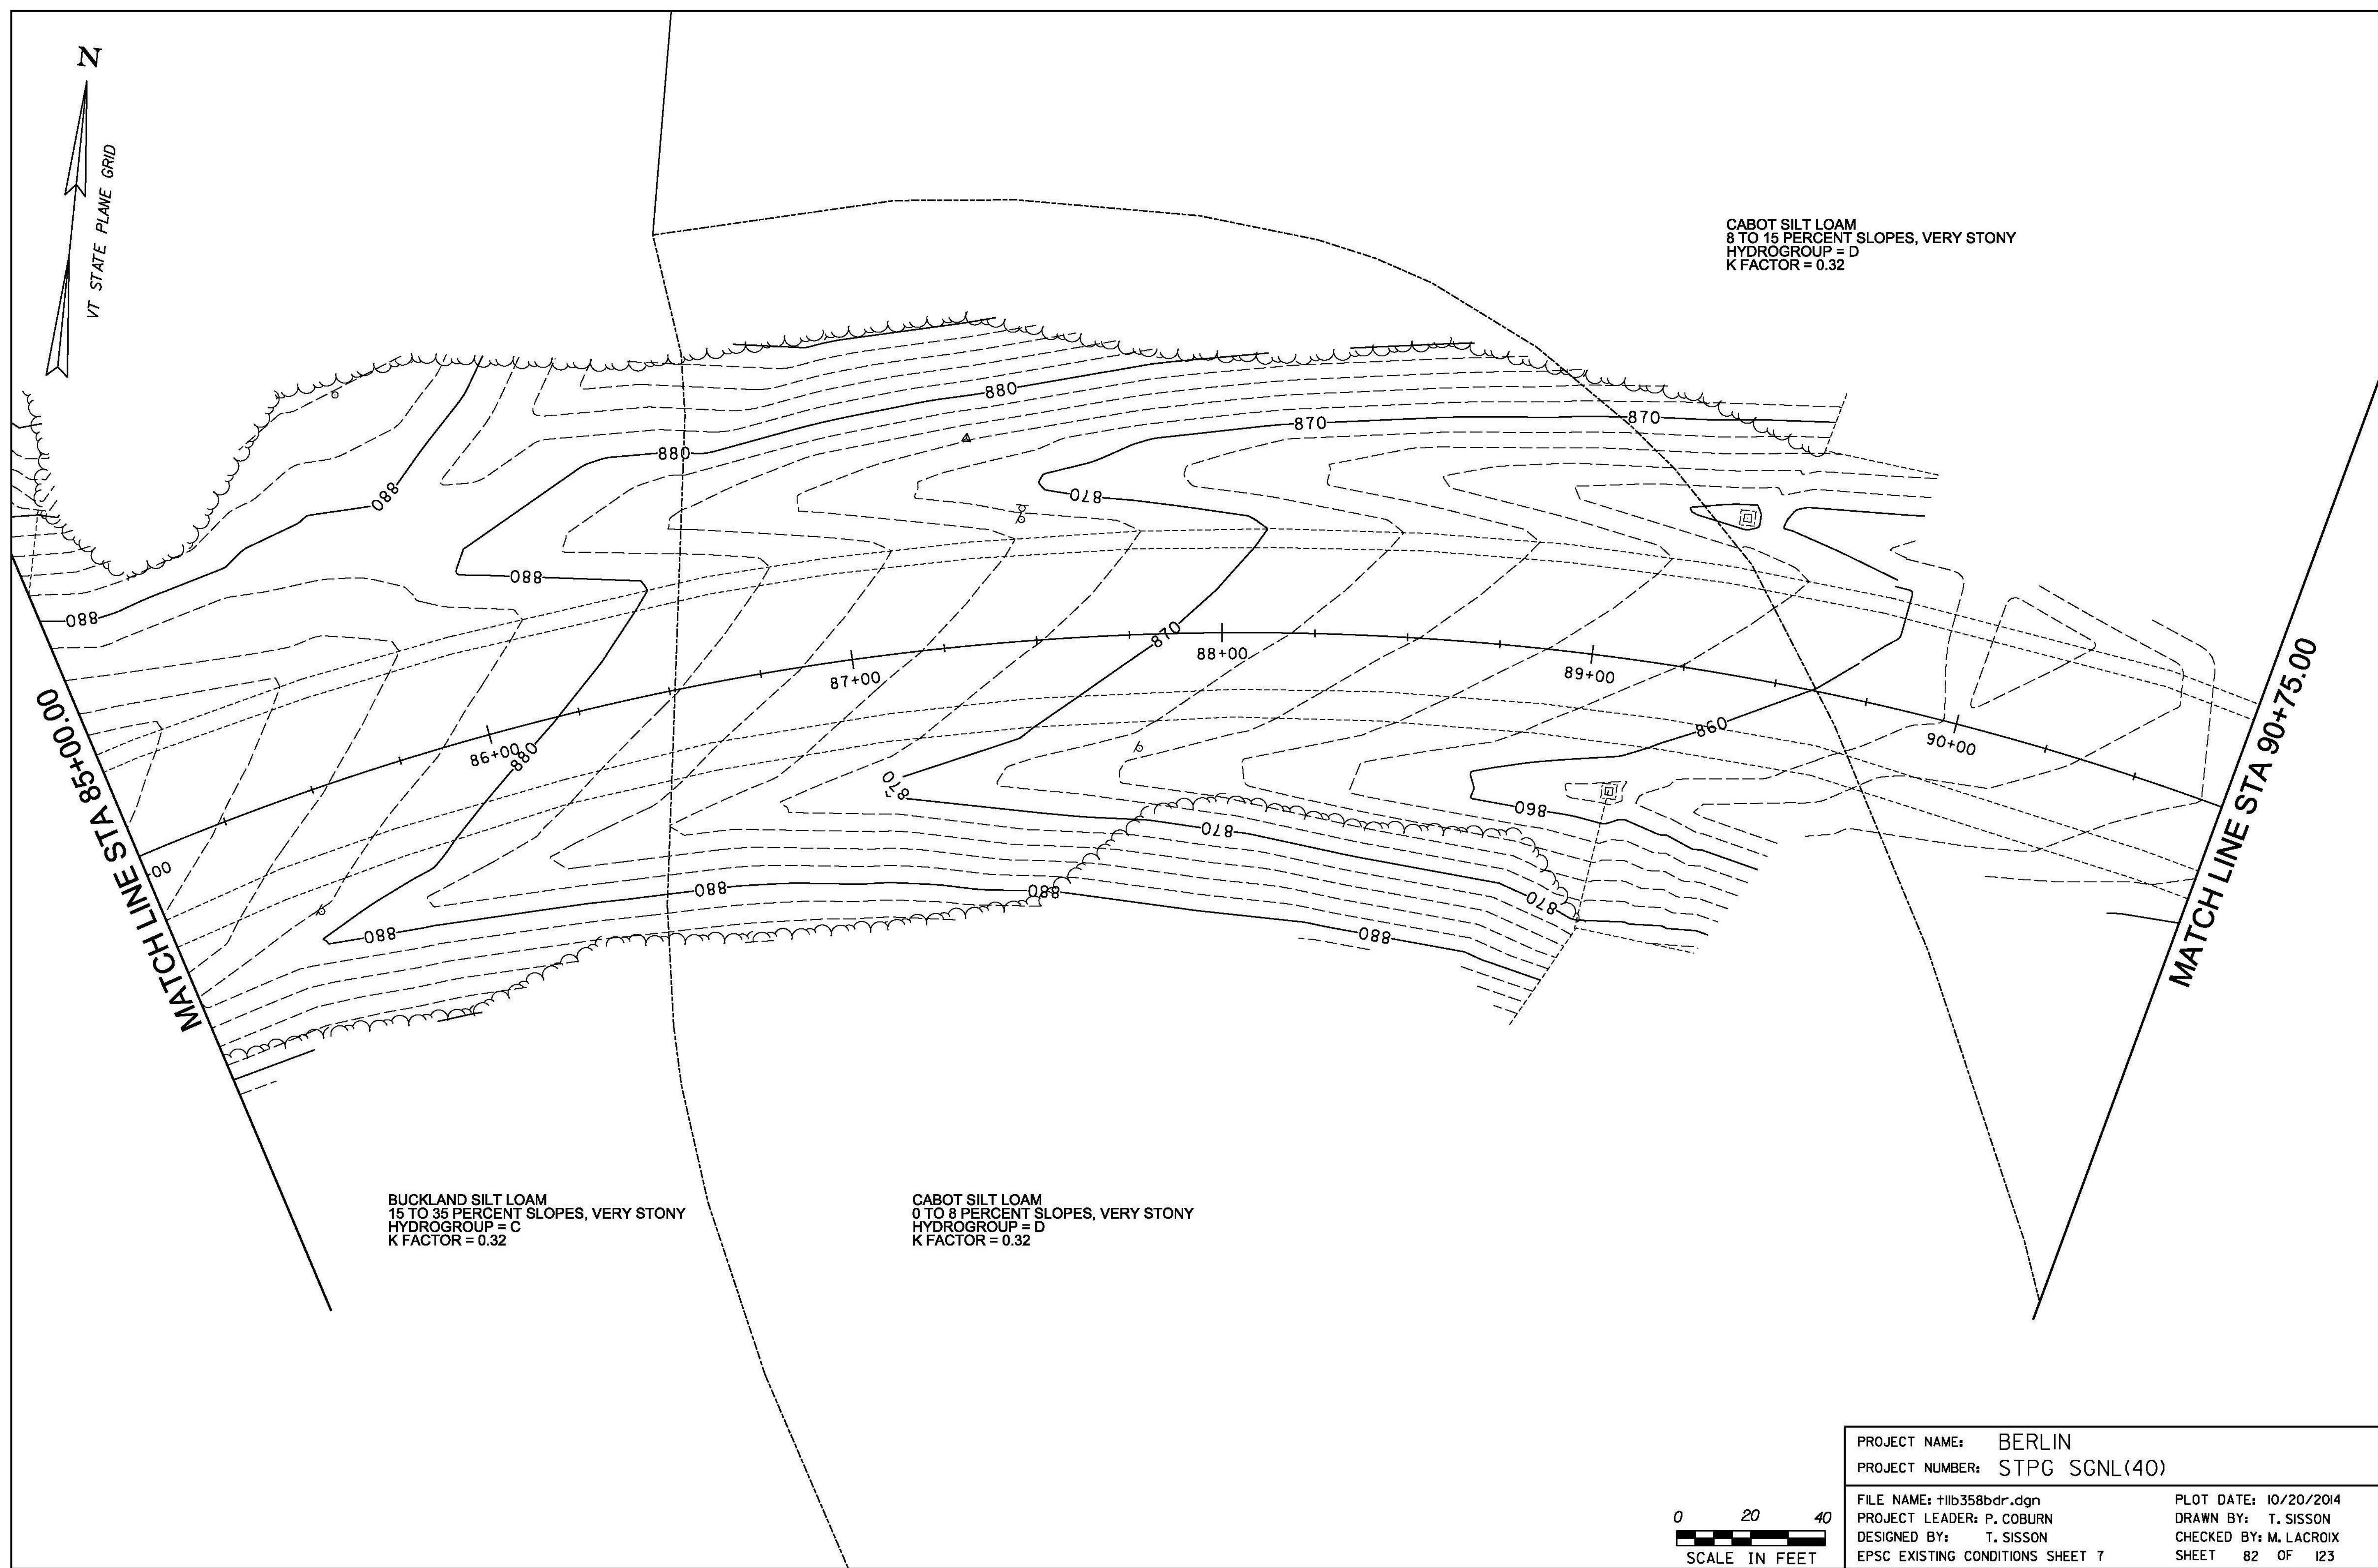

BUCKLAND SILT LOAM
15 TO 35 PERCENT SLOPES, VERY STONY
HYDROGROUP = C
K FACTOR = 0.32

CABOT SILT LOAM
0 TO 8 PERCENT SLOPES, VERY STONY
HYDROGROUP = D
K FACTOR = 0.32

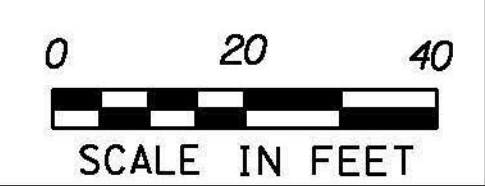

PROJECT NAME:	BERLIN	PLOT DATE:	10/20/2014
PROJECT NUMBER:	STPG SGNL(40)	DRAWN BY:	T. SISSON
FILE NAME:	+11b358bdr.dgn	CHECKED BY:	M. LACROIX
PROJECT LEADER:	P. COBURN	SHEET	82 OF 123
DESIGNED BY:	T. SISSON	EPSC EXISTING CONDITIONS SHEET	7