

653.25 - TEMPORARY STONE CHECK DAM, TYPE I
 STA. 103+75.00, LT. - STA. 105+90.00, LT.

653.40 - INLET PROTECTION DEVICE, TYPE I
 STA. 83+49.48, LT.
 STA. 106+34.95, LT.
 STA. 108+32.97, LT.

653.55 - PROJECT DEMARCATION FENCE
 STA. 103+75.00, LT. - 108+82.14, LT.
 STA. 105+36.08, RT. - 106+92.24, RT.

649.51 - GEOTEXTILE FOR SILT FENCE
 STA. 104+95.86, RT. - STA. 106+47.96, RT.


653.20 - TEMPORARY EROSION MATTING
 STA. 104+84.60, RT. - STA. 106+77.71, RT.
 STA. 103+75.00, LT. - STA. 108+83.04, LT.

BUCKLAND SILT LOAM
 15 TO 25 PERCENT SLOPES
 HYDROGROUP = C
 K FACTOR = 0.32

LIMITS OF CONSTRUCTION
 STA. 109+68.33

MATCH LINE STA 81+77.14


MATCH LINE STA 85+00.00

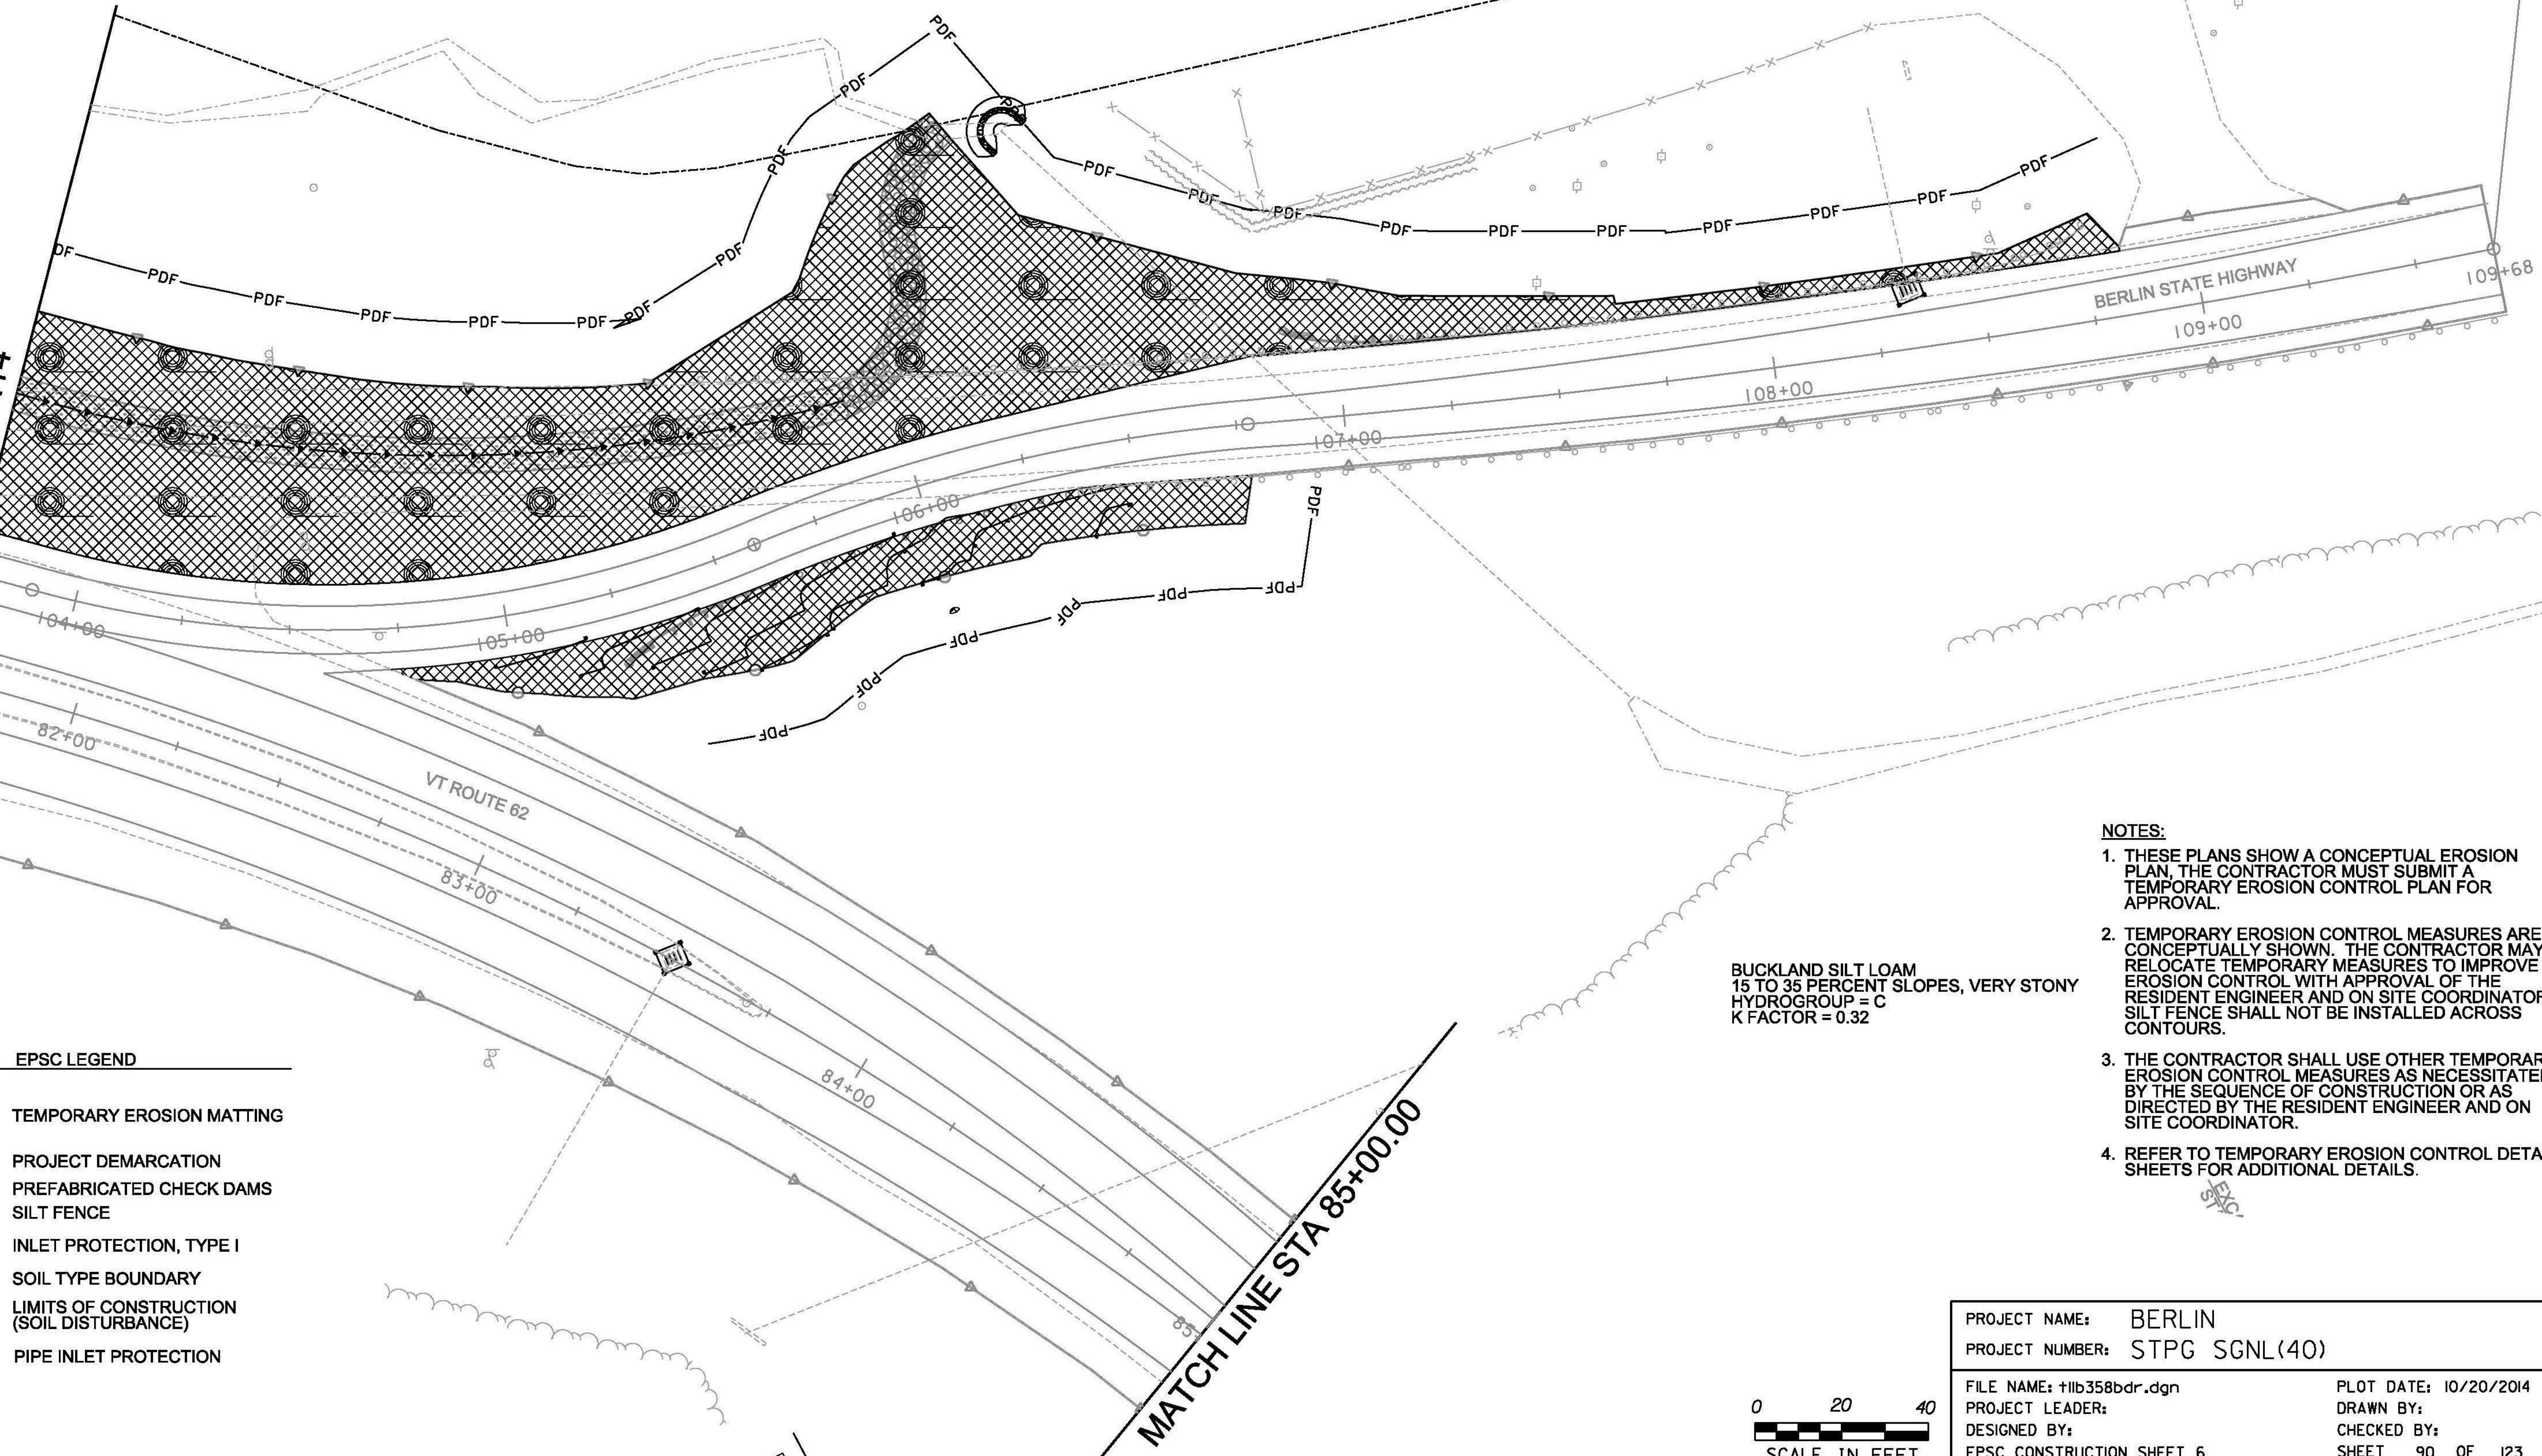

- EPSC LEGEND**
- TEMPORARY EROSION MATTING
 - PROJECT DEMARCATION
 - PREFABRICATED CHECK DAMS
 - SILT FENCE
 - INLET PROTECTION, TYPE I
 - SOIL TYPE BOUNDARY
 - LIMITS OF CONSTRUCTION (SOIL DISTURBANCE)
 - PIPE INLET PROTECTION

BUCKLAND SILT LOAM
 15 TO 35 PERCENT SLOPES, VERY STONY
 HYDROGROUP = C
 K FACTOR = 0.32

- NOTES:**
1. THESE PLANS SHOW A CONCEPTUAL EROSION PLAN, THE CONTRACTOR MUST SUBMIT A TEMPORARY EROSION CONTROL PLAN FOR APPROVAL.
 2. TEMPORARY EROSION CONTROL MEASURES ARE CONCEPTUALLY SHOWN. THE CONTRACTOR MAY RELOCATE TEMPORARY MEASURES TO IMPROVE EROSION CONTROL WITH APPROVAL OF THE RESIDENT ENGINEER AND ON SITE COORDINATOR. SILT FENCE SHALL NOT BE INSTALLED ACROSS CONTOURS.
 3. THE CONTRACTOR SHALL USE OTHER TEMPORARY EROSION CONTROL MEASURES AS NECESSITATED BY THE SEQUENCE OF CONSTRUCTION OR AS DIRECTED BY THE RESIDENT ENGINEER AND ON SITE COORDINATOR.
 4. REFER TO TEMPORARY EROSION CONTROL DETAIL SHEETS FOR ADDITIONAL DETAILS.

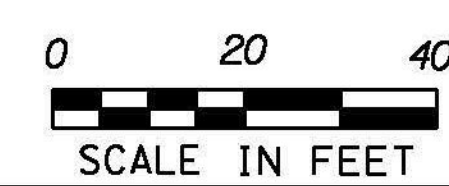

PROJECT NAME:	BERLIN	FILE NAME:	+lib358bdr.dgn	PLOT DATE:	10/20/2014
PROJECT NUMBER:	STPG SGNL(40)	PROJECT LEADER:		DRAWN BY:	
		DESIGNED BY:		CHECKED BY:	
		EPSC CONSTRUCTION SHEET 6		SHEET 90 OF 123	