


**BEGIN PROJECT
BERLIN STPG SGNL (40)
STA. 65+92.66**

VT ROUTE 62
TO BERLIN CORNERS

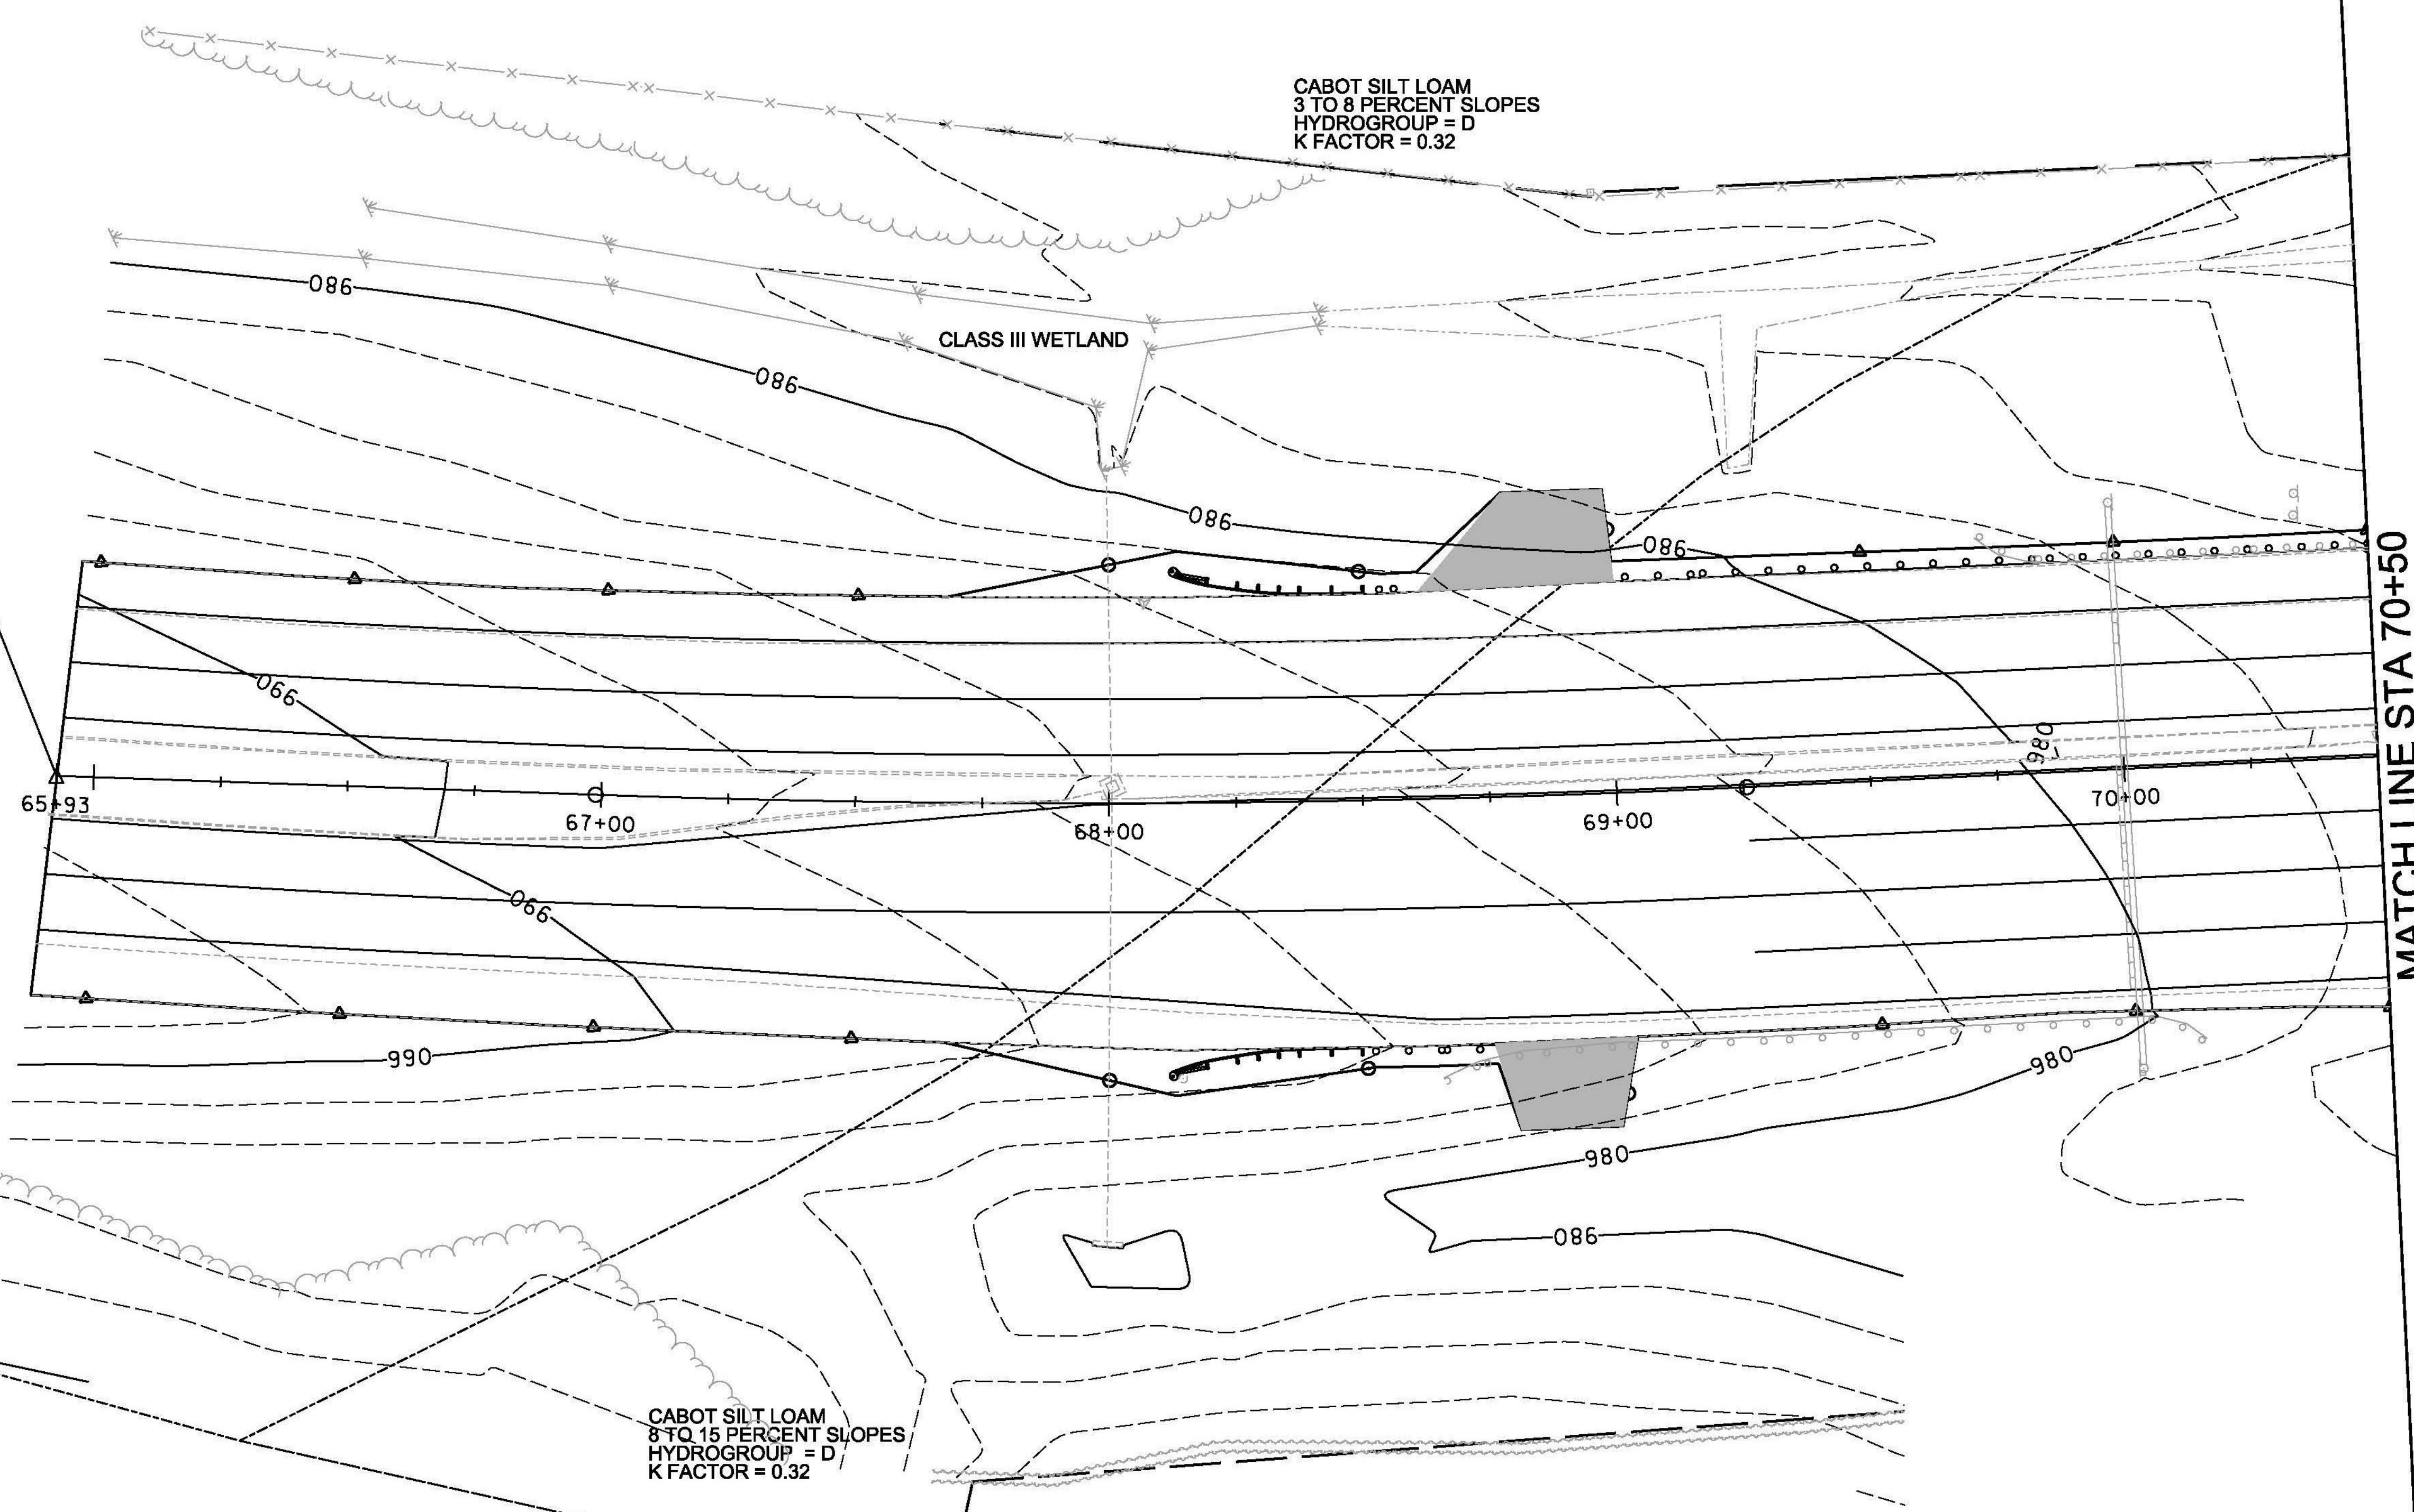

MATCH LINE STA 70+50


CABOT SILT LOAM
3 TO 8 PERCENT SLOPES
HYDROGROUP = D
K FACTOR = 0.32

CLASS III WETLAND

CABOT SILT LOAM
8 TO 15 PERCENT SLOPES
HYDROGROUP = D
K FACTOR = 0.32

EPSC LEGEND

	LIMITS OF SOIL DISTURBANCE
	DISTURBED AREAS REQUIRING RE-VEGETATION

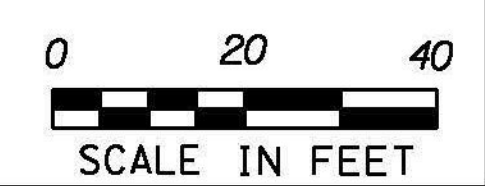

PROJECT NAME: BERLIN	PLOT DATE: 10/28/2014
PROJECT NUMBER: STPG SGNL(40)	DRAWN BY: T. SISSON
FILE NAME: +11b358bdr.dgn	CHECKED BY: M. LACROIX
PROJECT LEADER: P. COBURN	SHEET 94 OF 123
DESIGNED BY: T. SISSON	
EPSC FINAL CONDITIONS SHEET 1	