

**LIMITS OF CONSTRUCTION  
STA. 24+99.43**

STETSON LOAM  
8 TO 15 PERCENT SLOPES  
HYDROGROUP = D  
K FACTOR = 0.17

GRANGER ROAD

TO AIRPORT

PAVED DRIVE


CABOT SILT LOAM  
0 TO 8 PERCENT SLOPES, VERY STONY  
HYDROGROUP = D  
K FACTOR = 0.32

CABOT SILT LOAM  
8 TO 15 PERCENT SLOPES  
HYDROGROUP = D  
K FACTOR = 0.32

MATCH LINE STA 28+00

EPSC LEGEND

- ▲—○— LIMITS OF SOIL DISTURBANCE
- ▒ DISTURBED AREAS
- ▒ REQUIRING RE-VEGETATION

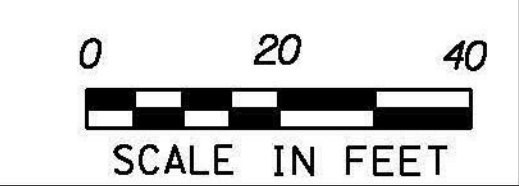

PROJECT NAME: BERLIN	PLOT DATE: 10/20/2014
PROJECT NUMBER: STPG SGNL(40)	DRAWN BY: T. SISSON
FILE NAME: +lib358bdr.dgn	CHECKED BY: M. LACROIX
PROJECT LEADER: P. COBURN	SHEET 96 OF 123
DESIGNED BY: T. SISSON	
EPSC FINAL CONDITIONS SHEET 3	